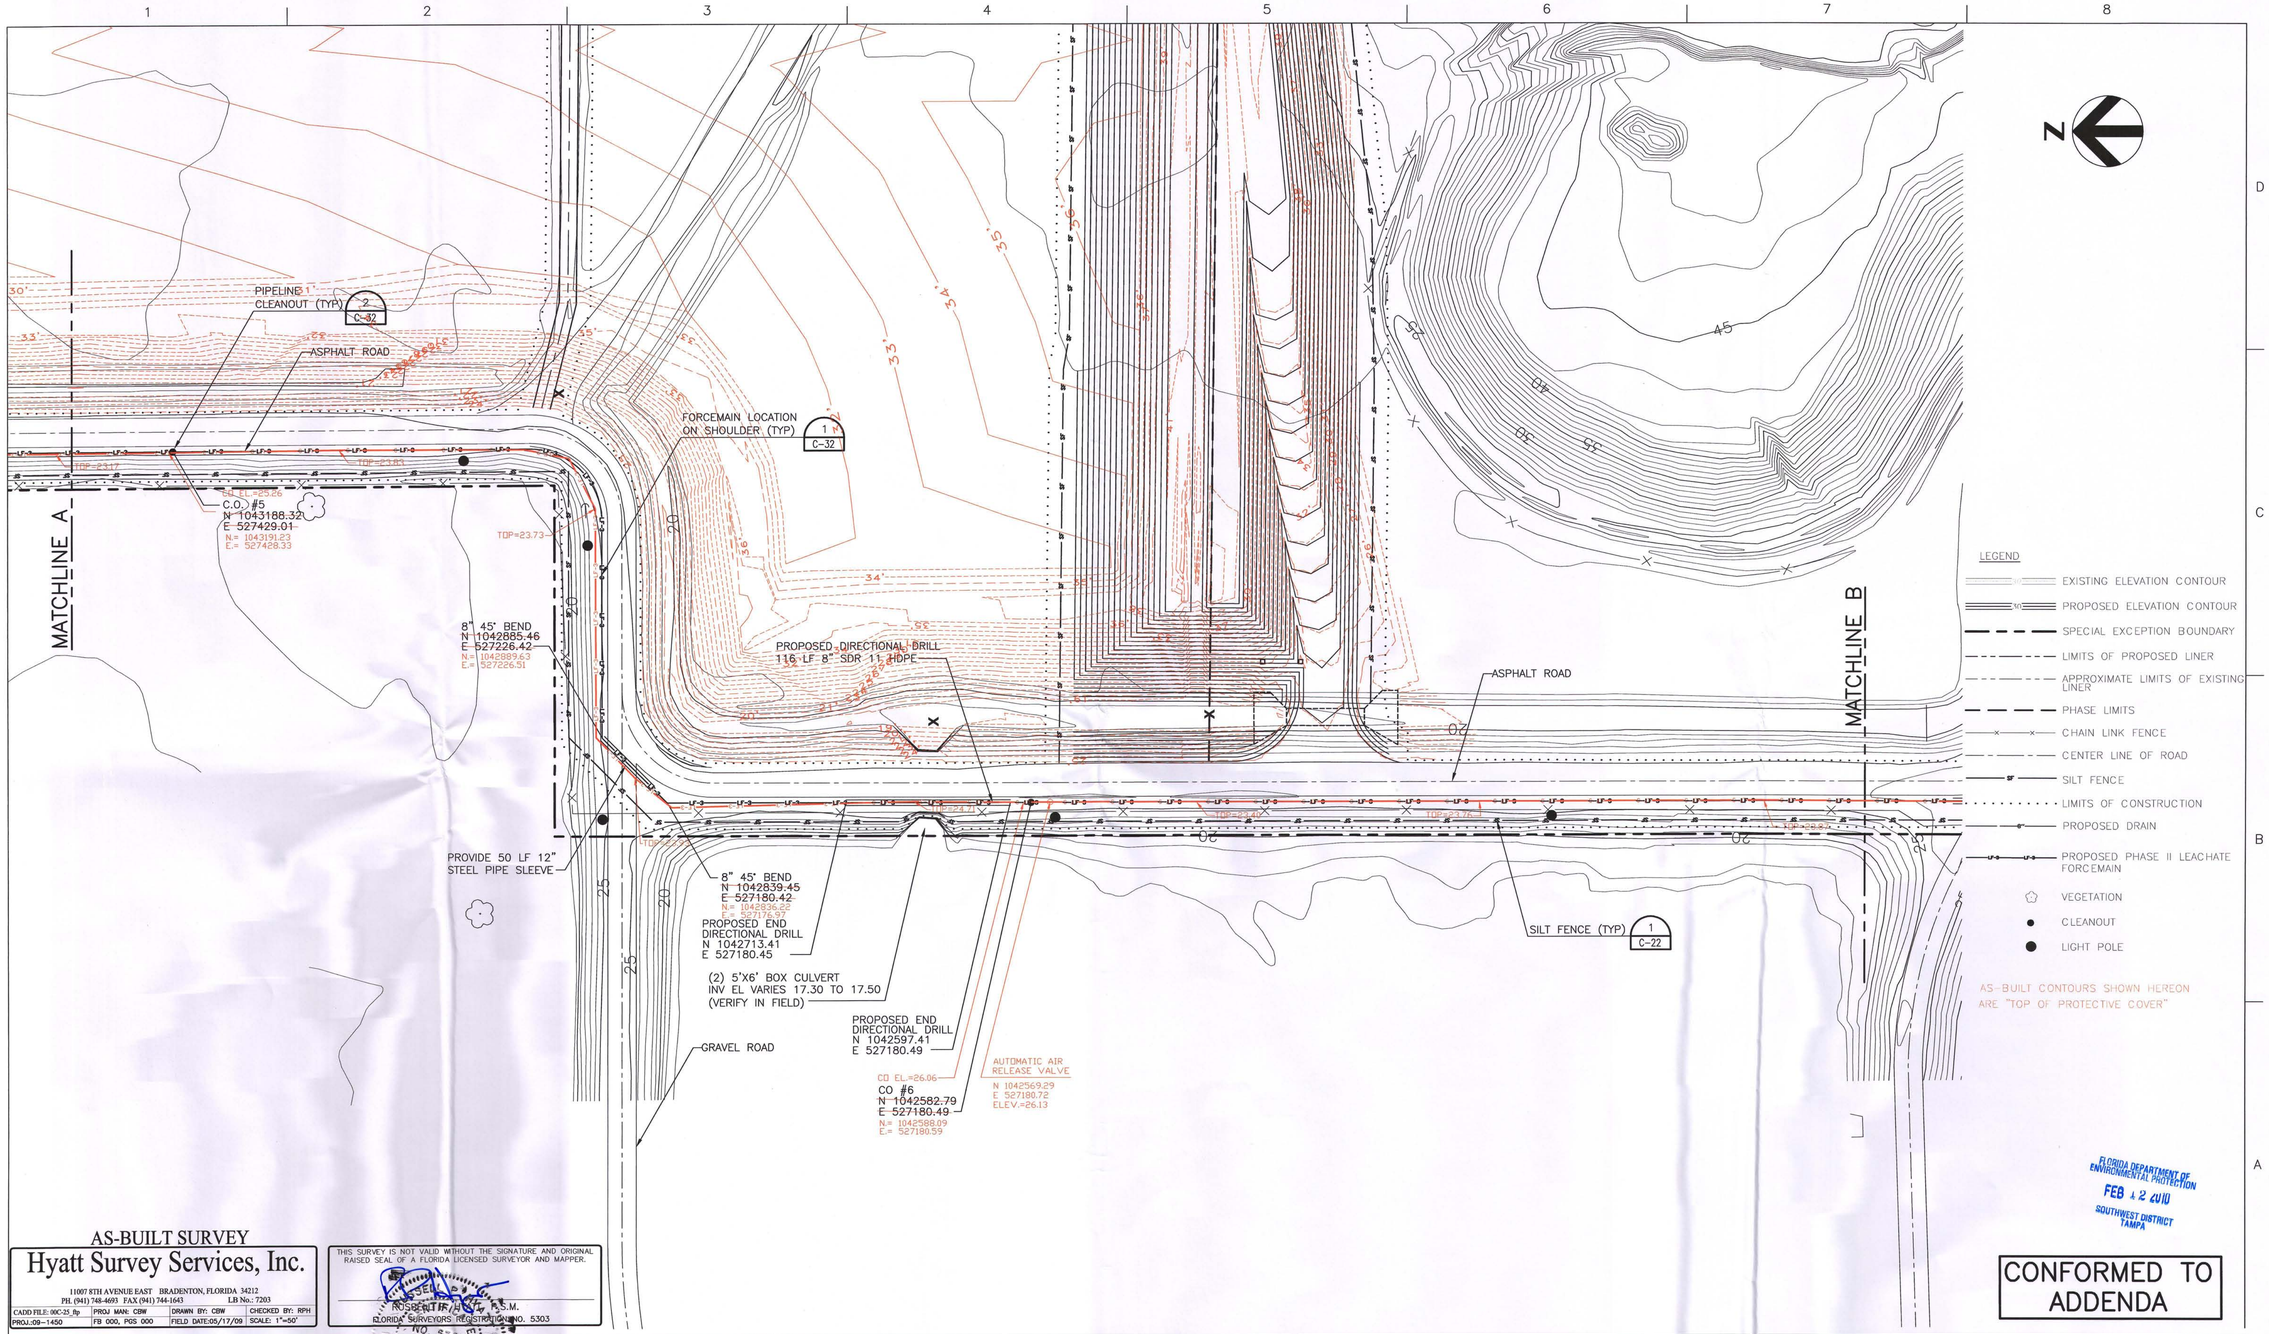


AS-BUILT SURVEY

Hyatt Survey Services, Inc.

11007 8TH AVENUE EAST BRADENTON, FLORIDA 34212
PH. (941) 748-4693 FAX (941) 744-1643 LB No.: 7203

CADD FILE: 00C-25 .flp	PROJ MAN: CBW	DRAWN BY: CBW	CHECKED BY: RPH
PROJ.:09-1450	FB 000, PGS 000	FIELD DATE:05/17/09	SCALE: 1"=50'

THIS SURVEY IS NOT VALID WITHOUT THE SIGNATURE AND ORIGINAL RAISED SEAL OF A FLORIDA LICENSED SURVEYOR AND MAPPER.

ROBERT P. HYATT, P.S.M.
FLORIDA SURVEYORS REGISTRATION NO. 5303

FLORIDA DEPARTMENT OF ENVIRONMENTAL PROTECTION
FEB 12 2010
SOUTHWEST DISTRICT TAMPA

CONFORMED TO ADDENDA

HDR

HDR Engineering, Inc.
5426 Bay Center Drive, Suite 400
Tampa, FL 33609-3444
(813) 282-2300
Florida Certificate of Authorization
No. 00004213

ISSUE	DATE	DESCRIPTION
A	02/2009	ISSUED FOR CONSTRUCTION, CONFORMED TO ADDENDA

PROJECT MANAGER	T.M. YANOSCHAK
REVIEWED BY	J.C. READLING
DRAWN BY	G.J. BLUE
PROJECT NUMBER	001916-43485-018

Thomas M. Yanoschak, P.E.
Certificate No. 44200

SARASOTA COUNTY

Central County Solid Waste Disposal Complex
PHASE II CLASS I LANDFILL EXPANSION
CONSTRUCTION DRAWINGS

SARASOTA COUNTY FLORIDA

FORCEMAIN PLAN

0 1" 2"

FILENAME	00C-25.dwg
SCALE	1"=50'

SHEET C-25