


THE DATA SHOWN ON THIS SHEET RECORD DRAWING IS FOR INFORMATION PURPOSES ONLY, AND WAS NOT DESIGNED BY BROADWAY ENGINEERING, P.A.

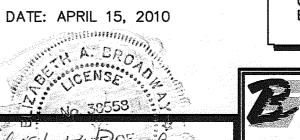

PROFESSIONAL ENGINEER

FLORIDA REGISTRATION NO. 38558

BROADWAY ENGINEERING, P.A CIVIL, MECHANICAL, STRUCTURAL AND BUILDING DESIGN See Us At www.Broadway-Eng.Com 1335 W. Cass Street Tampa, Fiorida 33606 813-251-9244

Certificate of Authorization No. 4599

SCALE: Fax 813-251-9330 Bus. Email: Info@Broadway-Eng.Com Cadd. Email: DGorr@Broadway-Eng.Com

ENGINEERS CONRAD AND SCHMIDT CADD FILE: BE - 3531 - S - 9DATE: JULY 2008 N.T.S. DRAWING NO.

HILLSBOROUGH C SOLID WAS MANAGEMENT DEP TAMPA, FLOR

BUILDINGS 10VAL -2

BLOWER/STORAGE PRODUCT APPR