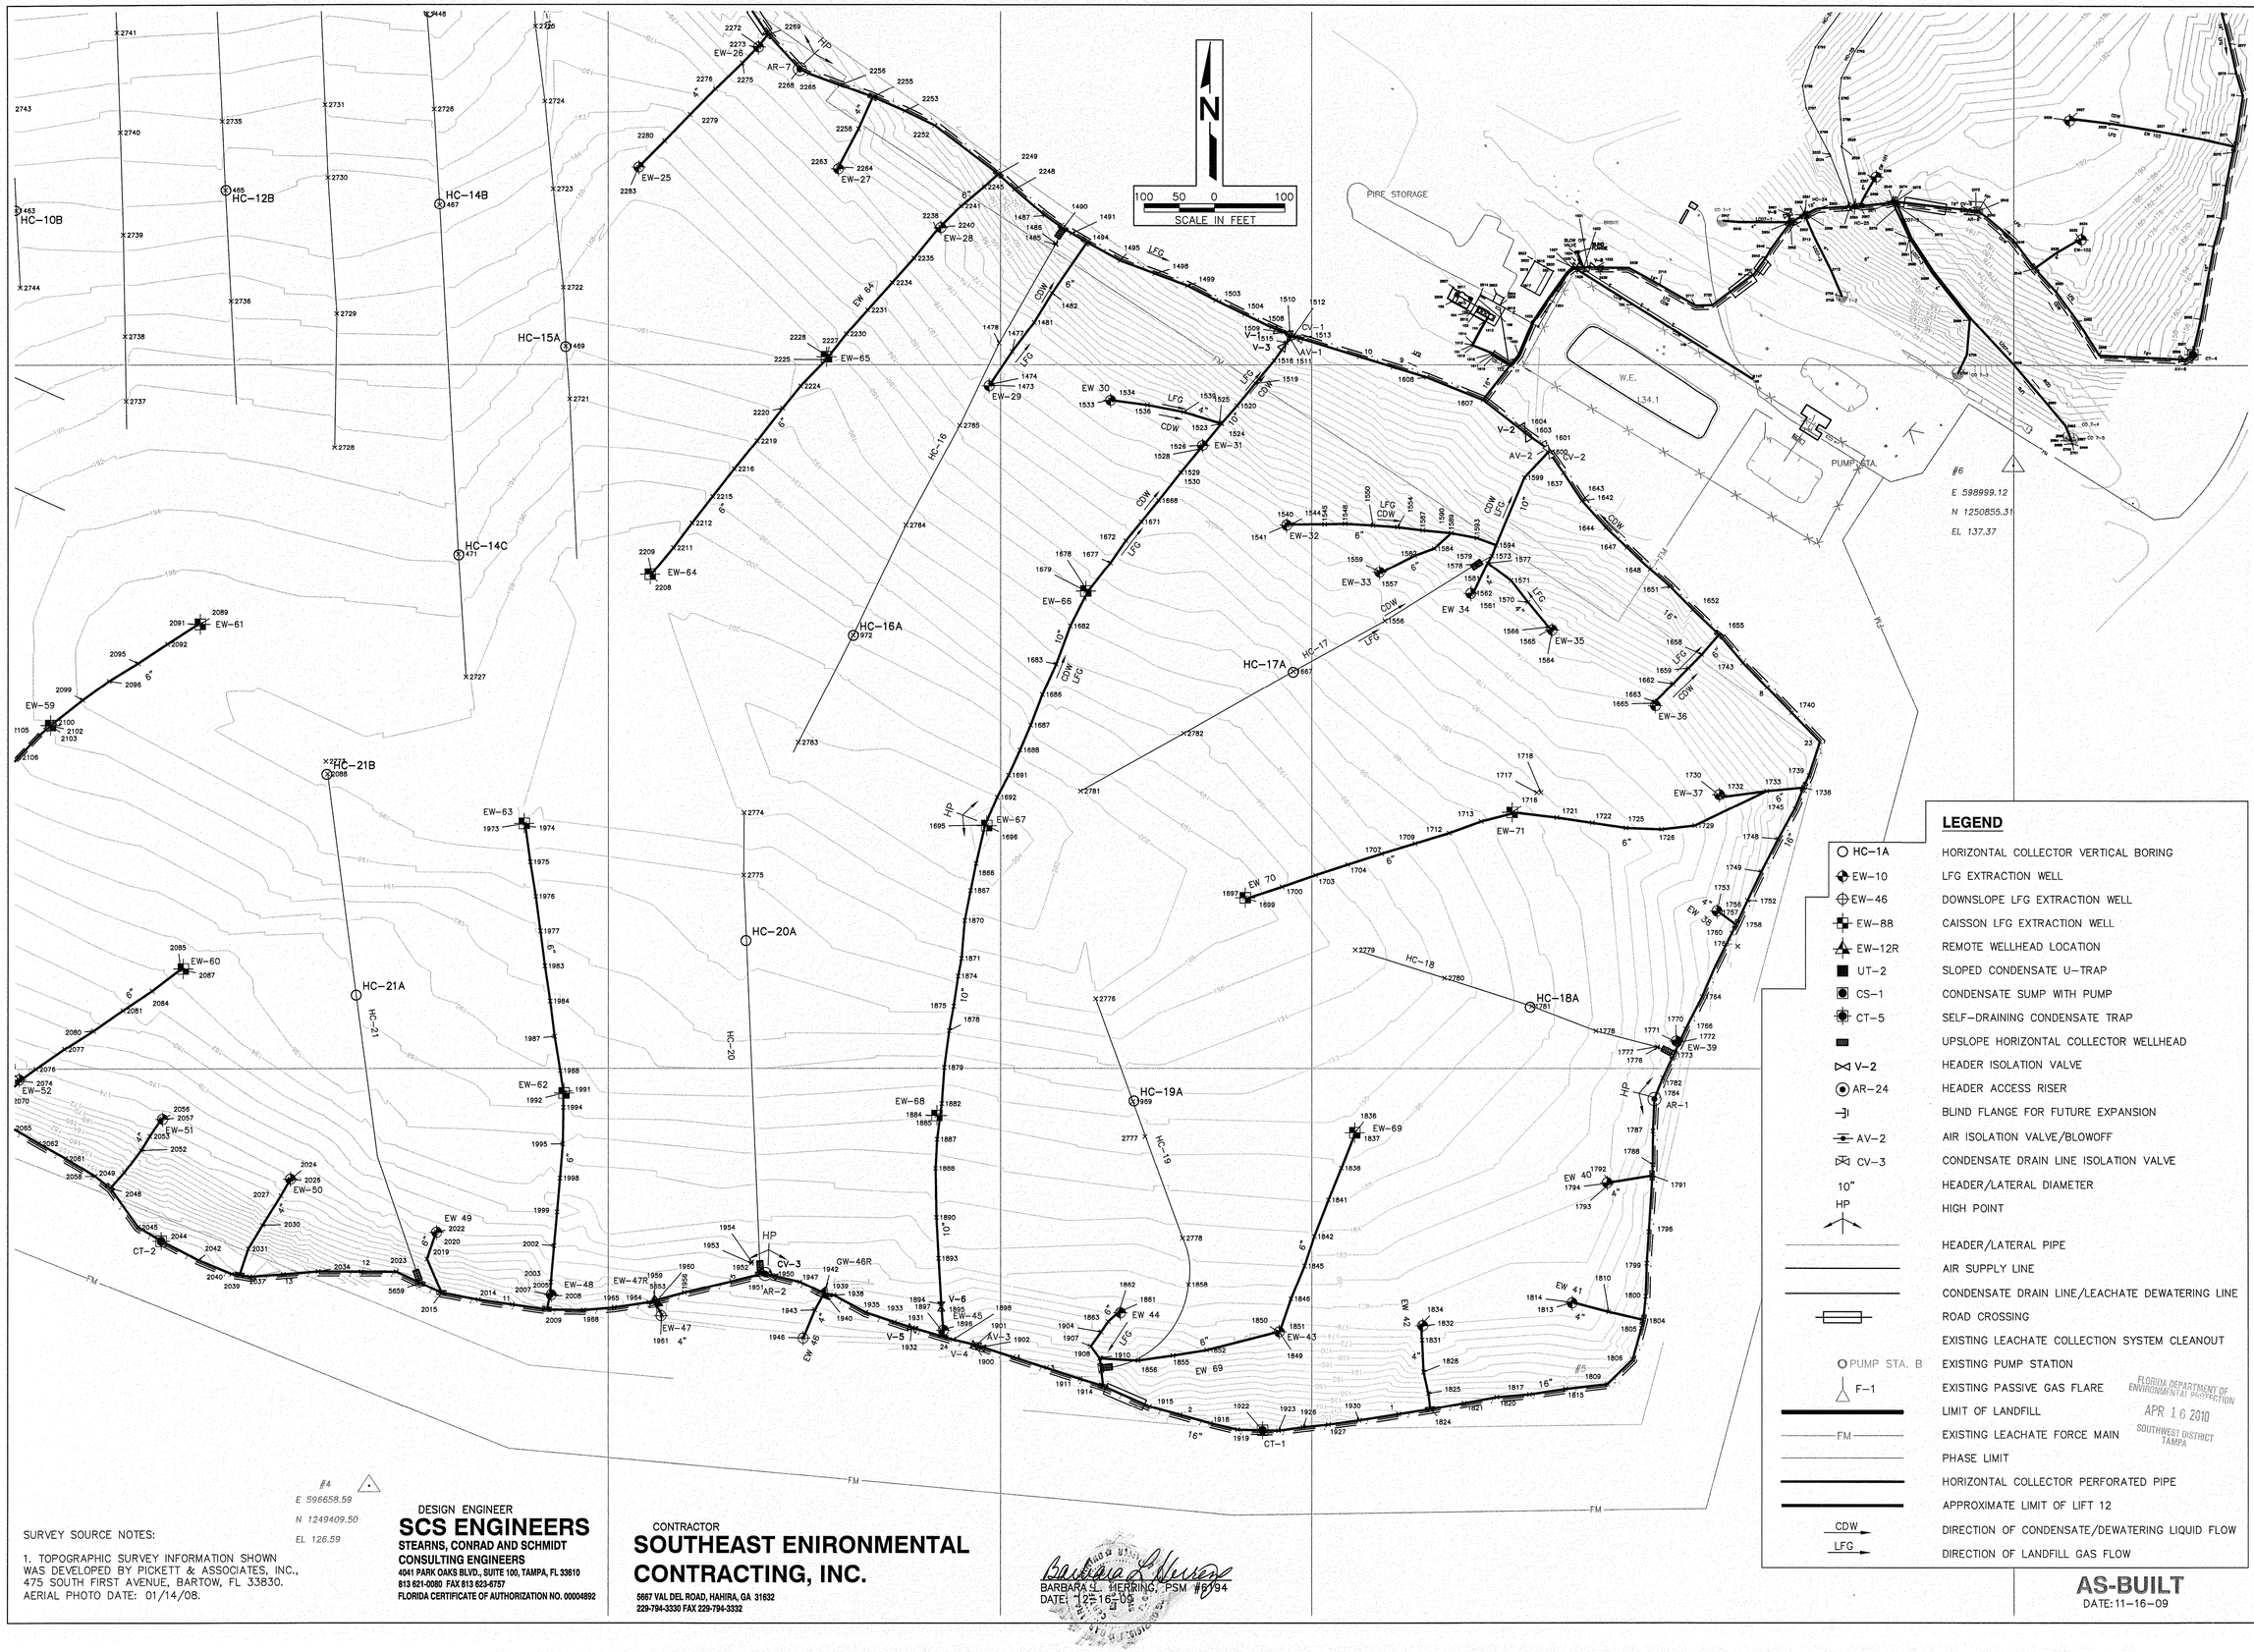

SURVEY SOURCE NOTES:

1. TOPOGRAPHIC SURVEY INFORMATION SHOWN WAS DEVELOPED BY PICKETT & ASSOCIATES, INC., 475 SOUTH FIRST AVENUE, BARTOW, FL 33830. AERIAL PHOTO DATE: 01/14/08.

LEGEND

HC-1A	HORIZONTAL COLLECTOR VERTICAL BORING
EW-10	LFG EXTRACTION WELL
EW-46	DOWNSLOPE LFG EXTRACTION WELL
EW-88	CAISSON LFG EXTRACTION WELL
EW-12R	REMOTE WELLHEAD LOCATION
UT-2	SLOPED CONDENSATE U-TRAP
CS-1	CONDENSATE SUMP WITH PUMP
CT-5	SELF-DRAINING CONDENSATE TRAP
	UPSLOPE HORIZONTAL COLLECTOR WELLHEAD
V-2	HEADER ISOLATION VALVE
AR-24	HEADER ACCESS RISER
	BLIND FLANGE FOR FUTURE EXPANSION
AV-2	AIR ISOLATION VALVE/BLOWOFF
CV-3	CONDENSATE DRAIN LINE ISOLATION VALVE
10"	HEADER/LATERAL DIAMETER
HP	HIGH POINT
	HEADER/LATERAL PIPE
	AIR SUPPLY LINE
	CONDENSATE DRAIN LINE/LEACHATE DEWATERING LINE
	ROAD CROSSING
	EXISTING LEACHATE COLLECTION SYSTEM CLEANOUT
PUMP STA. B	EXISTING PUMP STATION
F-1	EXISTING PASSIVE GAS FLARE
	LIMIT OF LANDFILL
FM	EXISTING LEACHATE FORCE MAIN
	PHASE LIMIT
	HORIZONTAL COLLECTOR PERFORATED PIPE
	APPROXIMATE LIMIT OF LIFT 12
CDW	DIRECTION OF CONDENSATE/DEWATERING LIQUID FLOW
LFG	DIRECTION OF LANDFILL GAS FLOW

DESIGN ENGINEER
SCS ENGINEERS
STEARNS, CONRAD AND SCHMIDT CONSULTING ENGINEERS
4041 PARK OAKS BLVD., SUITE 100, TAMPA, FL 33610
813 621-0080 FAX 813 623-6757
FLORIDA CERTIFICATE OF AUTHORIZATION NO. 00004892

CONTRACTOR
SOUTHEAST ENIRONMENTAL CONTRACTING, INC.
5667 VAL DEL ROAD, HAHIRA, GA 31632
229-794-3330 FAX 229-794-3332

BARBARA L. HERRING, PSM #6194
DATE: 12-16-09

FLORIDA DEPARTMENT OF ENVIRONMENTAL PROTECTION
APR 16 2010
SOUTHWEST DISTRICT TAMPA

AS-BUILT
DATE: 11-16-09

REV	DATE	DESCRIPTION	BY

BARBARA L HERRING, PLS
LICENCE NO. 6194

DRAWING TITLE: **SITE PLAN**

PROJECT TITLE: **SOUTHEAST COUNTY LANDFILL LANDFILL GAS COLLECTION AND CONTROL SYSTEM PROJECT**

CLIENT: **HILLSBOROUGH COUNTY SOLID WASTE MANAGEMENT DEPARTMENT TAMPA, FLORIDA**

SOUTHEASTERN SURVEYING, INC.
901 N. ST. AUGUSTINE RD., VALDOSTA, GA. 31601
229-244-3382 FAX 229-244-3383
FLORIDA CERTIFICATE OF AUTHORIZATION NO. 00007091

PROJ. NO.	07C055.00
DSN. BY:	
DWN. BY:	
CHK. BY:	BLH
Q/A R/W BY:	
APP. BY:	

CADD FILE: 075500PROP

DATE: NOVEMBER 16, 2009

SCALE: AS SHOWN

DRAWING NO. **2**