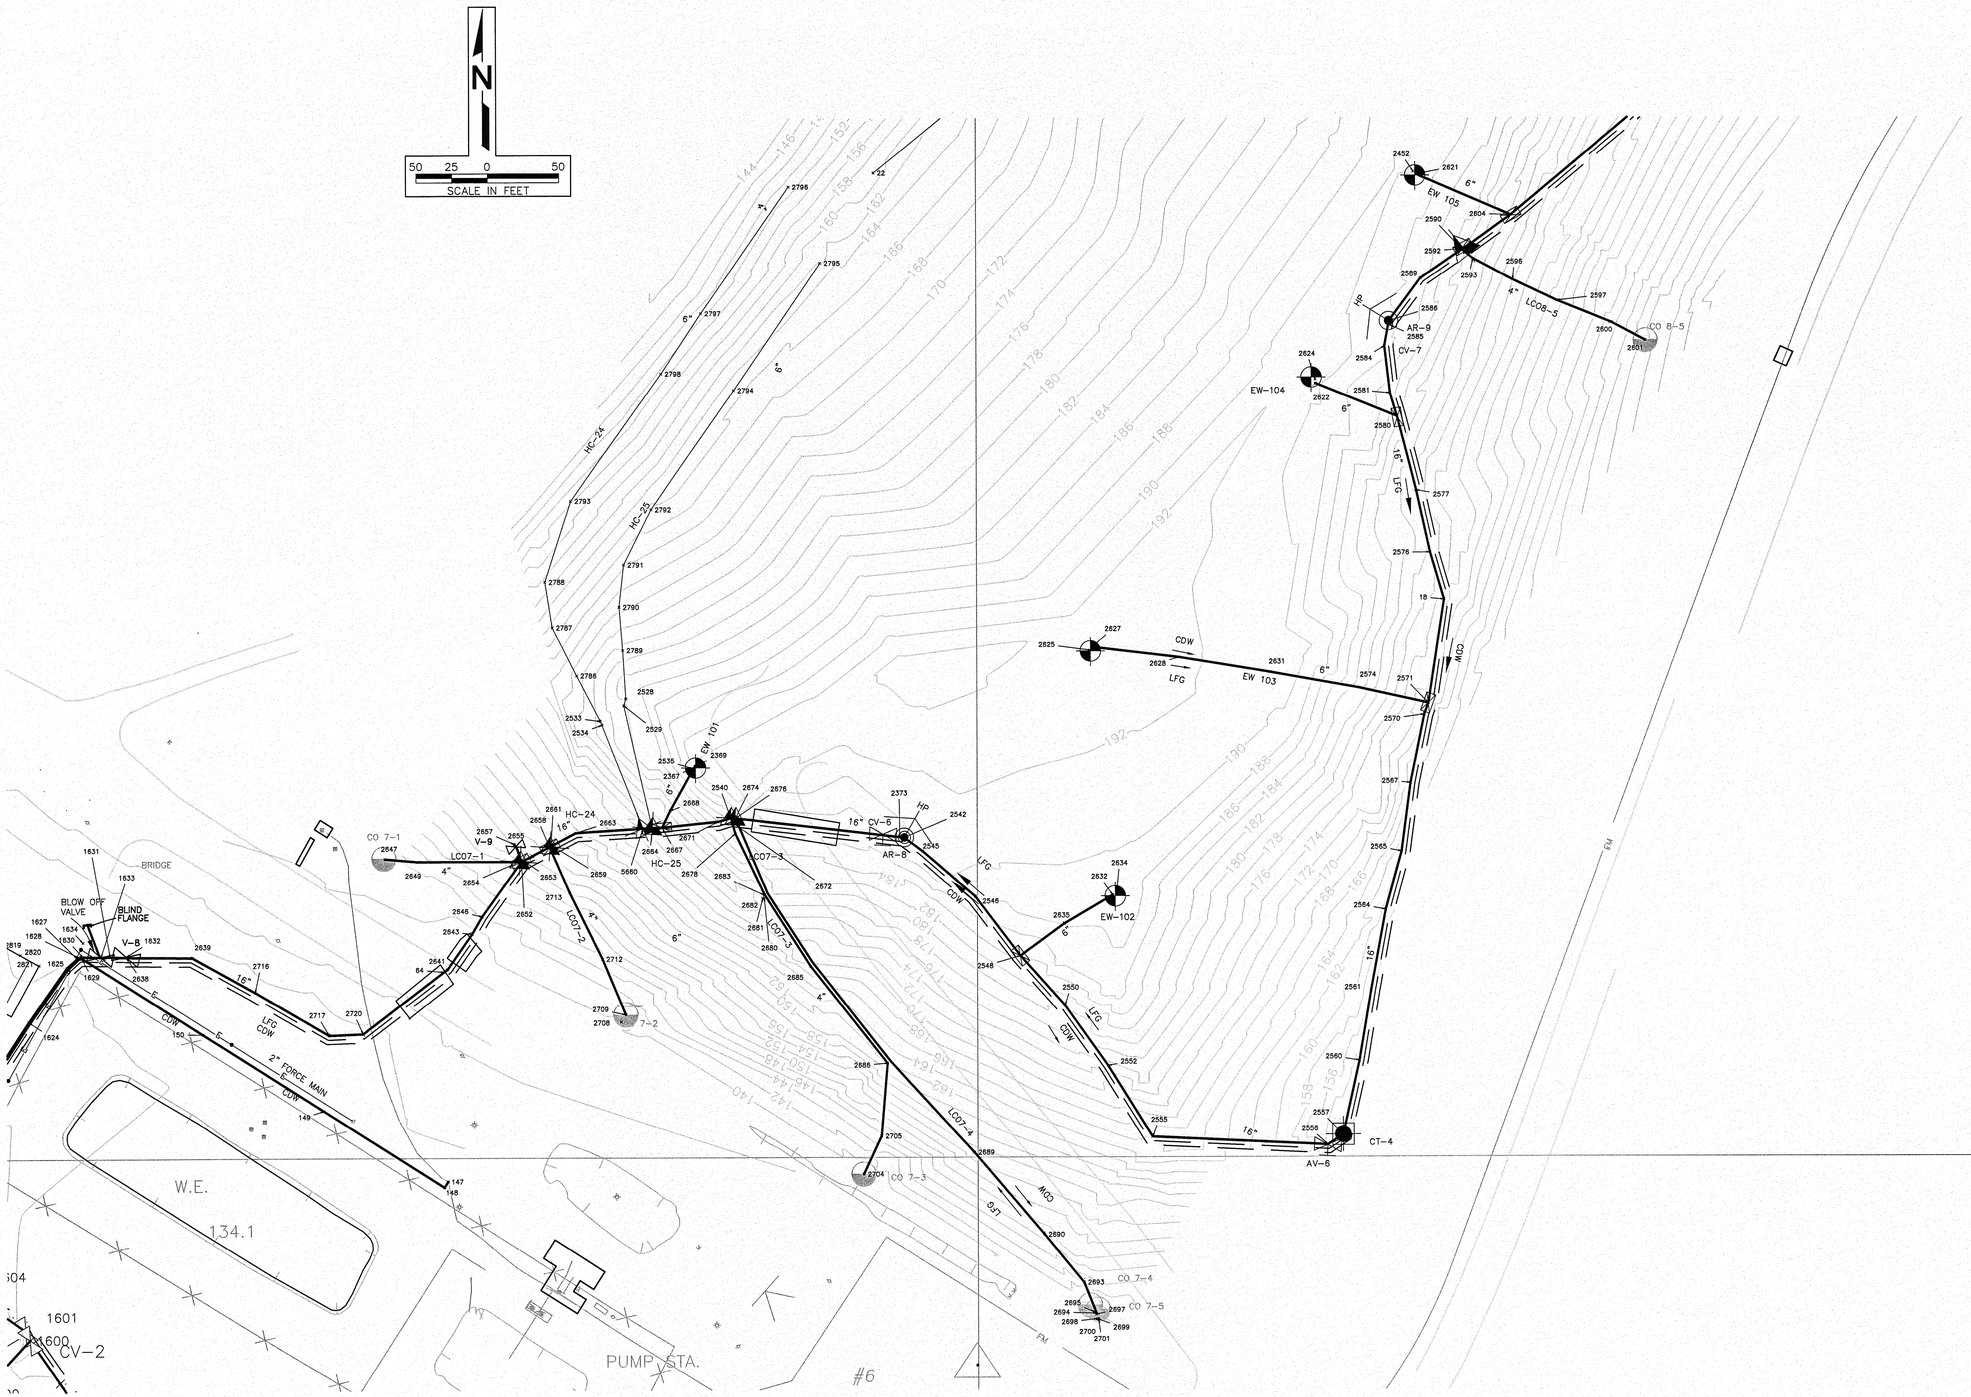


SURVEY SOURCE NOTES:

1. TOPOGRAPHIC SURVEY INFORMATION SHOWN WAS DEVELOPED BY PICKETT & ASSOCIATES, INC., 475 SOUTH FIRST AVENUE, BARTOW, FL 33830. AERIAL PHOTO DATE: 01/14/08.

BARBARA L. HERRING, PSM #6194
DATE: 12-16-09

CONTRACTOR
SOUTHEAST ENIRONMENTAL CONTRACTING, INC.
5667 VAL DEL ROAD, HAHIRA, GA 31632
229-794-3330 FAX 229-794-3332

DESIGN ENGINEER
SCS ENGINEERS
STEARNS, CONRAD AND SCHMIDT CONSULTING ENGINEERS
4041 PARK OAKS BLVD., SUITE 100, TAMPA, FL 33610
813 621-0080 FAX 813 623-5757
FLORIDA CERTIFICATE OF AUTHORIZATION NO. 00004892

FLORIDA DEPARTMENT OF ENVIRONMENTAL PROTECTION
APR 16 2010
SOUTHWEST DISTRICT TAMPA

AS-BUILT
DATE: 11-16-09

REV	DATE	DESCRIPTION	BY

BARBARA L.HERRING, PLS LICENSE NO. 6194

DRAWING TITLE: **SITE PLAN**

PROJECT TITLE:
SOUTHEAST COUNTY LANDFILL LANDFILL GAS COLLECTION AND CONTROL SYSTEM PROJECT

CLIENT
HILLSBOROUGH COUNTY SOLID WASTE MANAGEMENT DEPARTMENT TAMPA, FLORIDA

SOUTHEASTERN SURVEYING, INC.
601 N. ST. AUGUSTINE RD., VALDOSTA, GA. 31601
229-259-9405 FAX 229-259-9505
FLORIDA CERTIFICATE OF AUTHORIZATION NO. 00007091

PROJ. NO. 09207055.00 | DWN. BY: BLH | Q/A R'VW BY: | APP. BY:
DSN. BY: | CHK. BY:

CADD FILE: 075500PROP

DATE: NOVEMBER 16, 2009

SCALE: AS SHOWN

DRAWING NO. **4**