

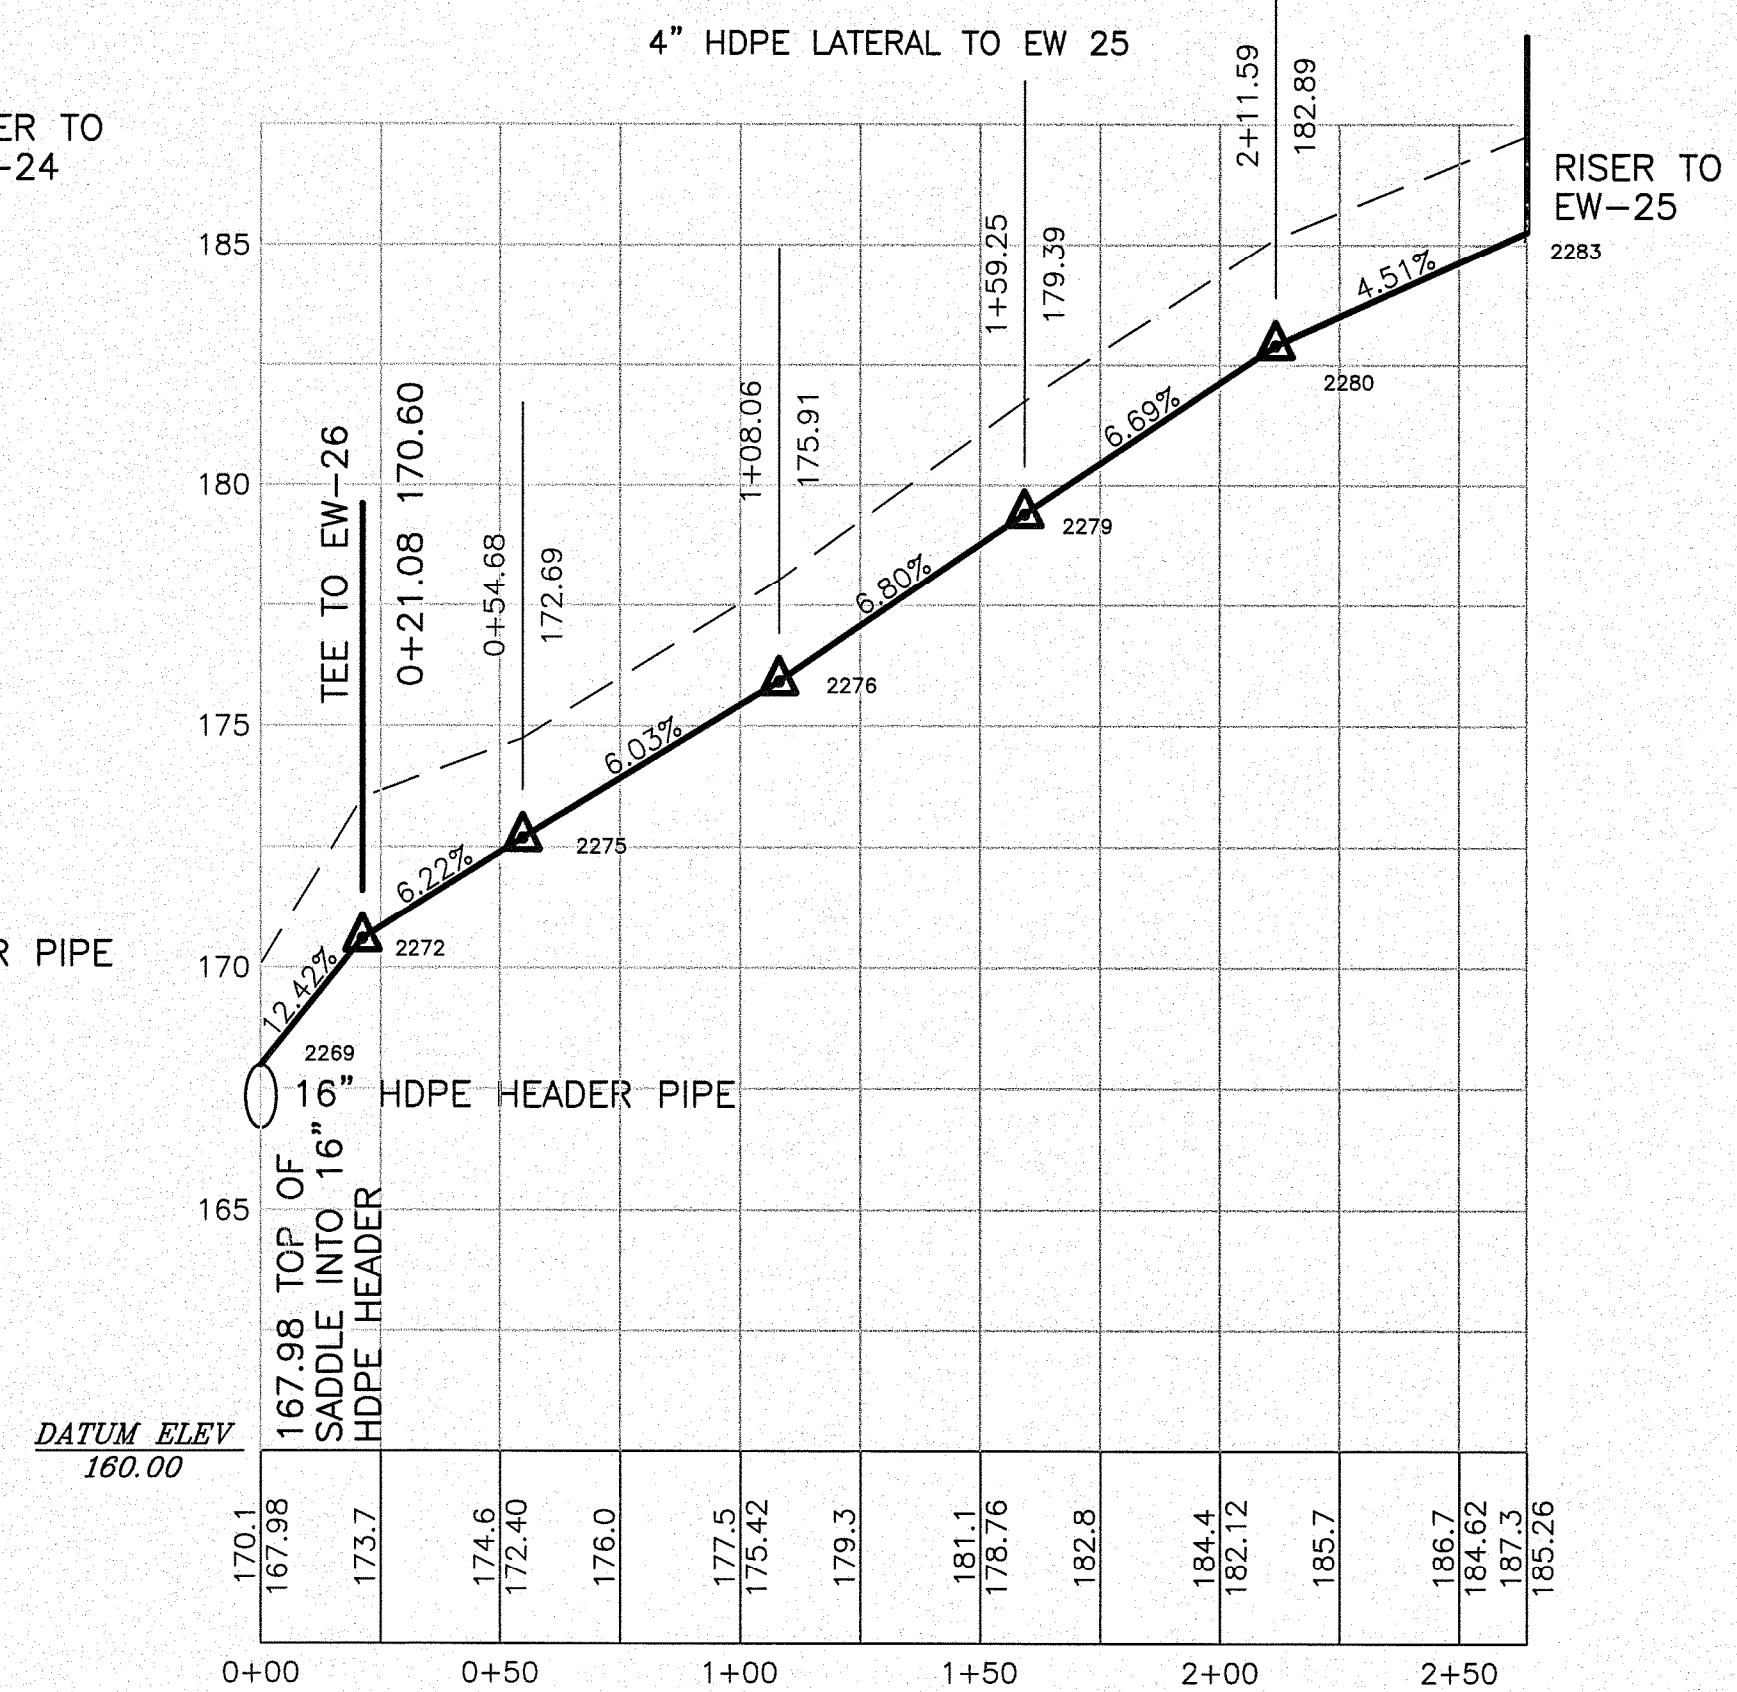
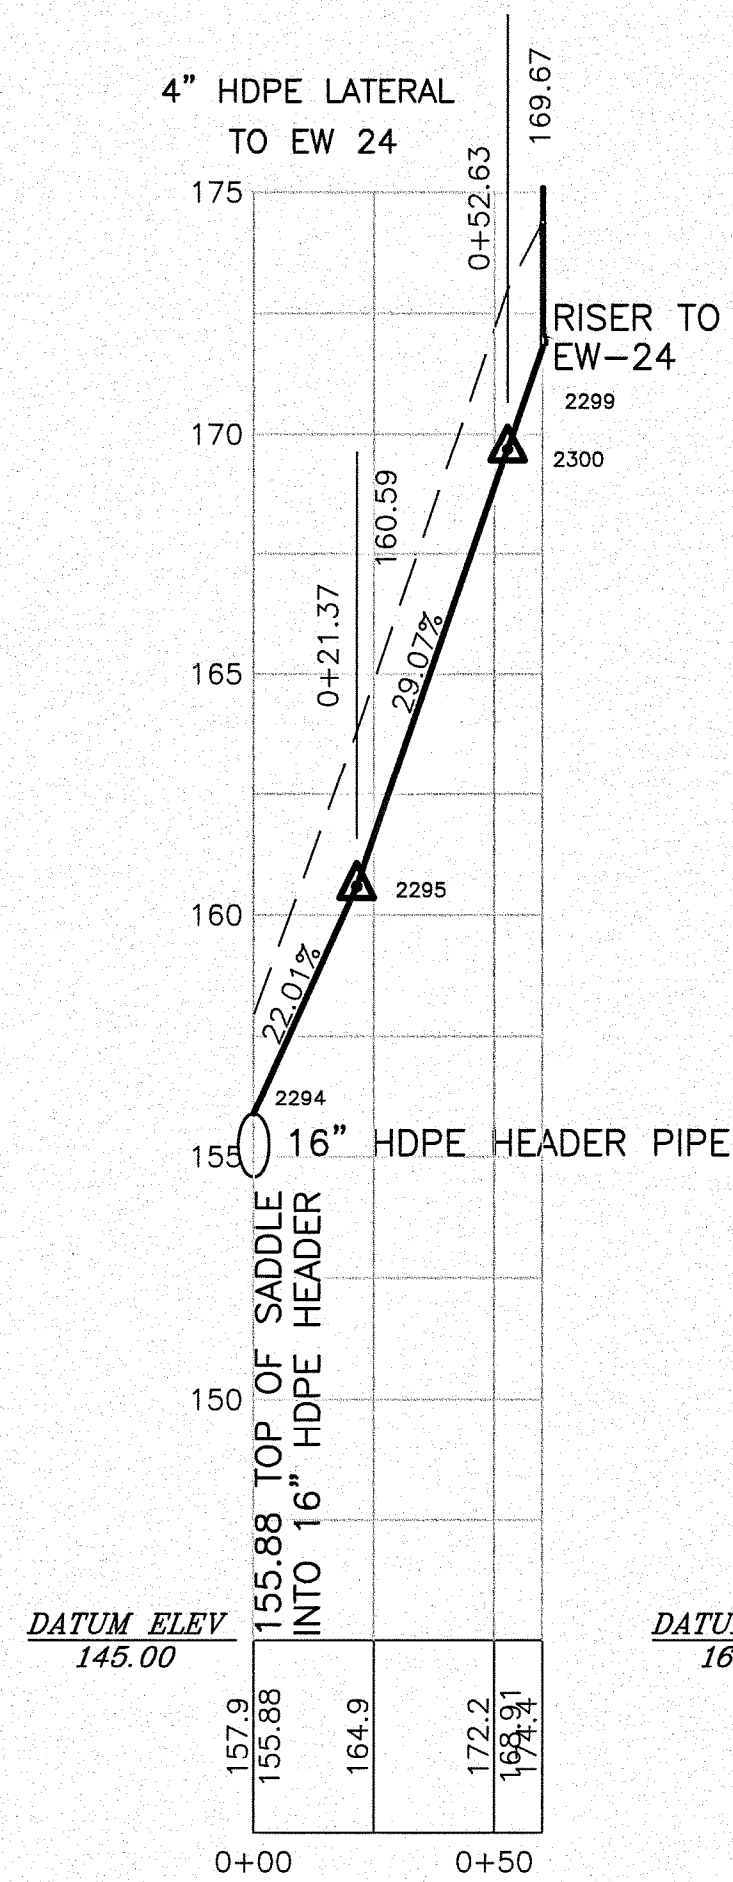
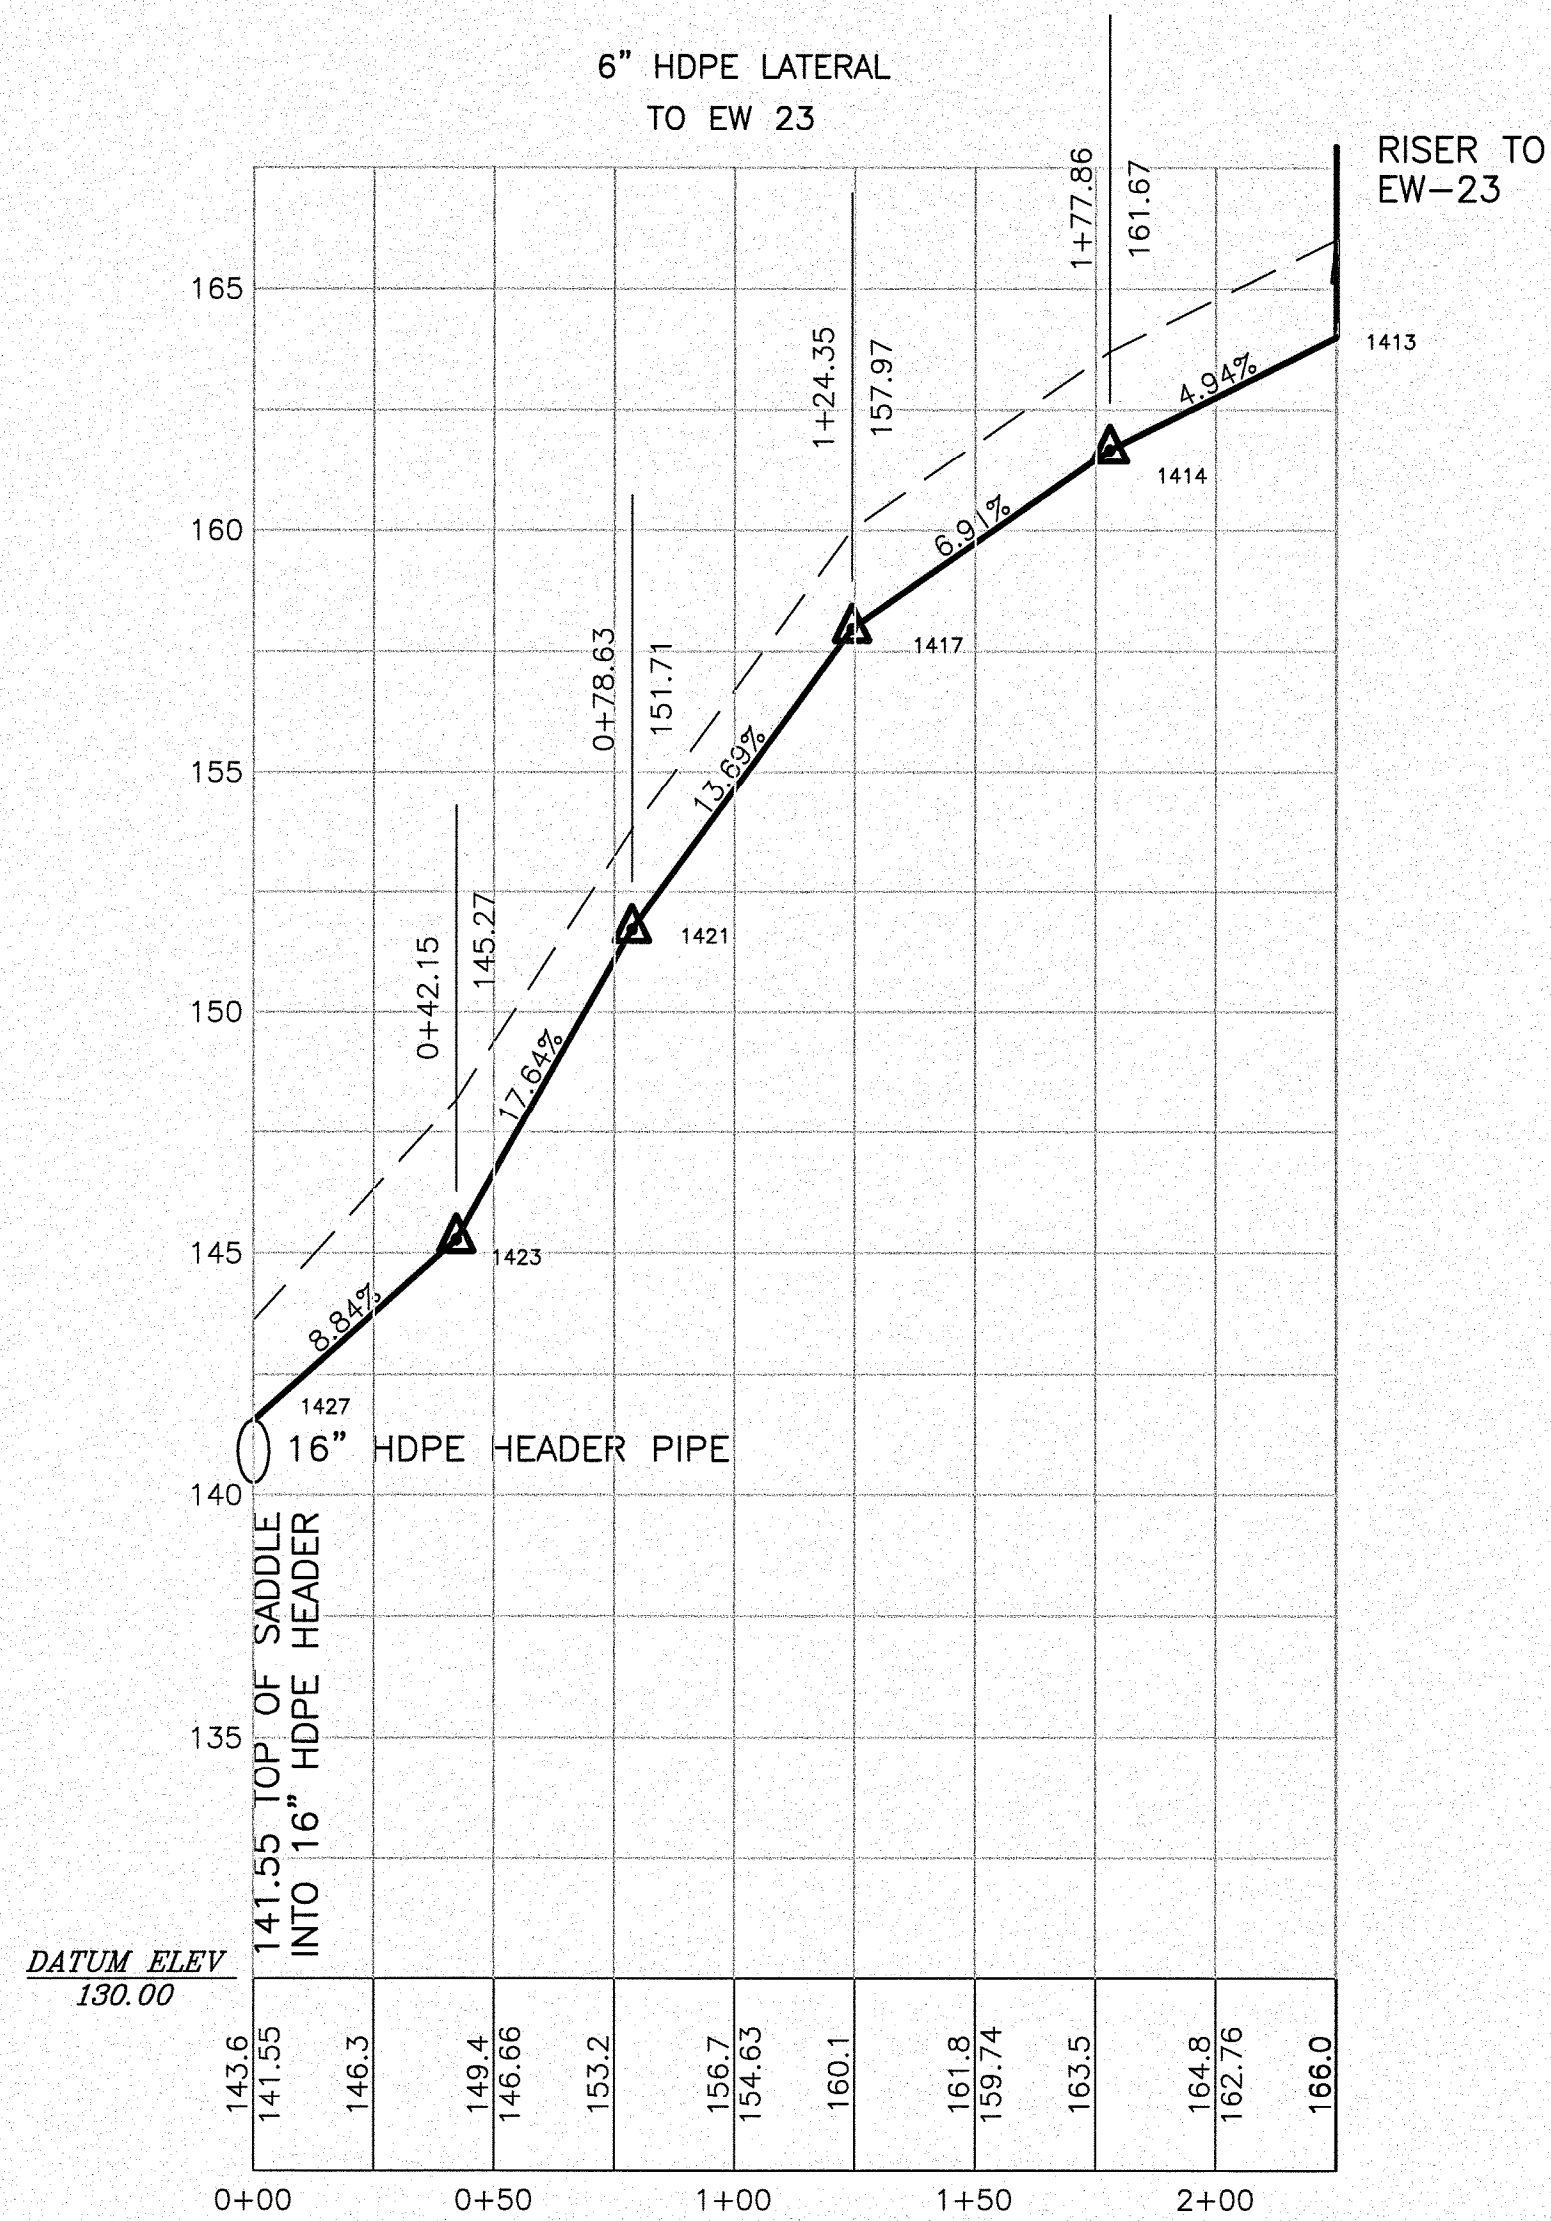
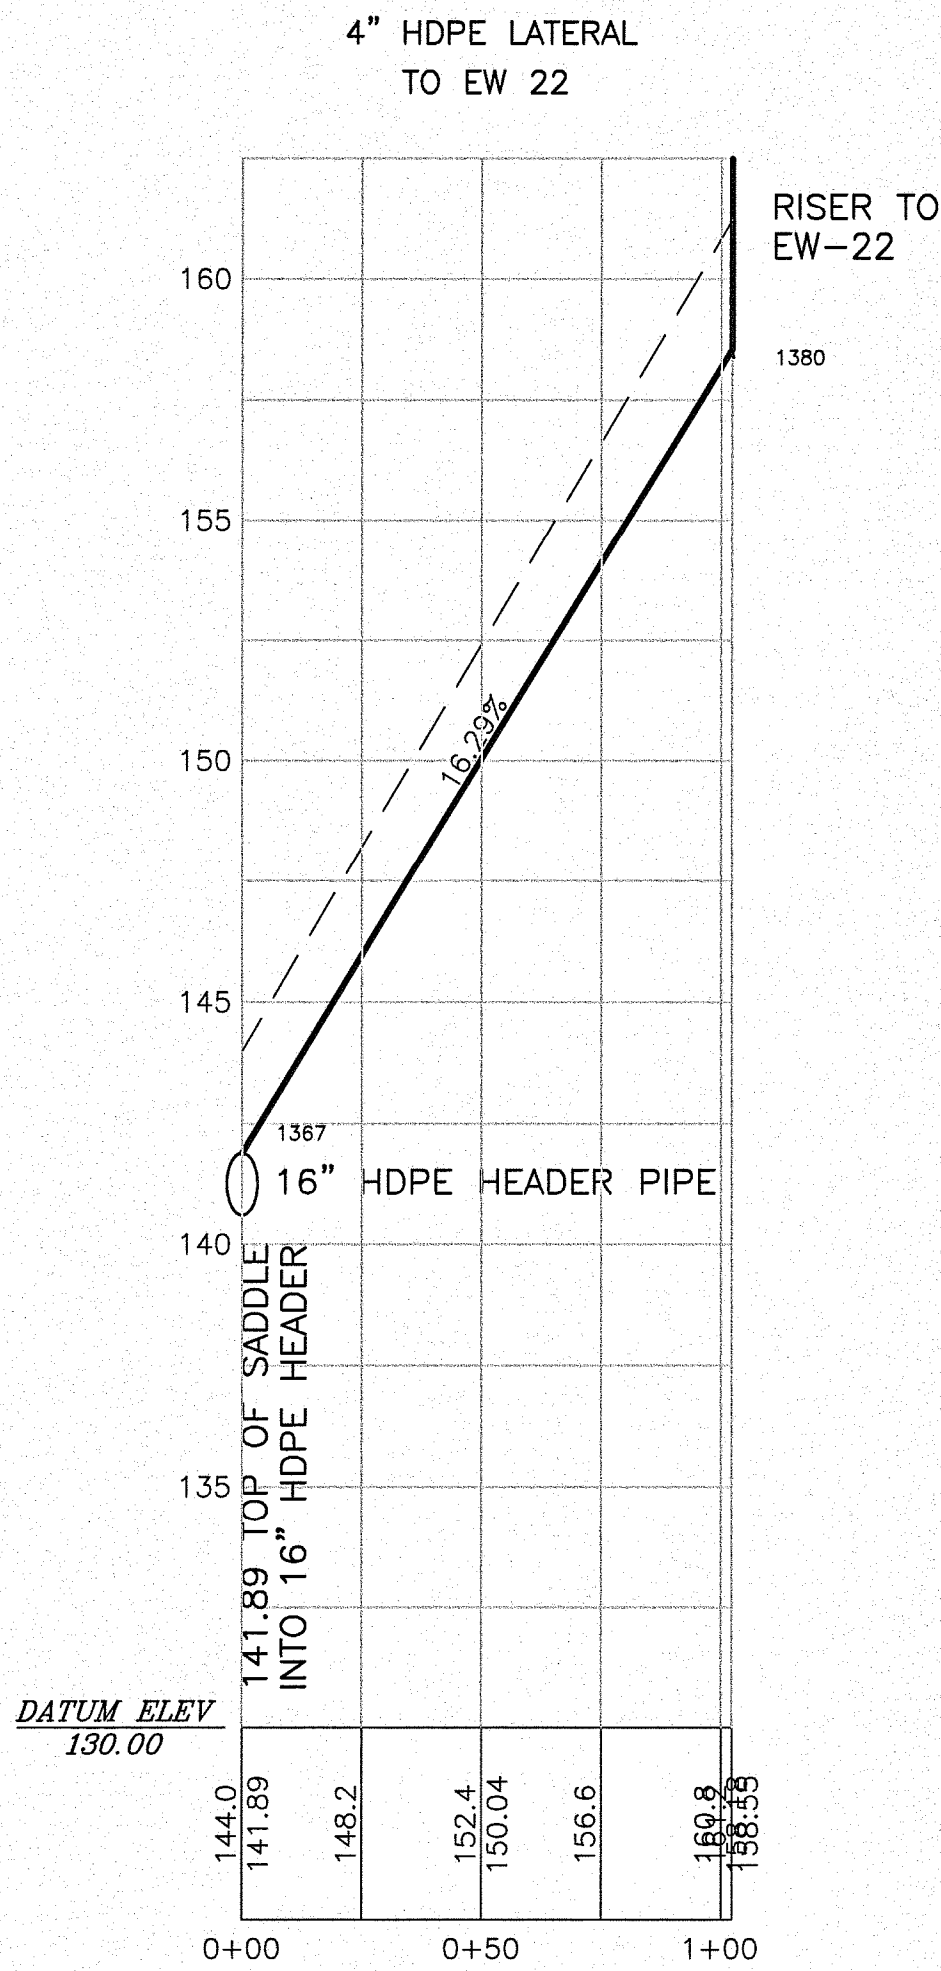


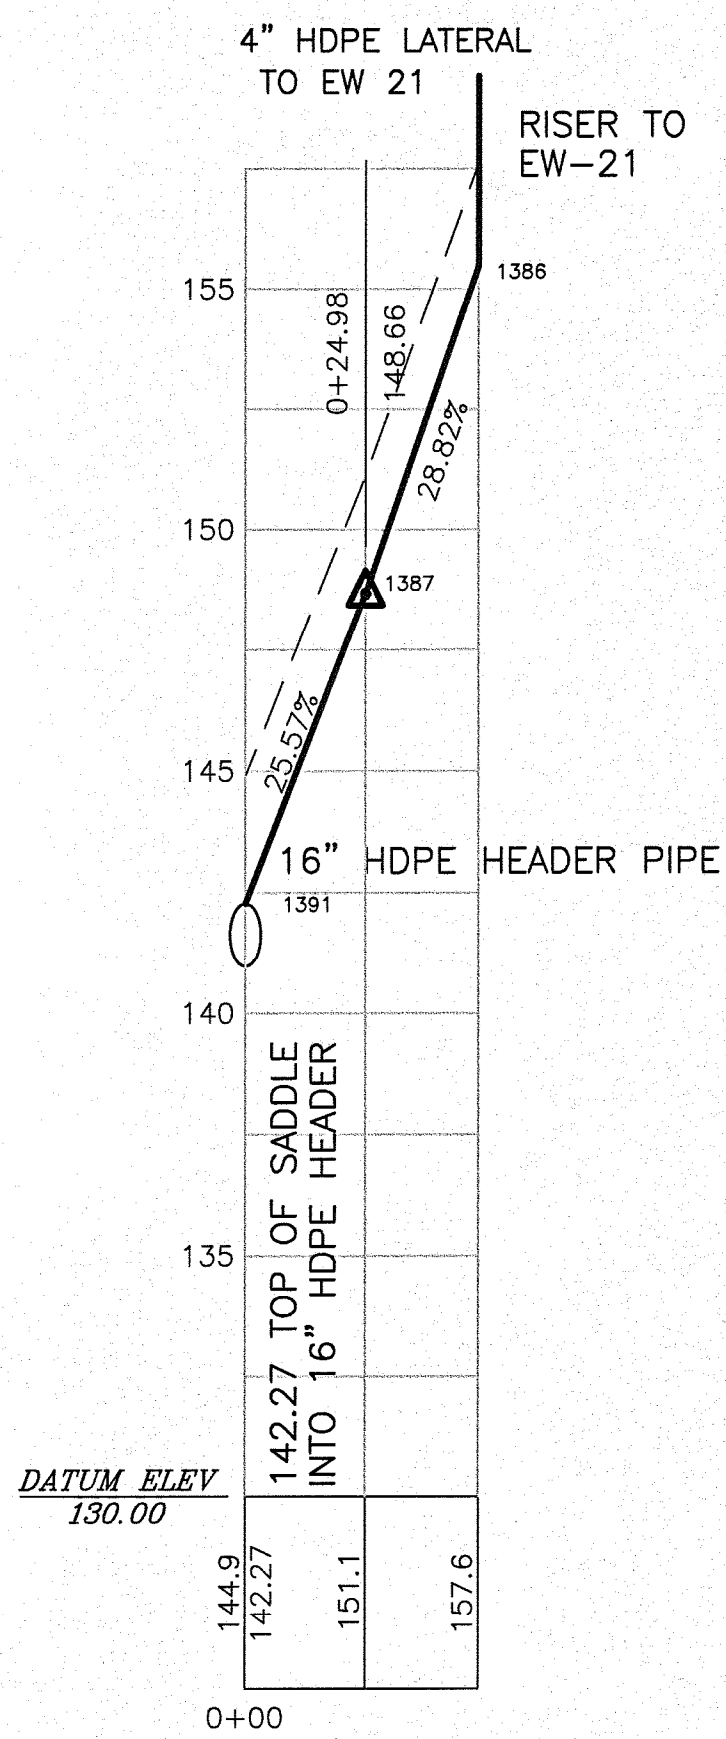

Barbara L. Herring, PSM #6194
 BARBARA L. HERRING, PSM #6194
 DATE: 12-16-09

CONTRACTOR
SOUTHEAST ENVIRONMENTAL CONTRACTING, INC.
 5867 VAL DEL ROAD, HAHIRA, GA 31632
 229-794-3330 FAX 229-794-3332

DESIGN ENGINEER
SCS ENGINEERS
 STEARNS, CONRAD AND SCHMIDT
 CONSULTING ENGINEERS
 4041 PARK OAKS BLVD., SUITE 100, TAMPA, FL 33610
 813 821-0080 FAX 813 823-8757
 FLORIDA CERTIFICATE OF AUTHORIZATION NO. 00004892

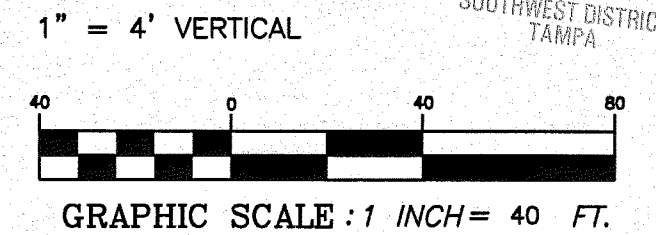

FLORIDA DEPARTMENT OF ENVIRONMENTAL PROTECTION
 APR 16 2010
 SOUTHWEST DISTRICT TAMPA

SOUTHEASTERN SURVEYING, INC. 601 N. ST. JUSTINE RD., VALDOSTA, GA 31601 229-259-9455 FAX 229-259-9626 FLORIDA CERTIFICATE OF AUTHORIZATION NO. 00007091		HILLSBOROUGH COUNTY SOLID WASTE MANAGEMENT DEPARTMENT TAMPA, FLORIDA		DRAWING TITLE PIPE PROFILES		REV DATE DESCRIPTION BY	
CADD FILE: PROFILE 40 SCALE							
DATE: DECEMBER 16, 2009							
SCALE: 1" = 40'							
DRAWING NO.							
11							
						BARBARA L. HERRING, RLS LICENSE NO. 6194	