
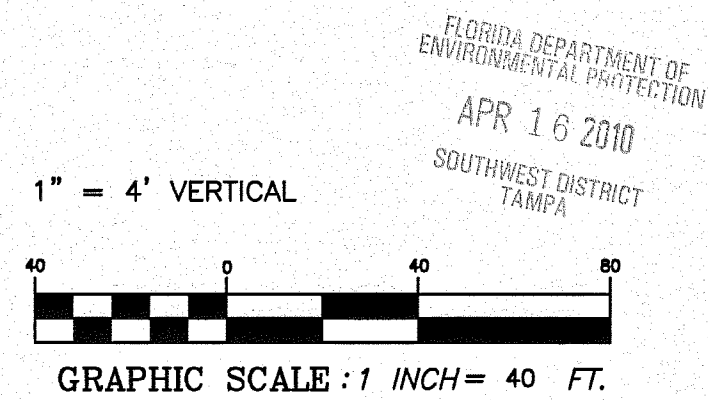
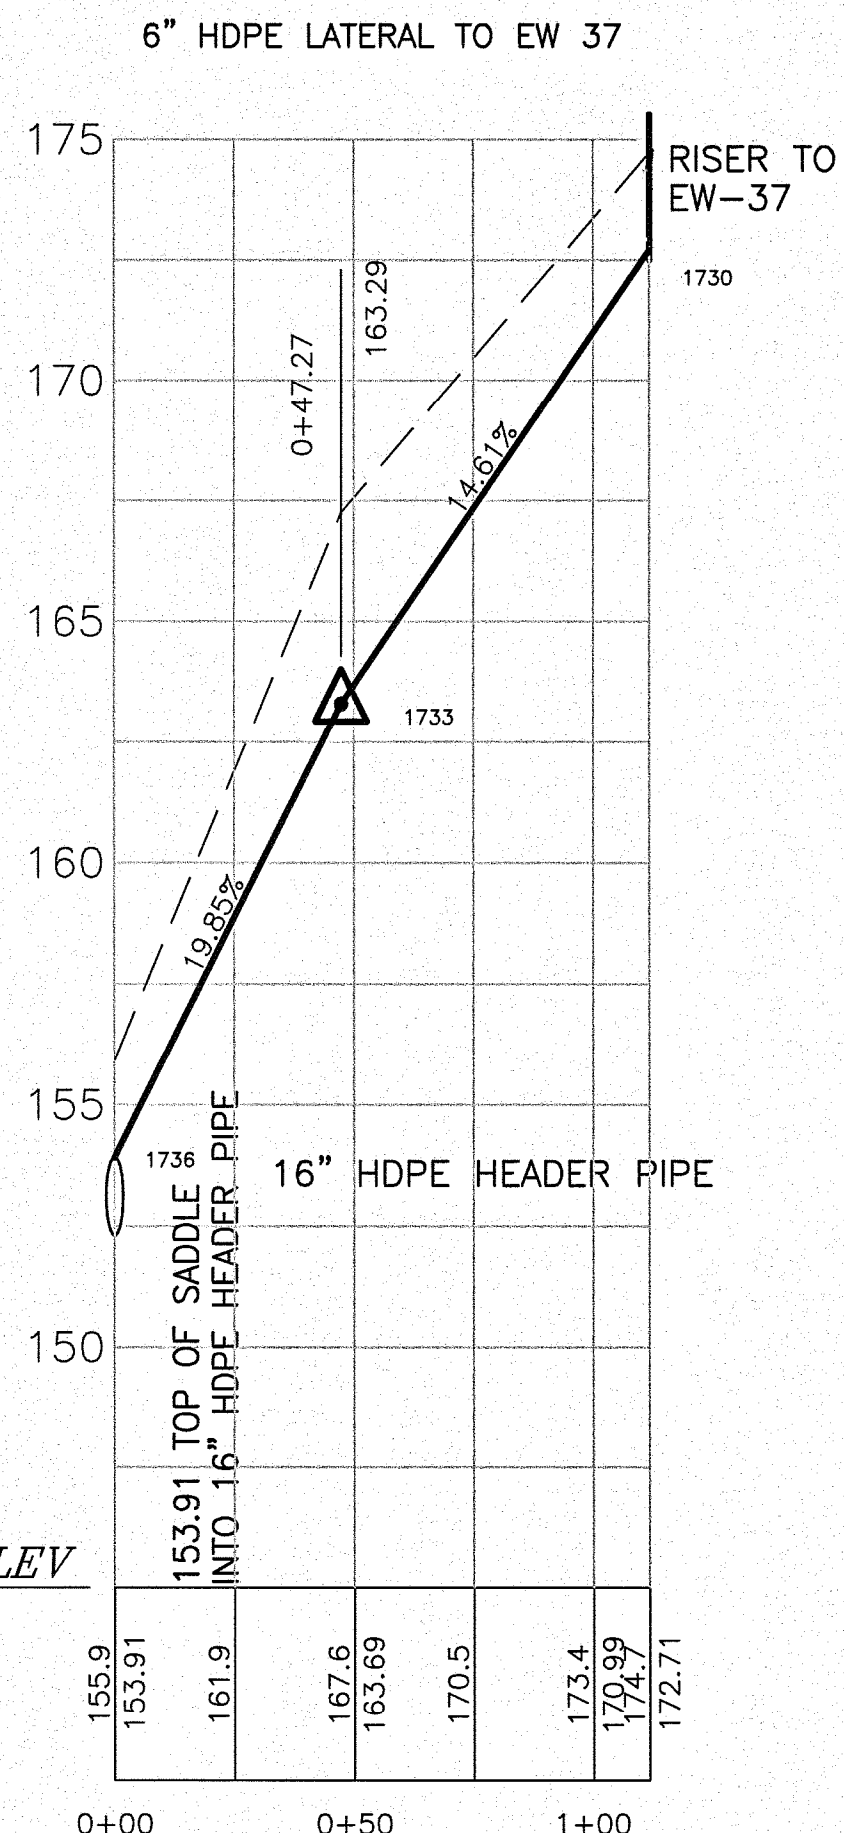
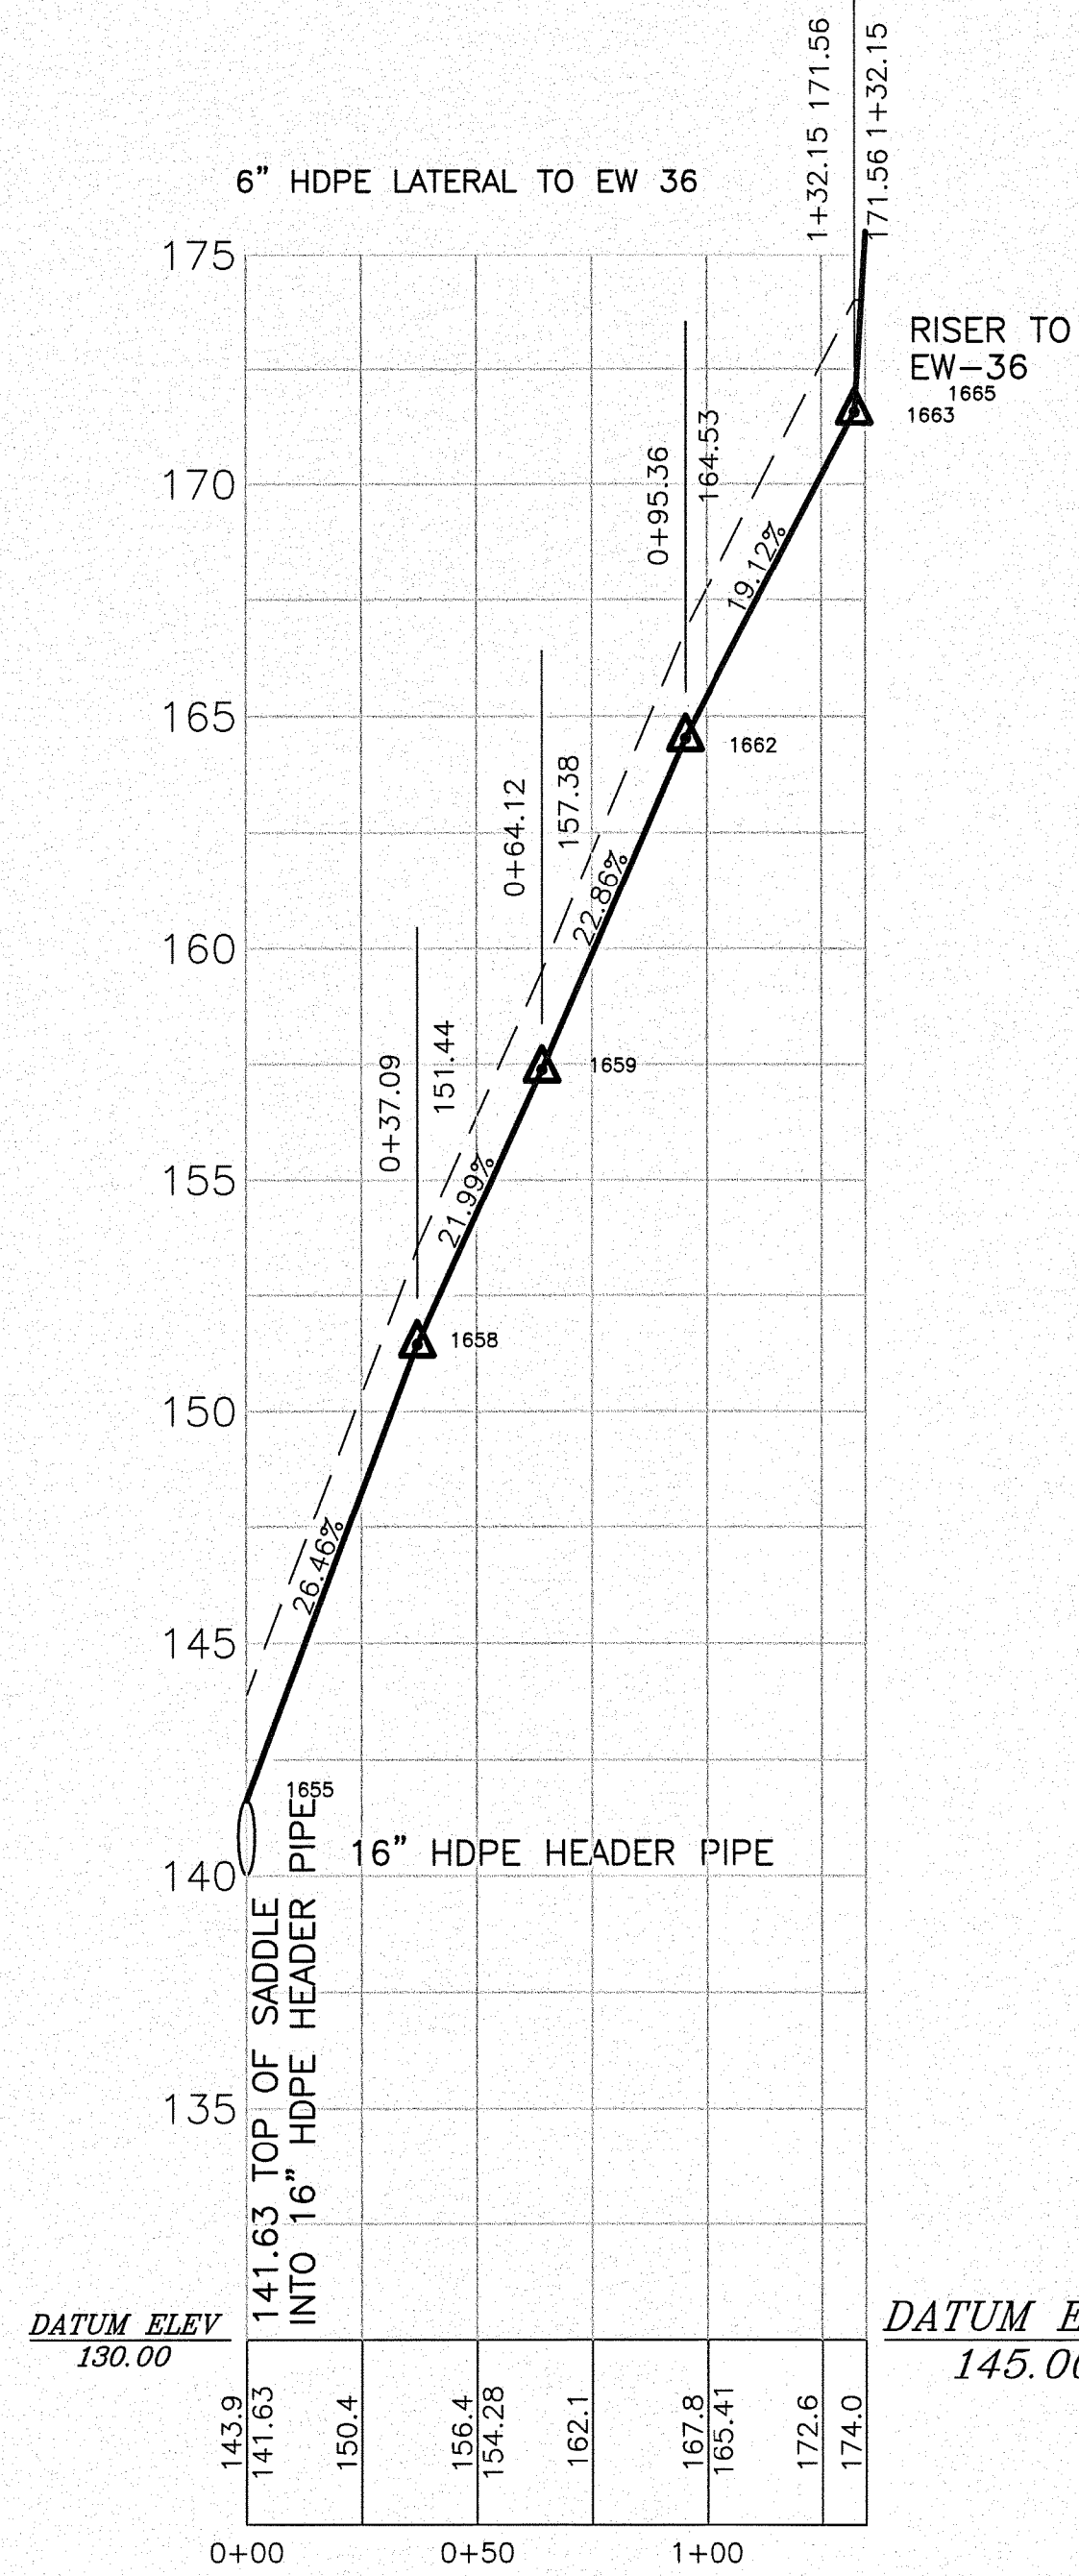
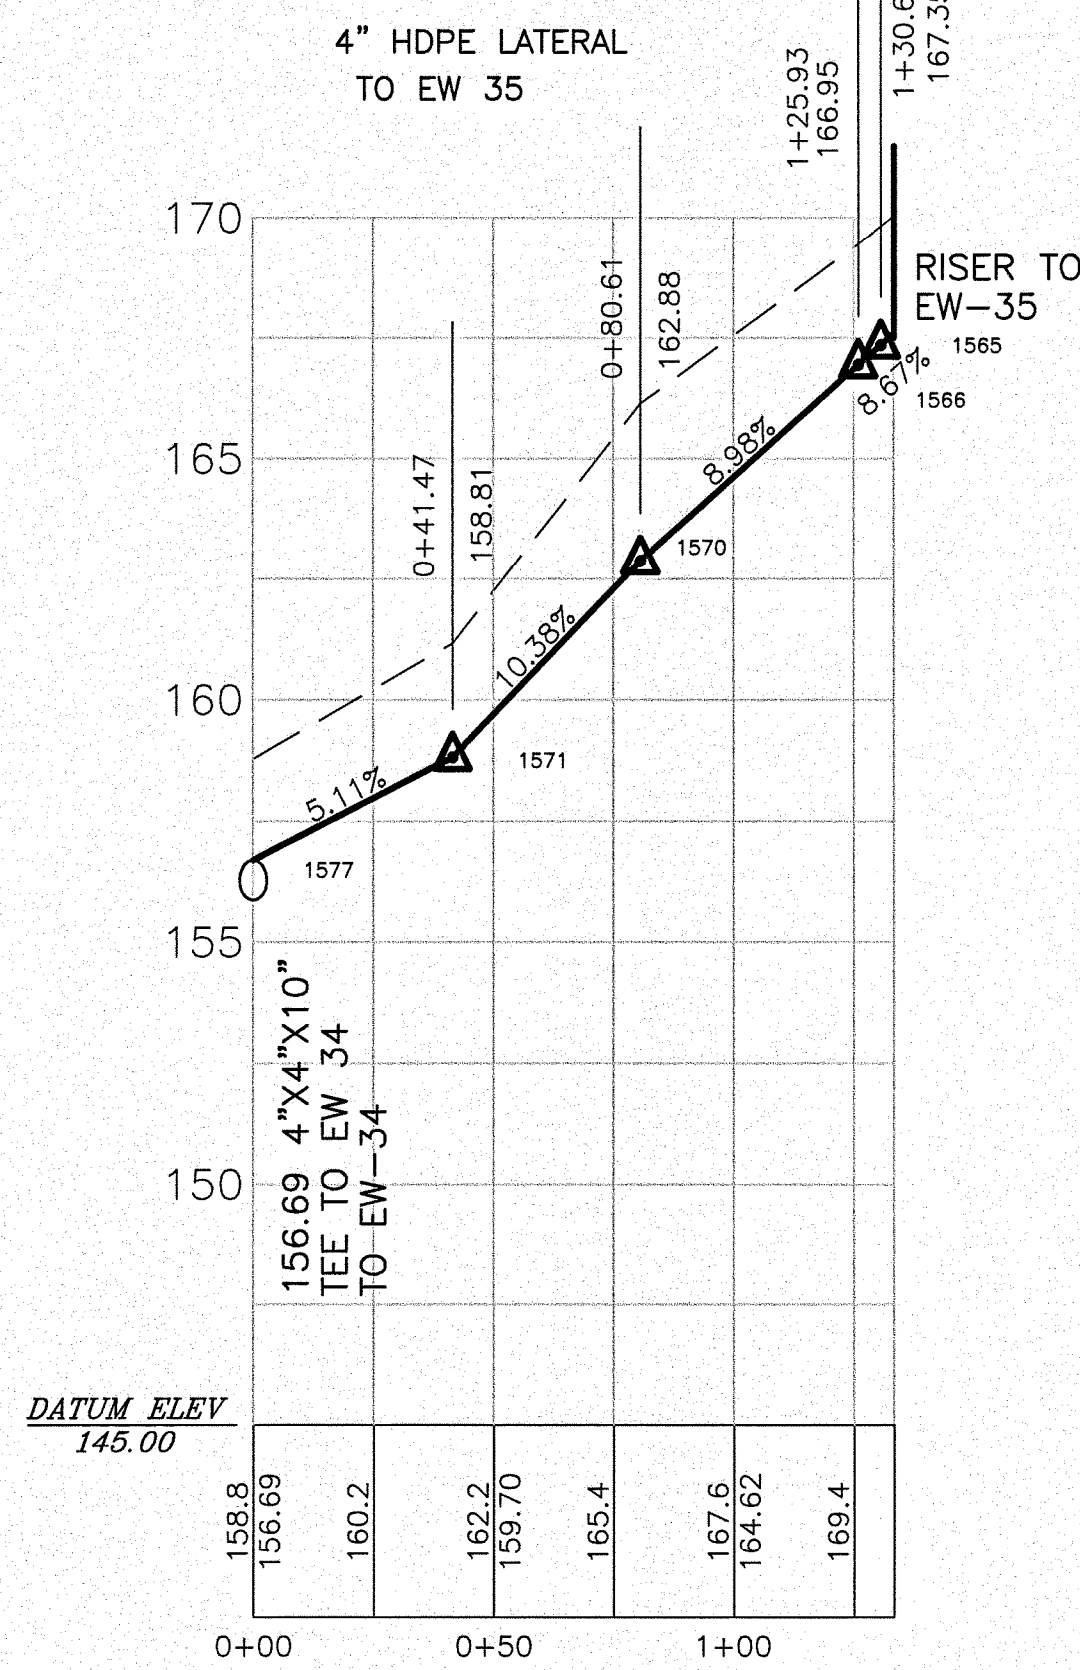
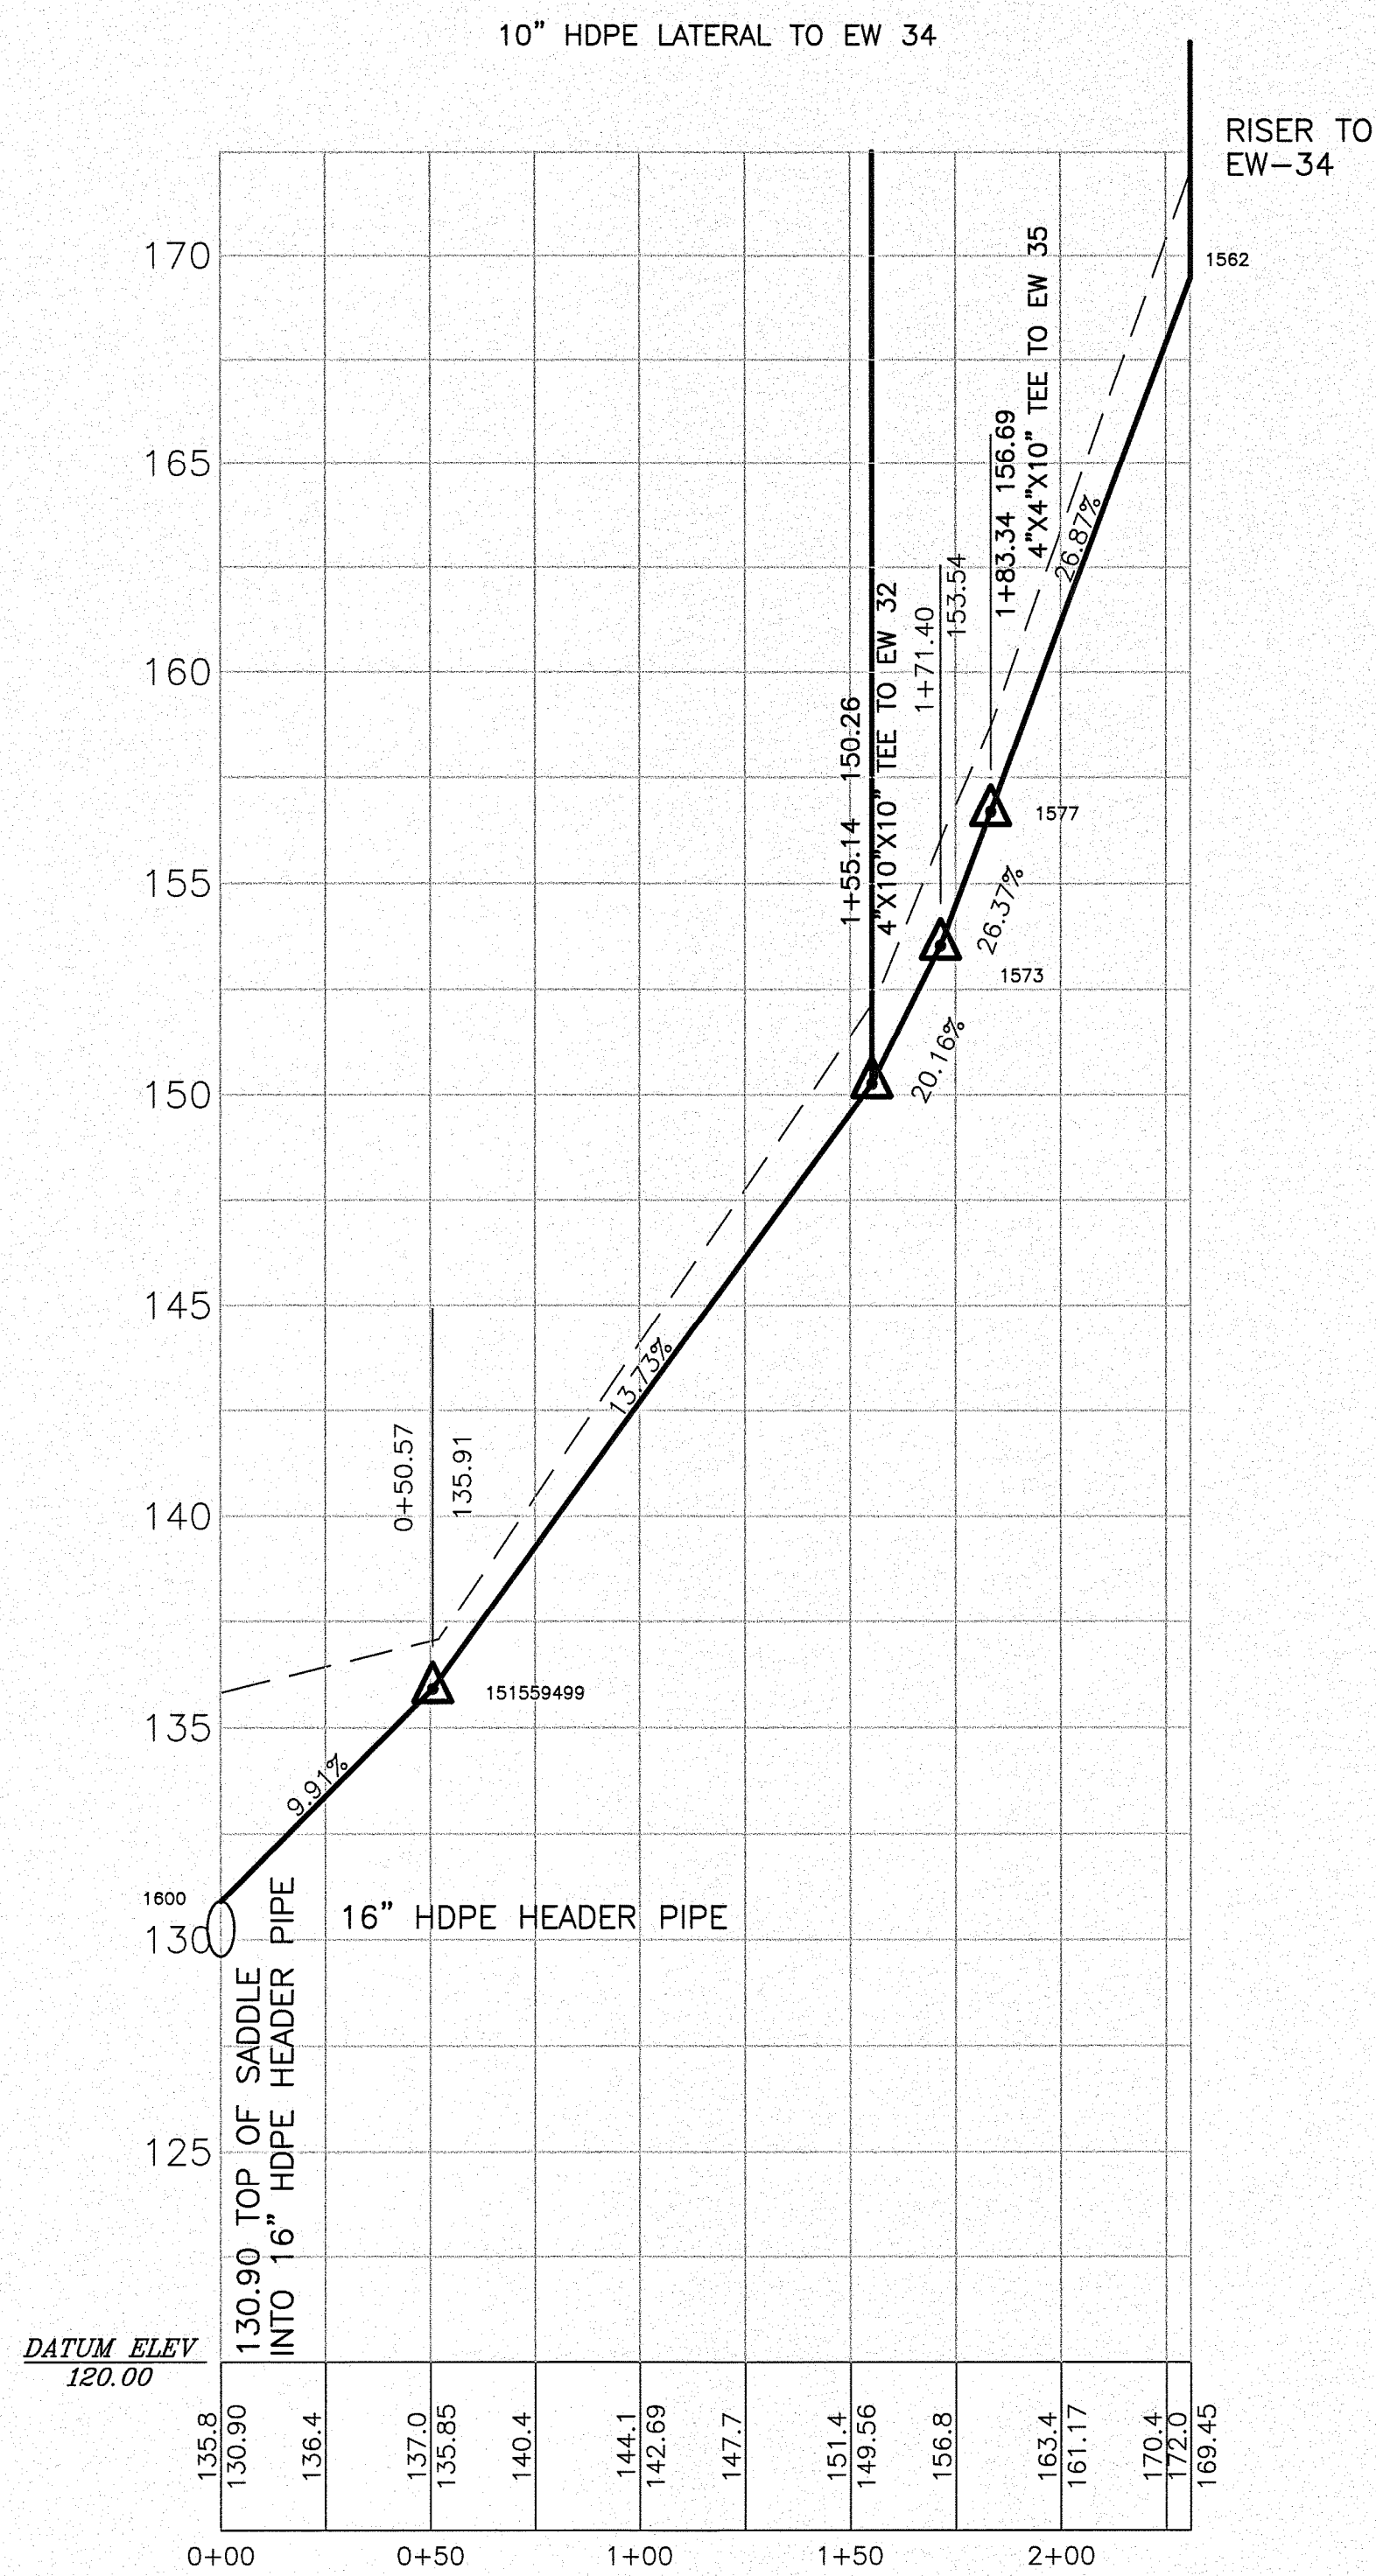


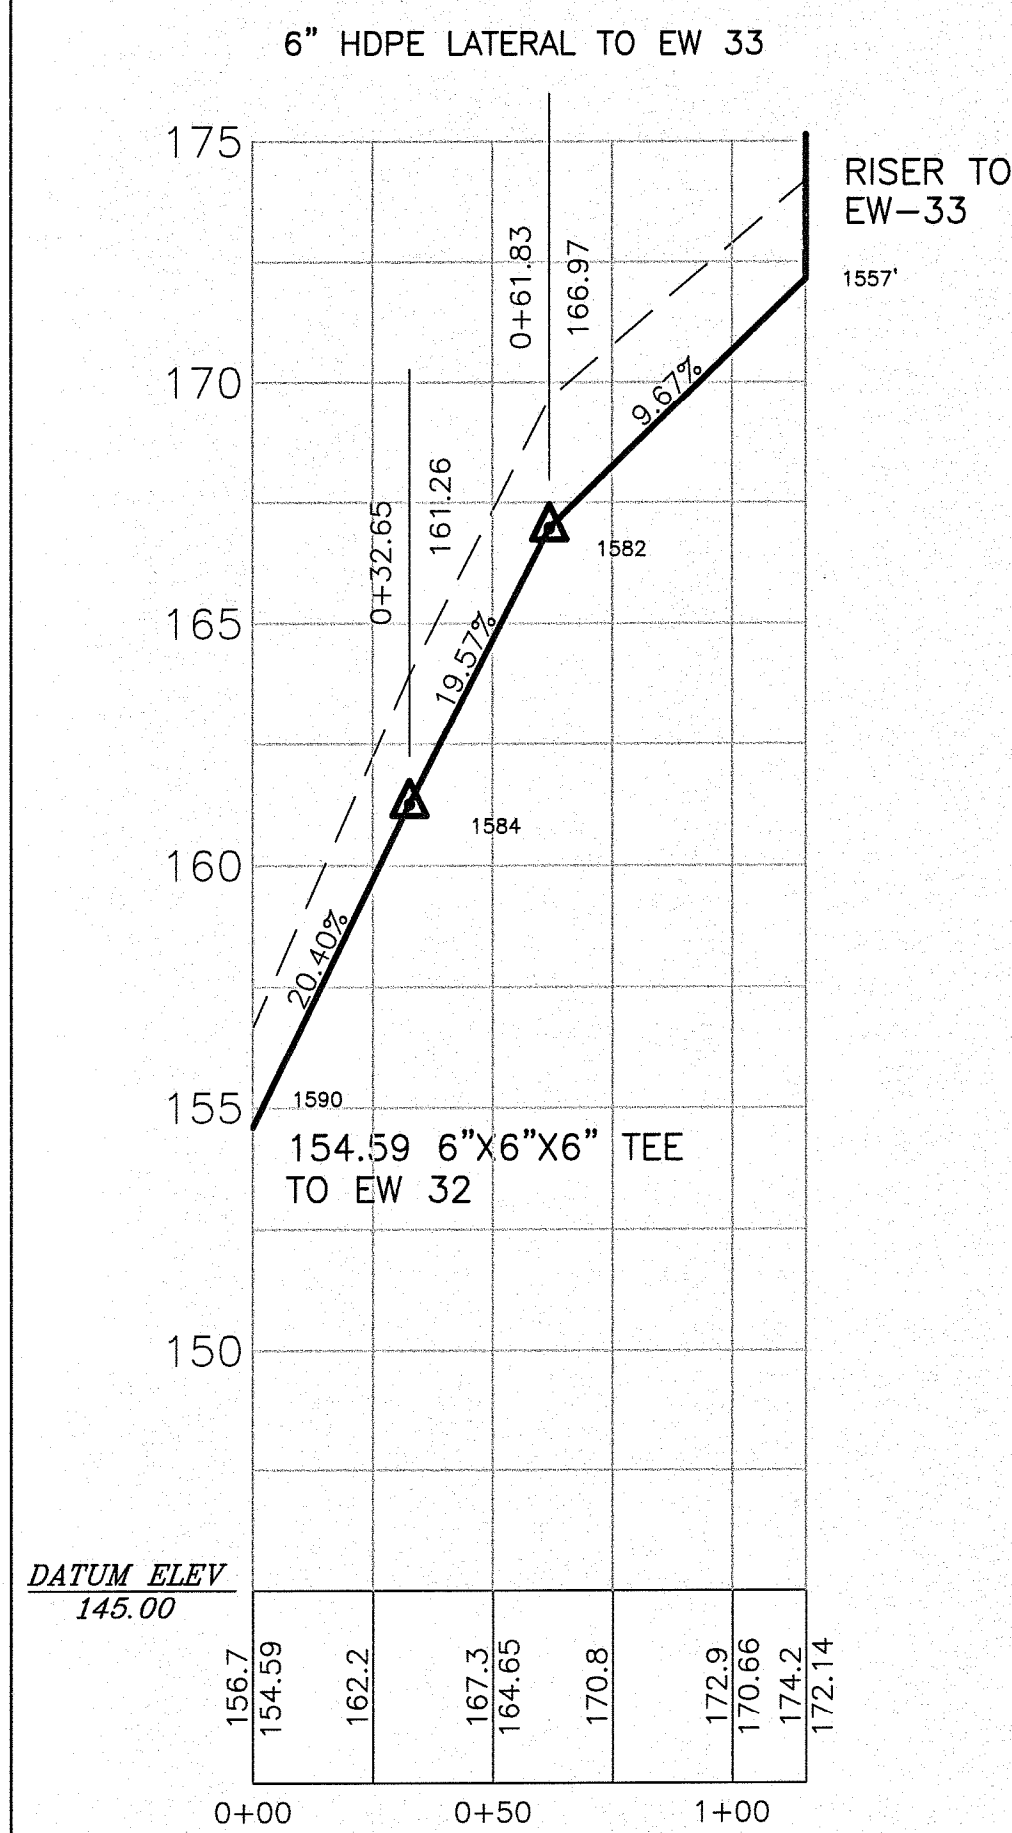

CONTRACTOR
SOUTHEAST ENIRONMENTAL CONTRACTING, INC.
5667 VAL DEL ROAD, HAHIRA, GA 31632
229-794-3330 FAX 229-794-3332

DESIGN ENGINEER
SCS ENGINEERS
STEARN, CONRAD AND SCHMIDT CONSULTING ENGINEERS
4041 PARK OAKS BLVD., SUITE 100, TAMPA, FL 33610
813 621-0080 FAX 813 623-6757
FLORIDA CERTIFICATE OF AUTHORIZATION NO. 00004892

DRAWING TITLE	PIPE PROFILES		DATE	DESCRIPTION	BY
	PROJECT TITLE				
CLIENT	HILLSBOROUGH COUNTY SOLID WASTE MANAGEMENT DEPARTMENT TAMPA, FLORIDA				
	SOUTHEASTERN SURVEYING, INC.				
DATE	DECEMBER 16, 2009				
	SCALE: 1" = 40'				
DRAWING NO.	13				
	BARBARA L. HERRING, PSM #6194				