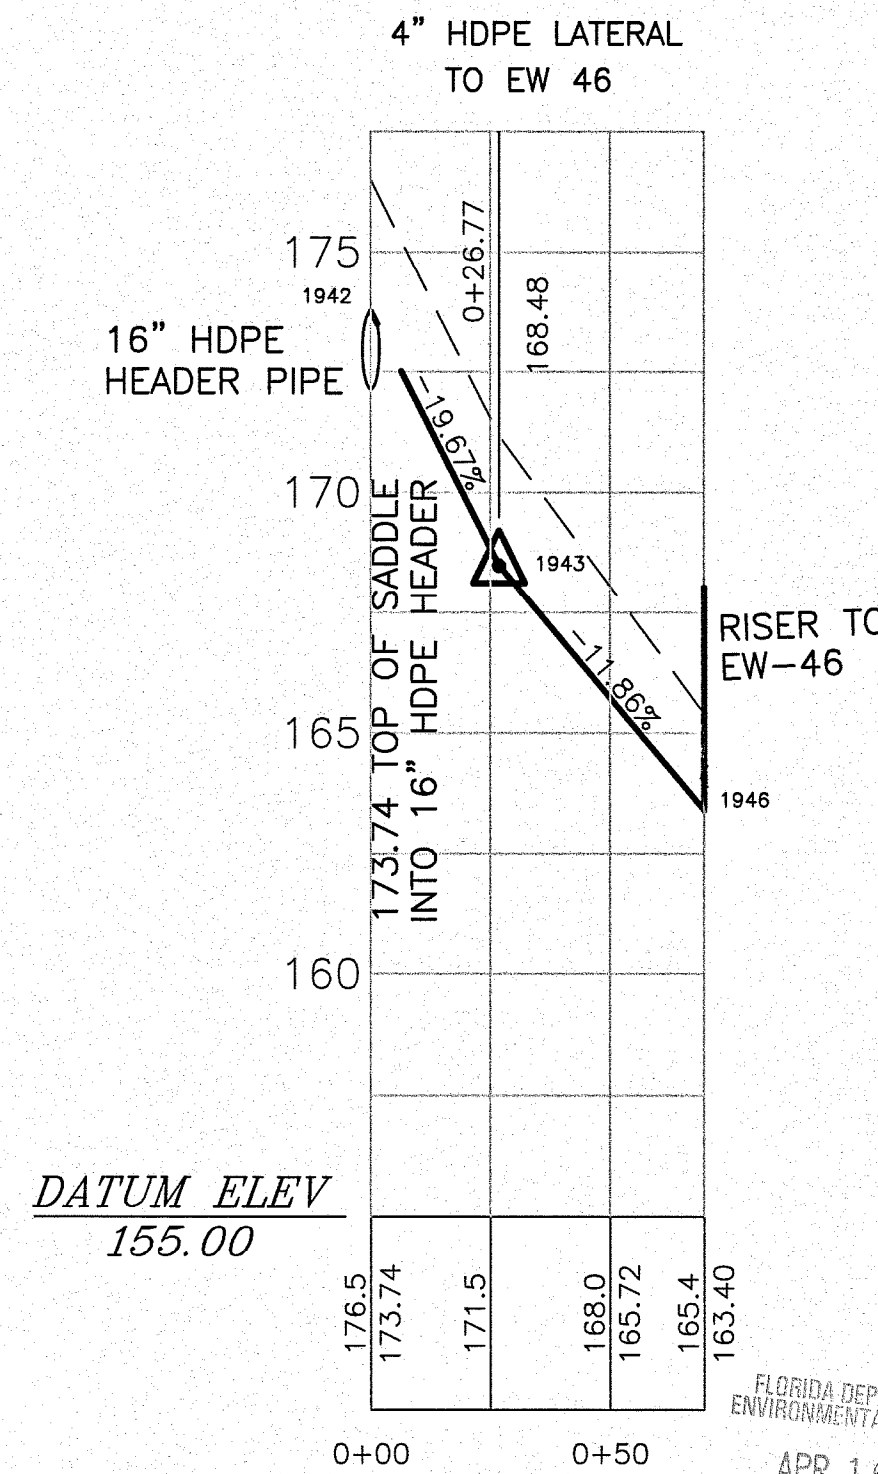
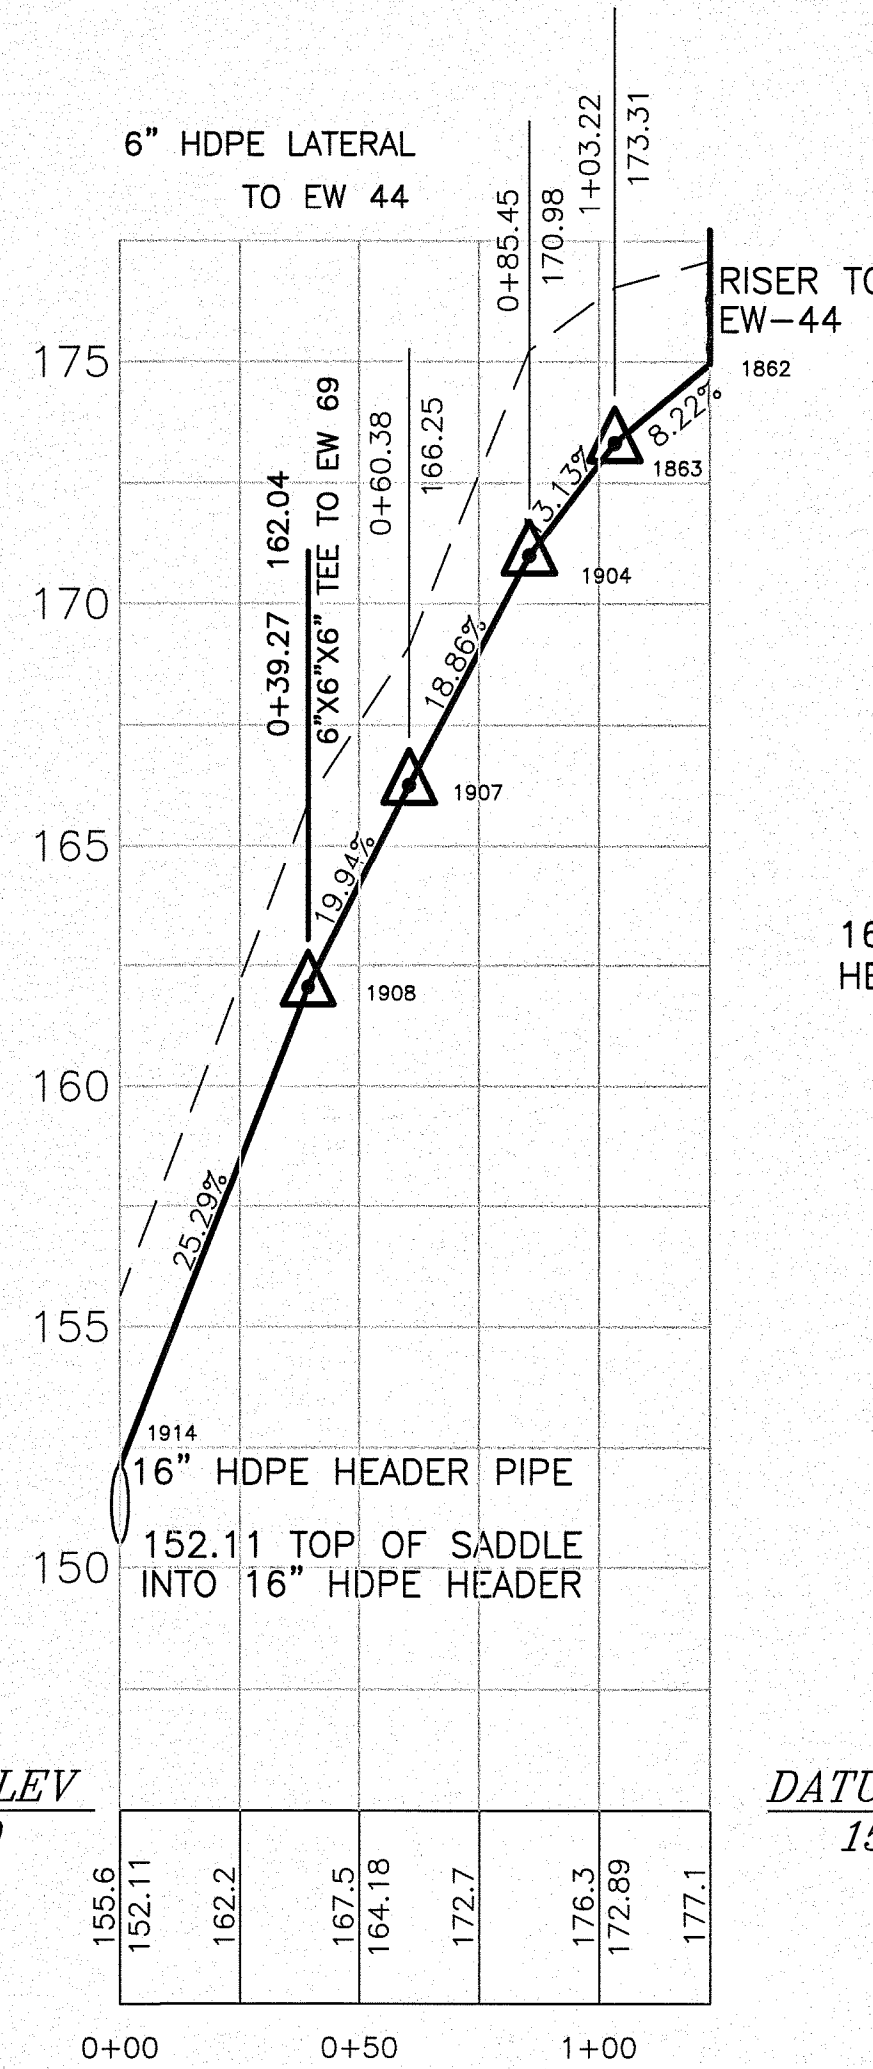
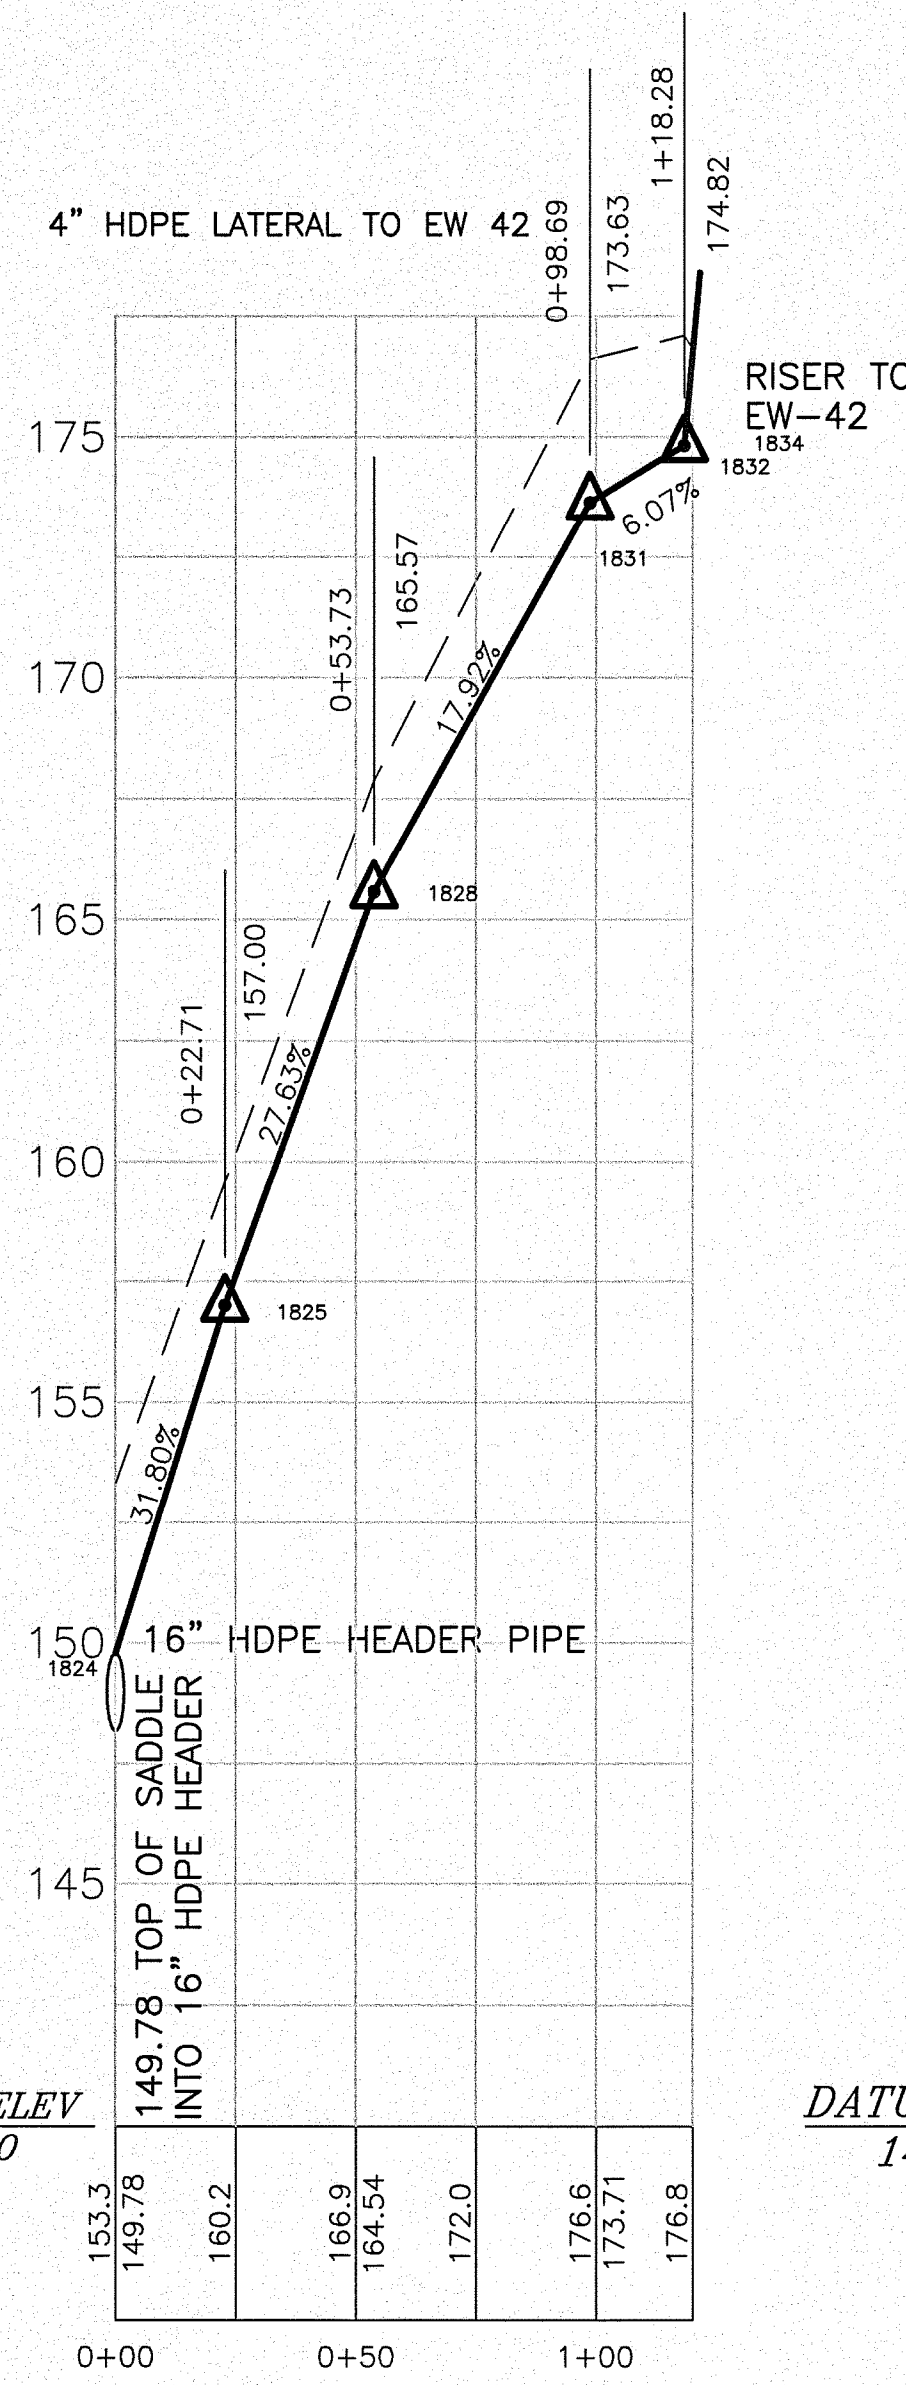
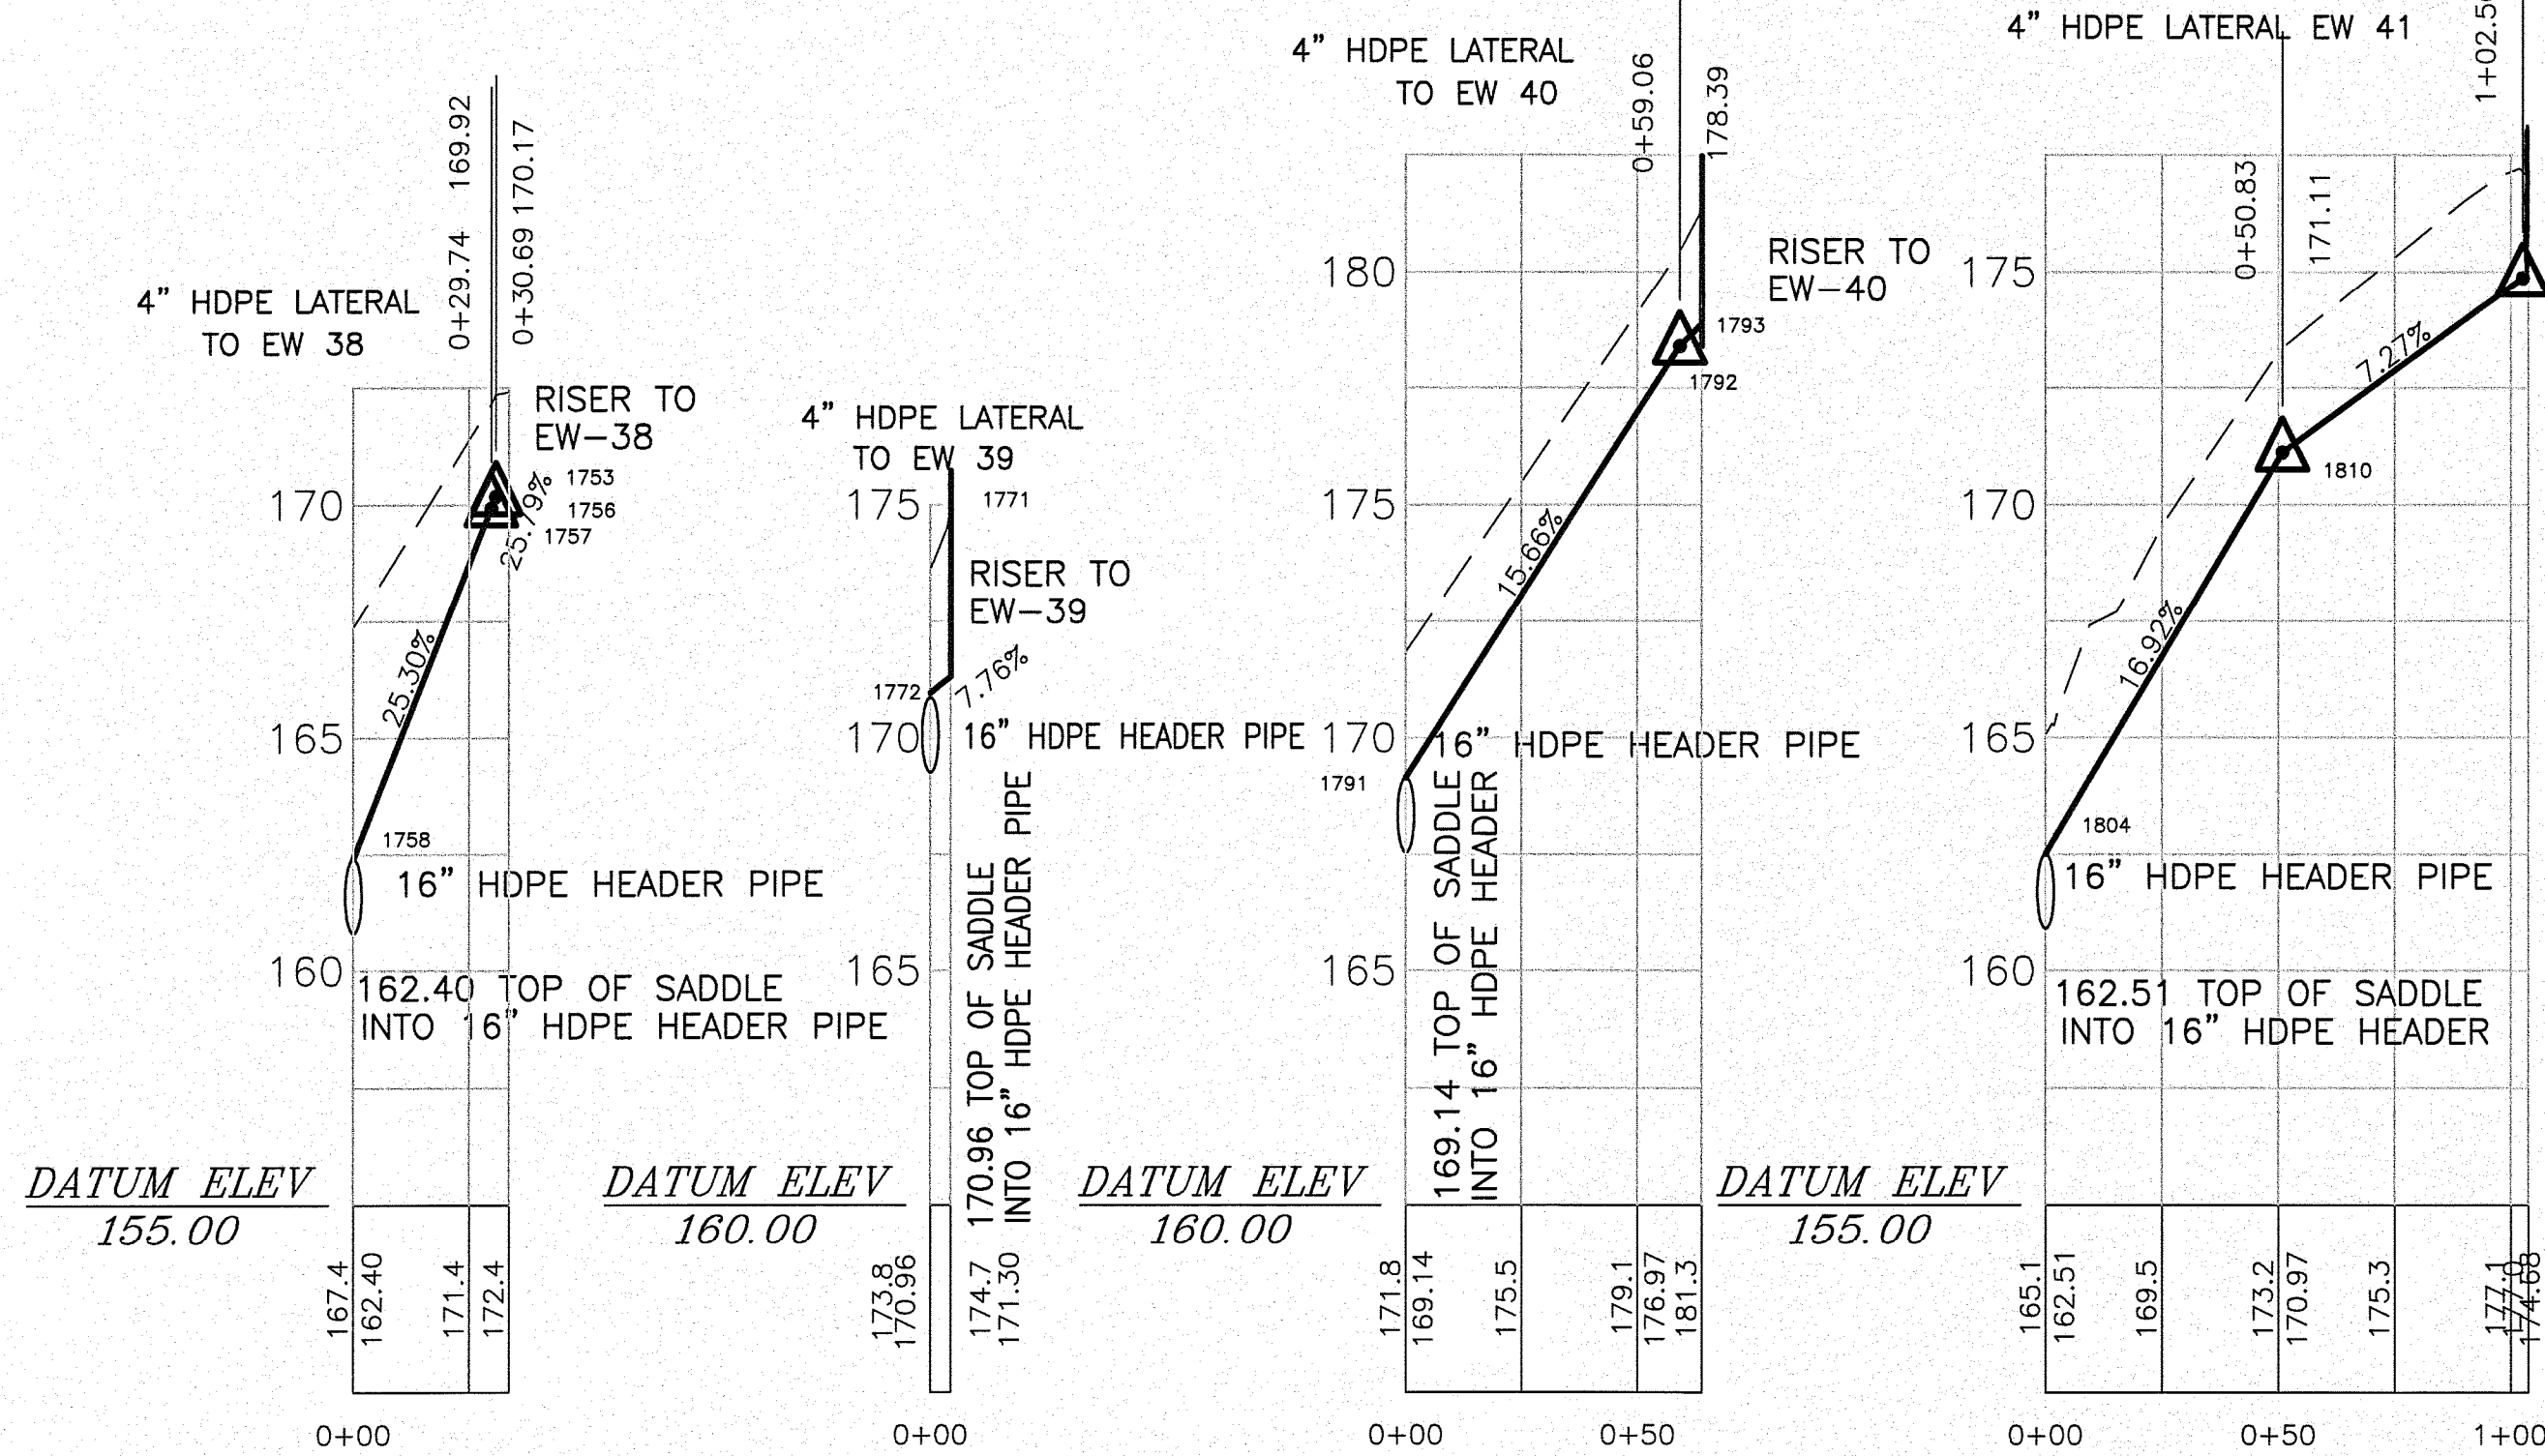


CONTRACTOR
**SOUTHEAST ENIRONMENTAL
CONTRACTING, INC.**
5667 VAL DEL ROAD, HAHIRA, GA 31832
229-794-3330 FAX 229-794-3332

DESIGN ENGINEER
SCS ENGINEERS
STEARN, CONRAD AND SCHMIDT
CONSULTING ENGINEERS
4041 PARK OAKS BLVD., SUITE 100, TAMPA, FL 33610
813 621-0080 FAX 813 623-6757
FLORIDA CERTIFICATE OF AUTHORIZATION NO. 00004892

Barbara L. Herring
BARBARA L. HERRING, PSM #6184
DATE: 12-16-09

SOUTHEASTERN SURVEYING, INC. 601 N. ST. AUGUSTINE RD. VALDOSTA, GA 31601 229-259-9465 FAX 229-259-9926 FLORIDA CERTIFICATE OF AUTHORIZATION NO. 00007091		CLIENT		DRAWING TITLE		REV	DATE	DESCRIPTION	BY	BARBARA L. HERRING, RLS LICENSE NO. 6194
CADD FILE: PROFILE 40 SCALE		HILLSBOROUGH COUNTY SOLID WASTE MANAGEMENT DEPARTMENT TAMPA, FLORIDA		PIPE PROFILES						
DATE: DECEMBER 16, 2009		PROJECT TITLE		SOUTHEAST COUNTY LANDFILL LANDFILL GAS COLLECTION AND CONTROL SYSTEM PROJECT		△				
SCALE: 1" = 40'		PROJ. NO. 09207055.00				△				
DRAWING NO.		DWN. BY: BLH				△				
		CHK BY: BLH				△				
		APP. BY:				△				
		BLH				△				
						△				
						△				