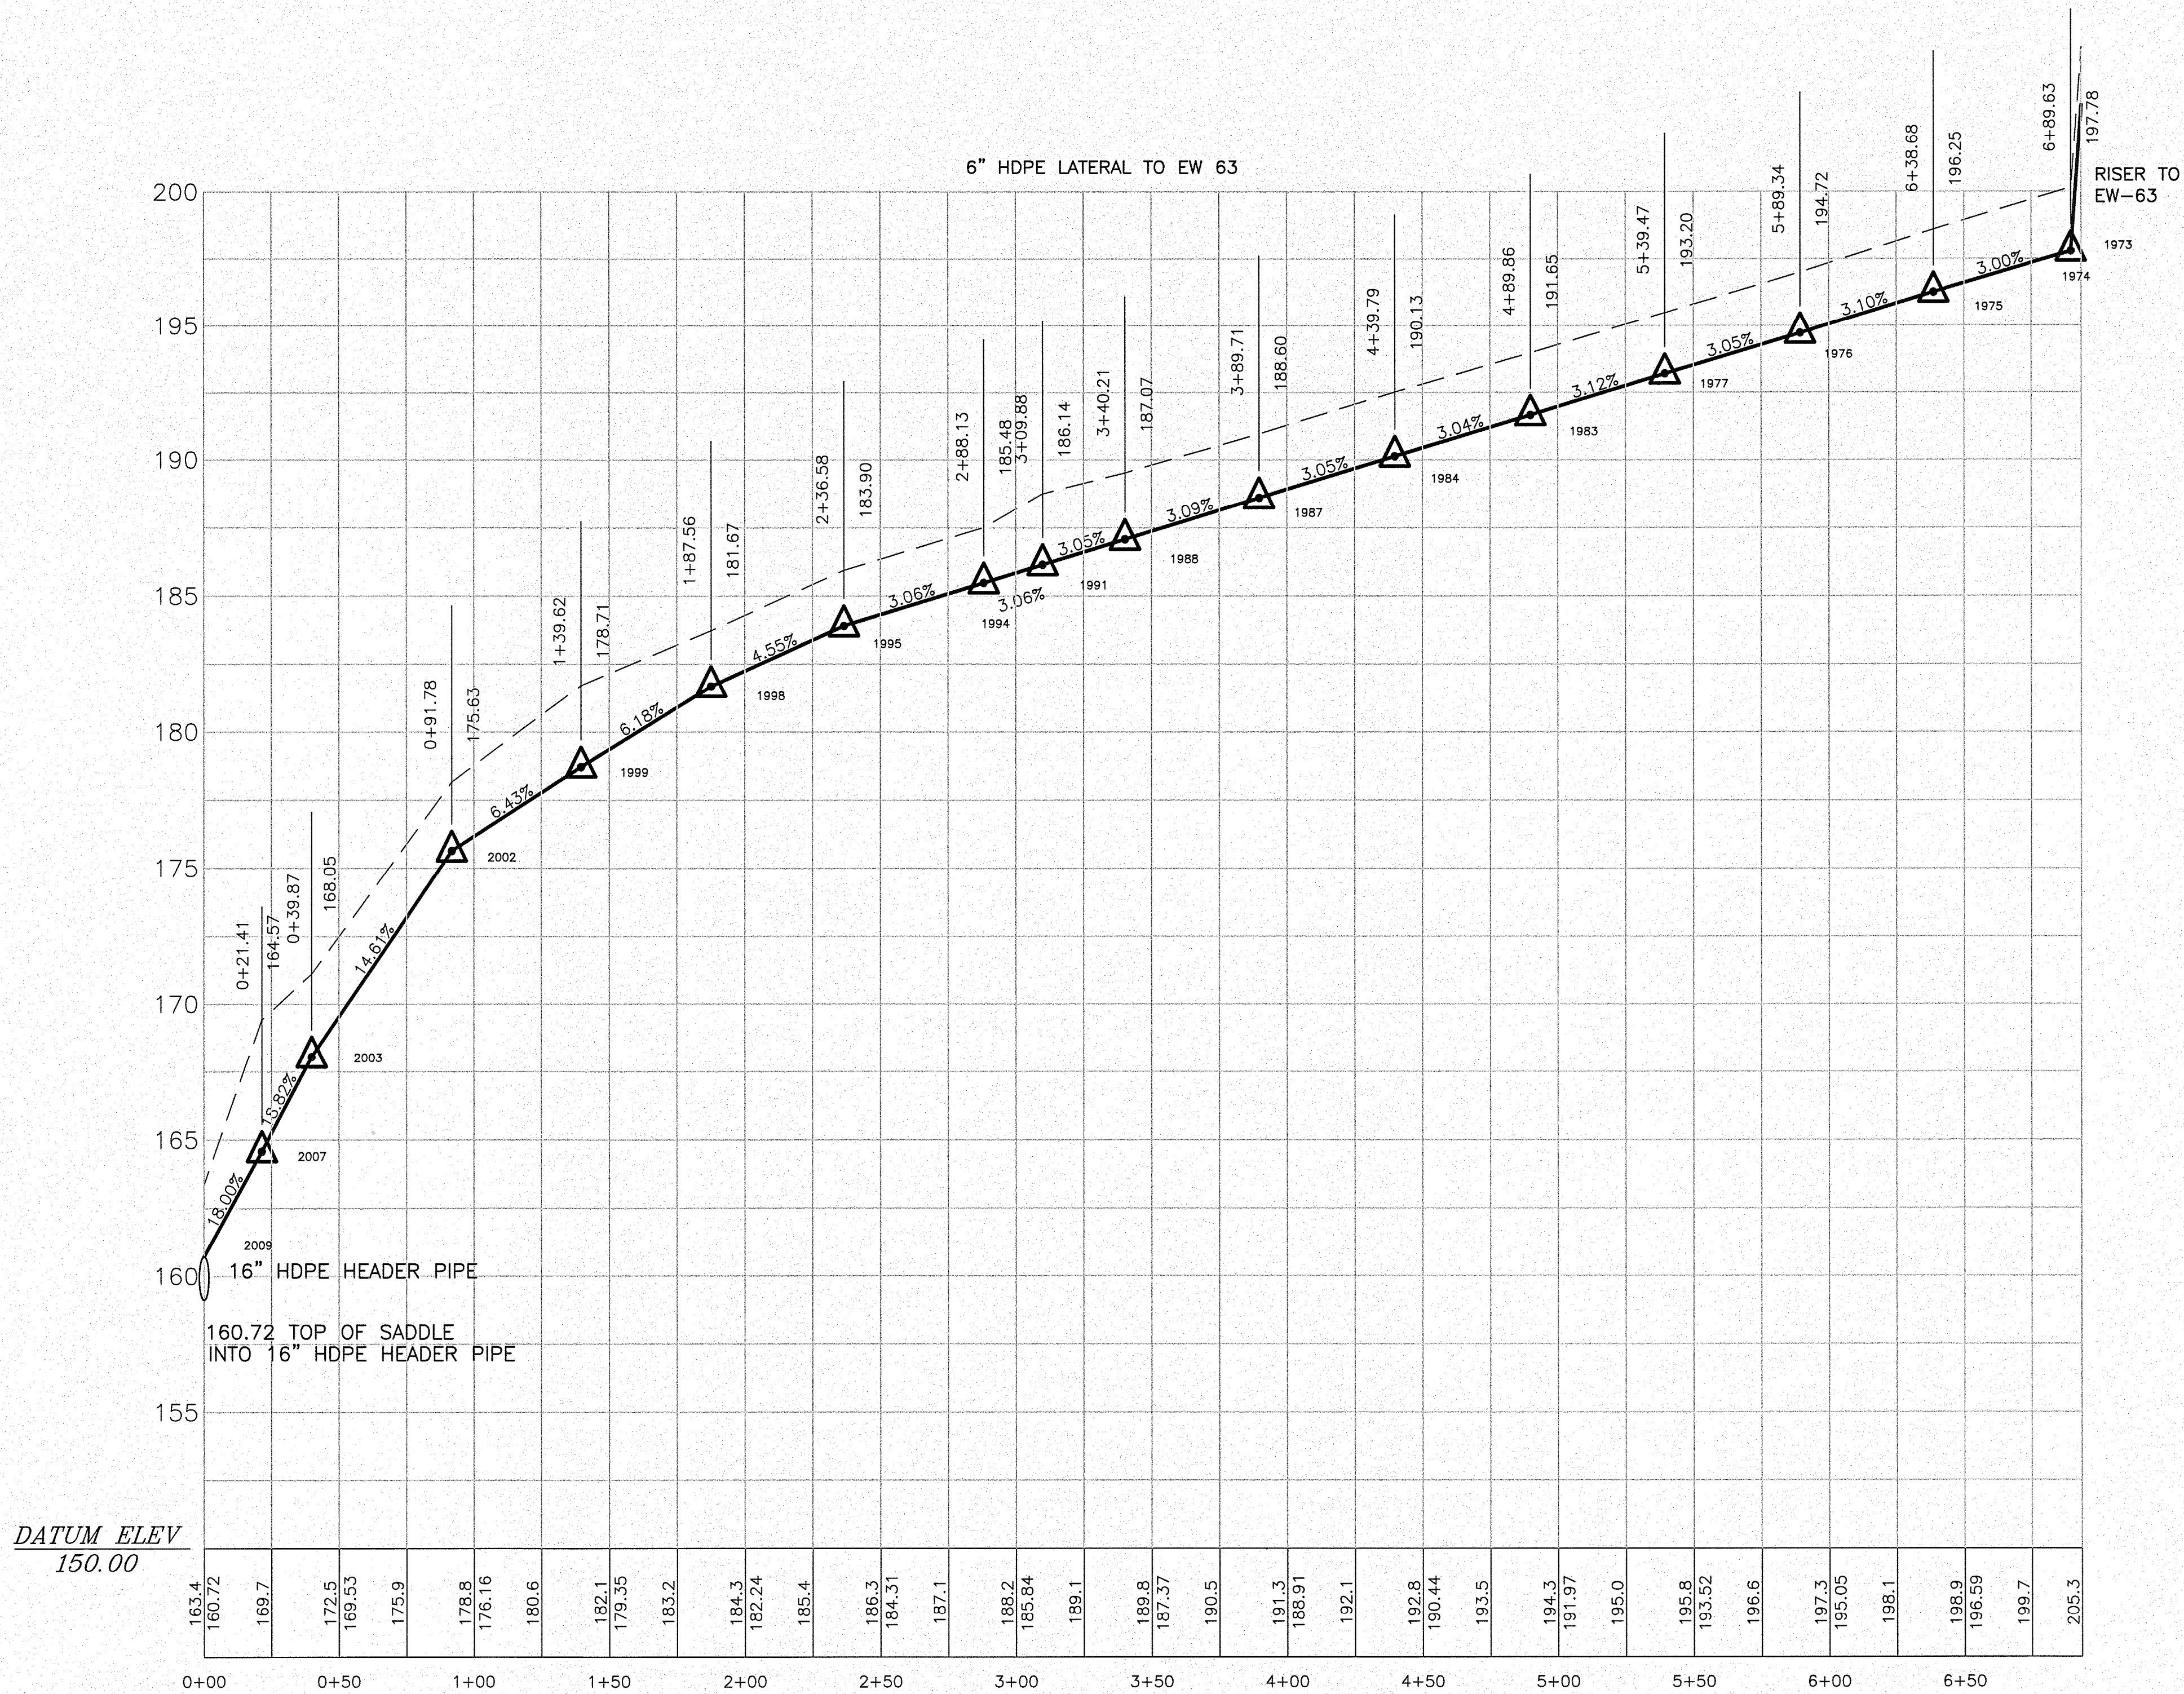


CONTRACTOR  
**SOUTHEAST ENIRONMENTAL  
CONTRACTING, INC.**  
5667 VAL DEL ROAD, HAHIRA, GA 31632  
228-794-3330 FAX 228-794-3332

DESIGN ENGINEER  
**SCS ENGINEERS**  
STEARNS, CONRAD AND SCHMIDT  
CONSULTING ENGINEERS  
4041 PARK OAKS BLVD., SUITE 100, TAMPA, FL 33610  
813 821-0080 FAX 813 823-6757  
FLORIDA CERTIFICATE OF AUTHORIZATION NO. 00004892

|   |                                |  |                            |  |                    |  |                              |  |                                                                               |                                                                                    |  |     |  |      |             |    |  |  |
|---|--------------------------------|--|----------------------------|--|--------------------|--|------------------------------|--|-------------------------------------------------------------------------------|------------------------------------------------------------------------------------|--|-----|--|------|-------------|----|--|--|
| <div>SOUTHEASTERN<br/>SURVEYING, INC.</div> <div>601 N. ST. AUGUSTINE RD., VALDOSTA, GA 31601</div> <div>228-259-9465 FAX 228-259-9626</div> <div>FLORIDA CERTIFICATE OF AUTHORIZATION NO. 00007091</div> | CADD FILE:<br>PROFILE 40 SCALE |  | DATE:<br>DECEMBER 16, 2009 |  | SCALE:<br>1" = 40' |  | DRAWING NO.<br><div>18</div> |  | CLIENT                                                                        | DRAWING TITLE                                                                      |  | REV |  | DATE | DESCRIPTION | BY |  |  |
|   |                                |  |                            |  |                    |  |                              |  | HILLSBOROUGH COUNTY<br>SOLID WASTE<br>MANAGEMENT DEPARTMENT<br>TAMPA, FLORIDA | PIPE PROFILES                                                                      |  |     |  |      |             |    |  |  |
|   |                                |  |                            |  |                    |  |                              |  |                                                                               | PROJECT TITLE                                                                      |  |     |  |      |             |    |  |  |
|   |                                |  |                            |  |                    |  |                              |  |                                                                               | SOUTHEAST COUNTY LANDFILL<br>LANDFILL GAS COLLECTION<br>AND CONTROL SYSTEM PROJECT |  |     |  |      |             |    |  |  |
|   |                                |  |                            |  |                    |  |                              |  |                                                                               |                                                                                    |  |     |  |      |             |    |  |  |
|   | PROJ. NO.<br>09207055.00       |  | DWN. BY:<br>BLH            |  | CHK. BY:<br>BLH    |  | APP. BY:<br>BLH              |  |                                                                               |                                                                                    |  |     |  |      |             |    |  |  |
|   | S/A R/W BY:                    |  |                            |  |                    |  |                              |  |                                                                               |                                                                                    |  |     |  |      |             |    |  |  |
|   |                                |  |                            |  |                    |  |                              |  |                                                                               |                                                                                    |  |     |  |      |             |    |  |  |
