



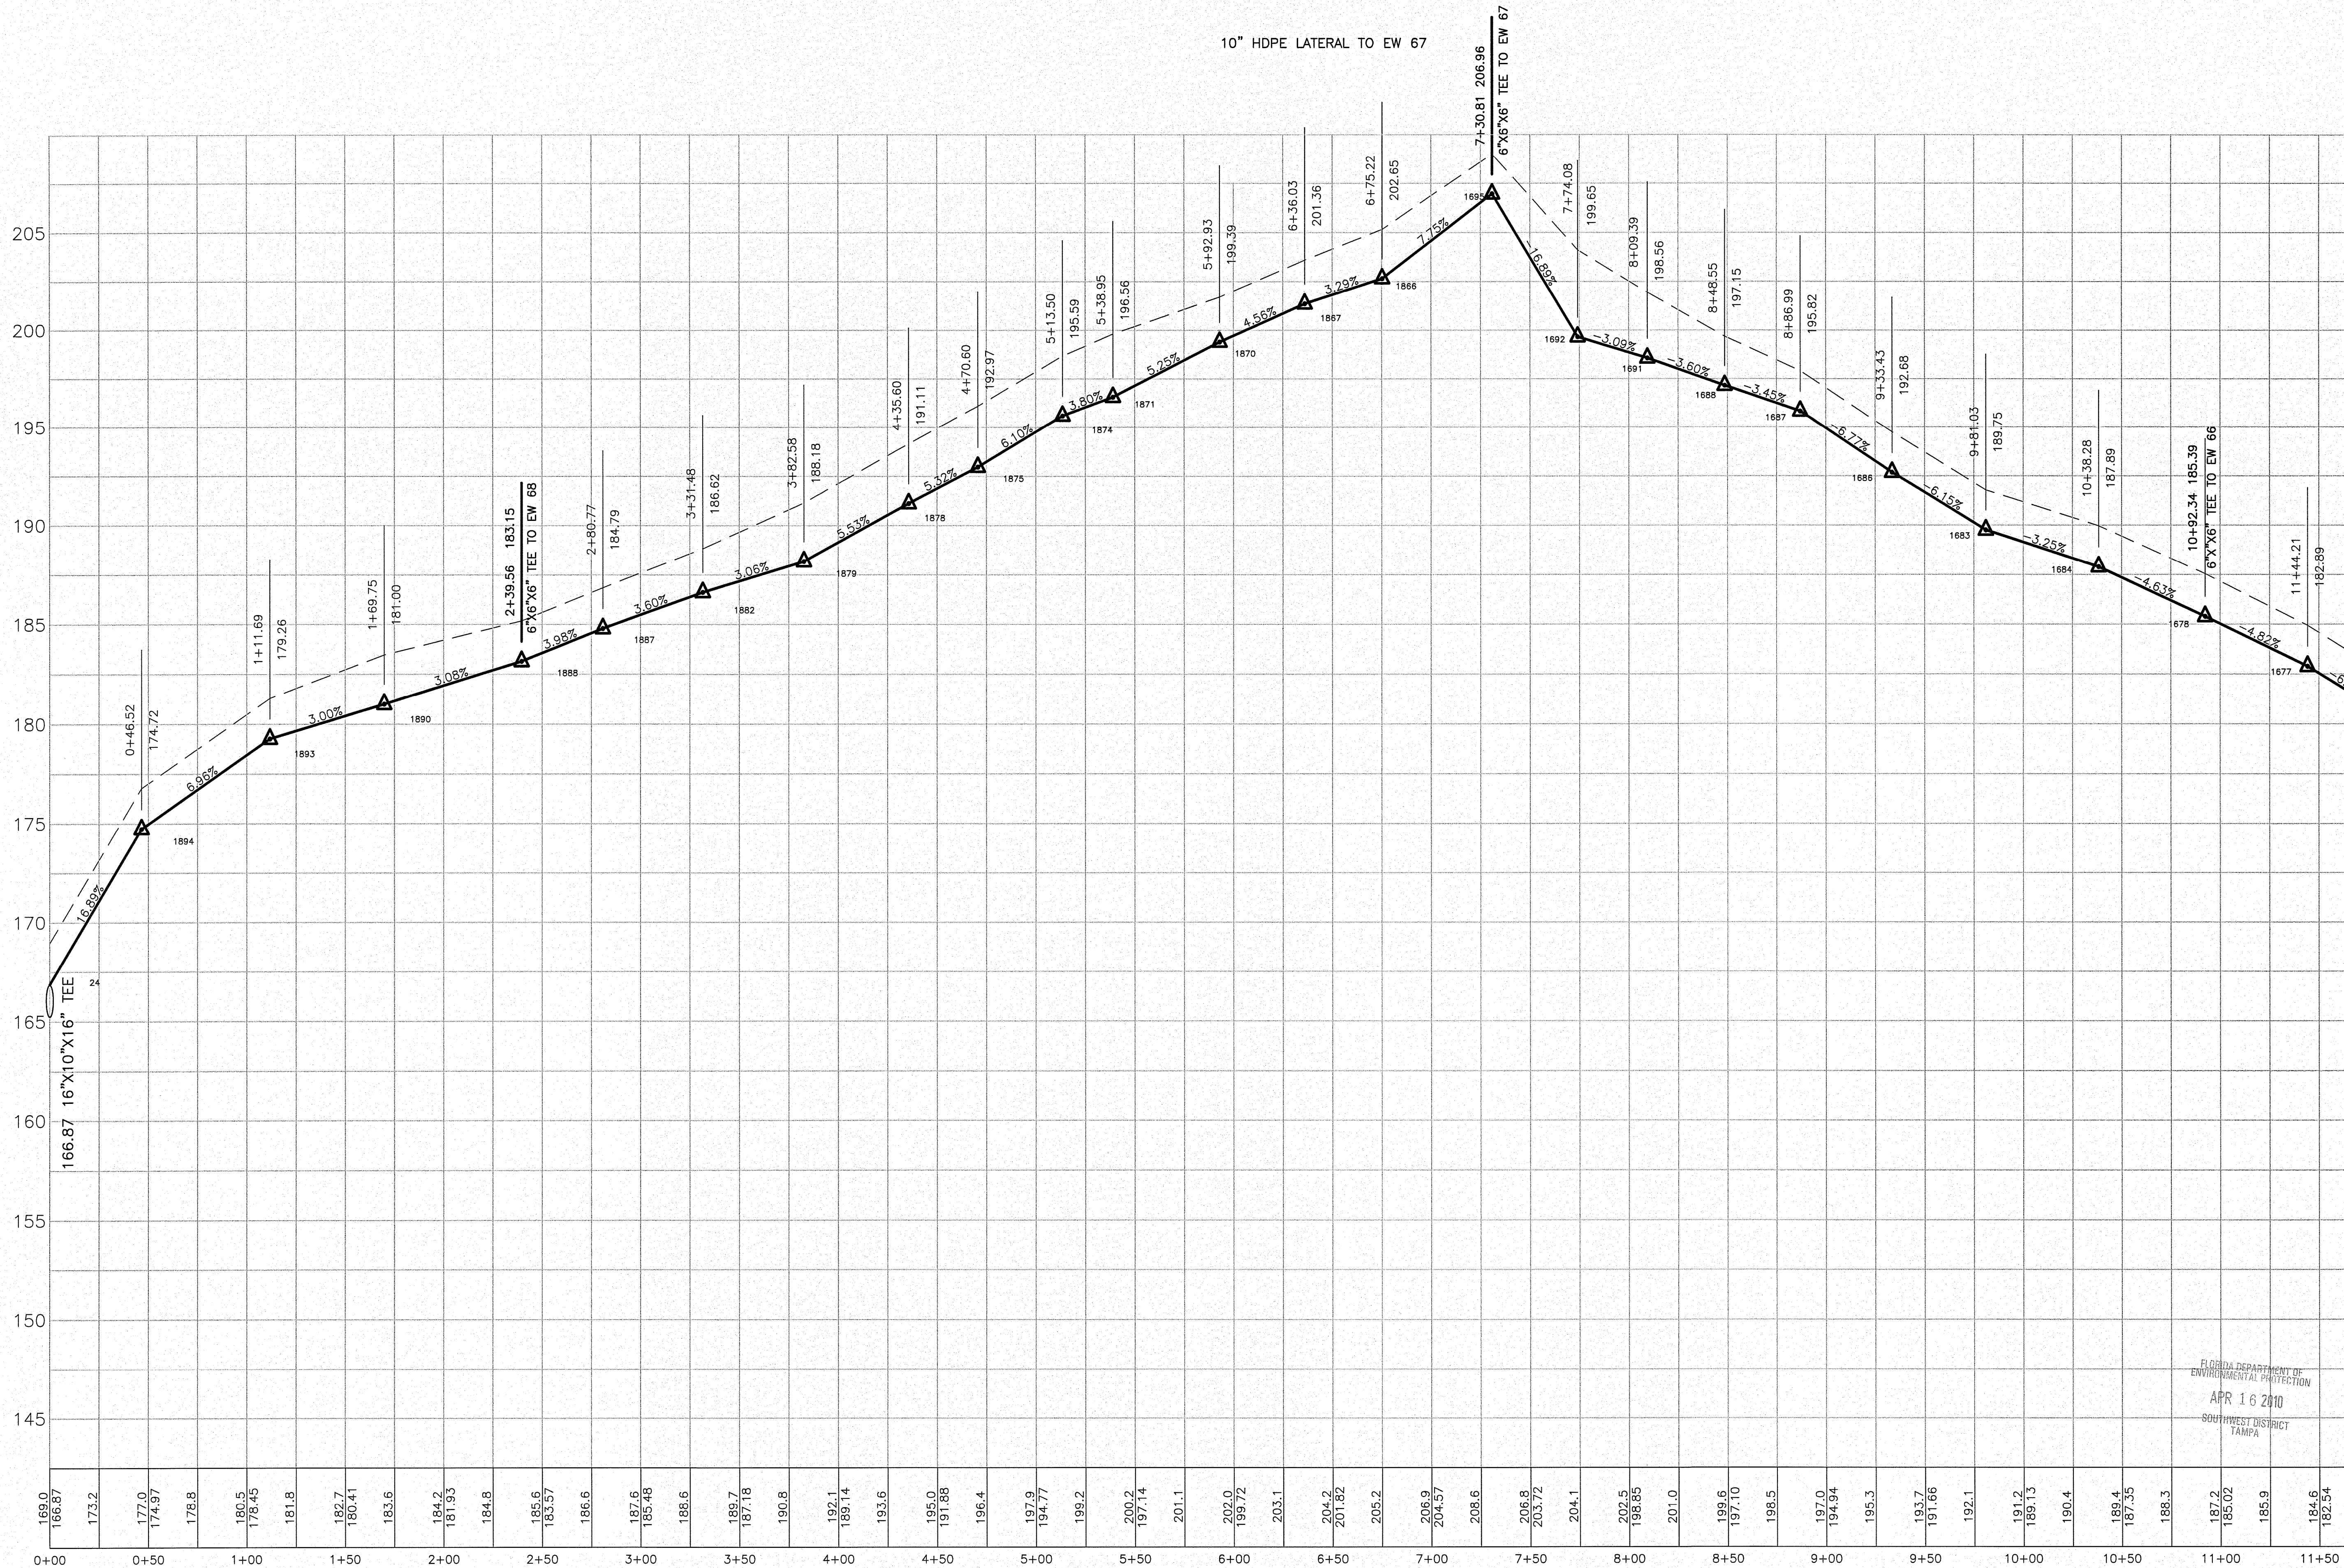

Barbara L. Herring
BARBARA L. HERRING, P.E.
DATE: 12-16-09

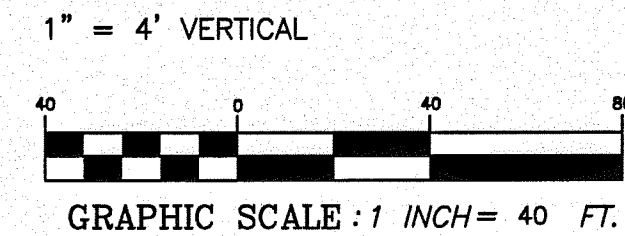

CONTRACTOR
**SOUTHEAST ENIRONMENTAL
CONTRACTING, INC.**
6867 VAL DEL ROAD, HAHIRA, GA 31612
229-794-3330 FAX 229-794-3332

DESIGN ENGINEER
SCS ENGINEERS
STEARNS, CONRAD AND SCHMIDT
CONSULTING ENGINEERS
4041 PARK OAKS BLVD., SUITE 100, TAMPA, FL 33610
813 621-0080 FAX 813 623-6757
FLORIDA CERTIFICATE OF AUTHORIZATION NO. 00004892

FLORIDA DEPARTMENT OF
ENVIRONMENTAL PROTECTION
APR 16 2010
SOUTHWEST DISTRICT
TAMPA

SOUTHEASTERN SURVEYING, INC. 601 N. ST. AUGUSTINE RD., VALDOSTA, GA 31601 229-259-9465 FAX 229-259-9626 FLORIDA CERTIFICATE OF AUTHORIZATION NO. 0007091		HILLSBOROUGH COUNTY SOLID WASTE MANAGEMENT DEPARTMENT TAMPA, FLORIDA		CLIENT	
CADD FILE: PROFILE 40 SCALE		PIPE PROFILES		DRAWING TITLE	
DATE: DECEMBER 16, 2009		PROJECT TITLE		SOUTHEAST COUNTY LANDFILL LANDFILL GAS COLLECTION AND CONTROL SYSTEM PROJECT	
SCALE: 1" = 40'		REV		DATE	
DRAWING NO. 20		DESCRIPTION		BY	
				BARBARA L. HERRING, P.E. LICENSE NO. 6194	