




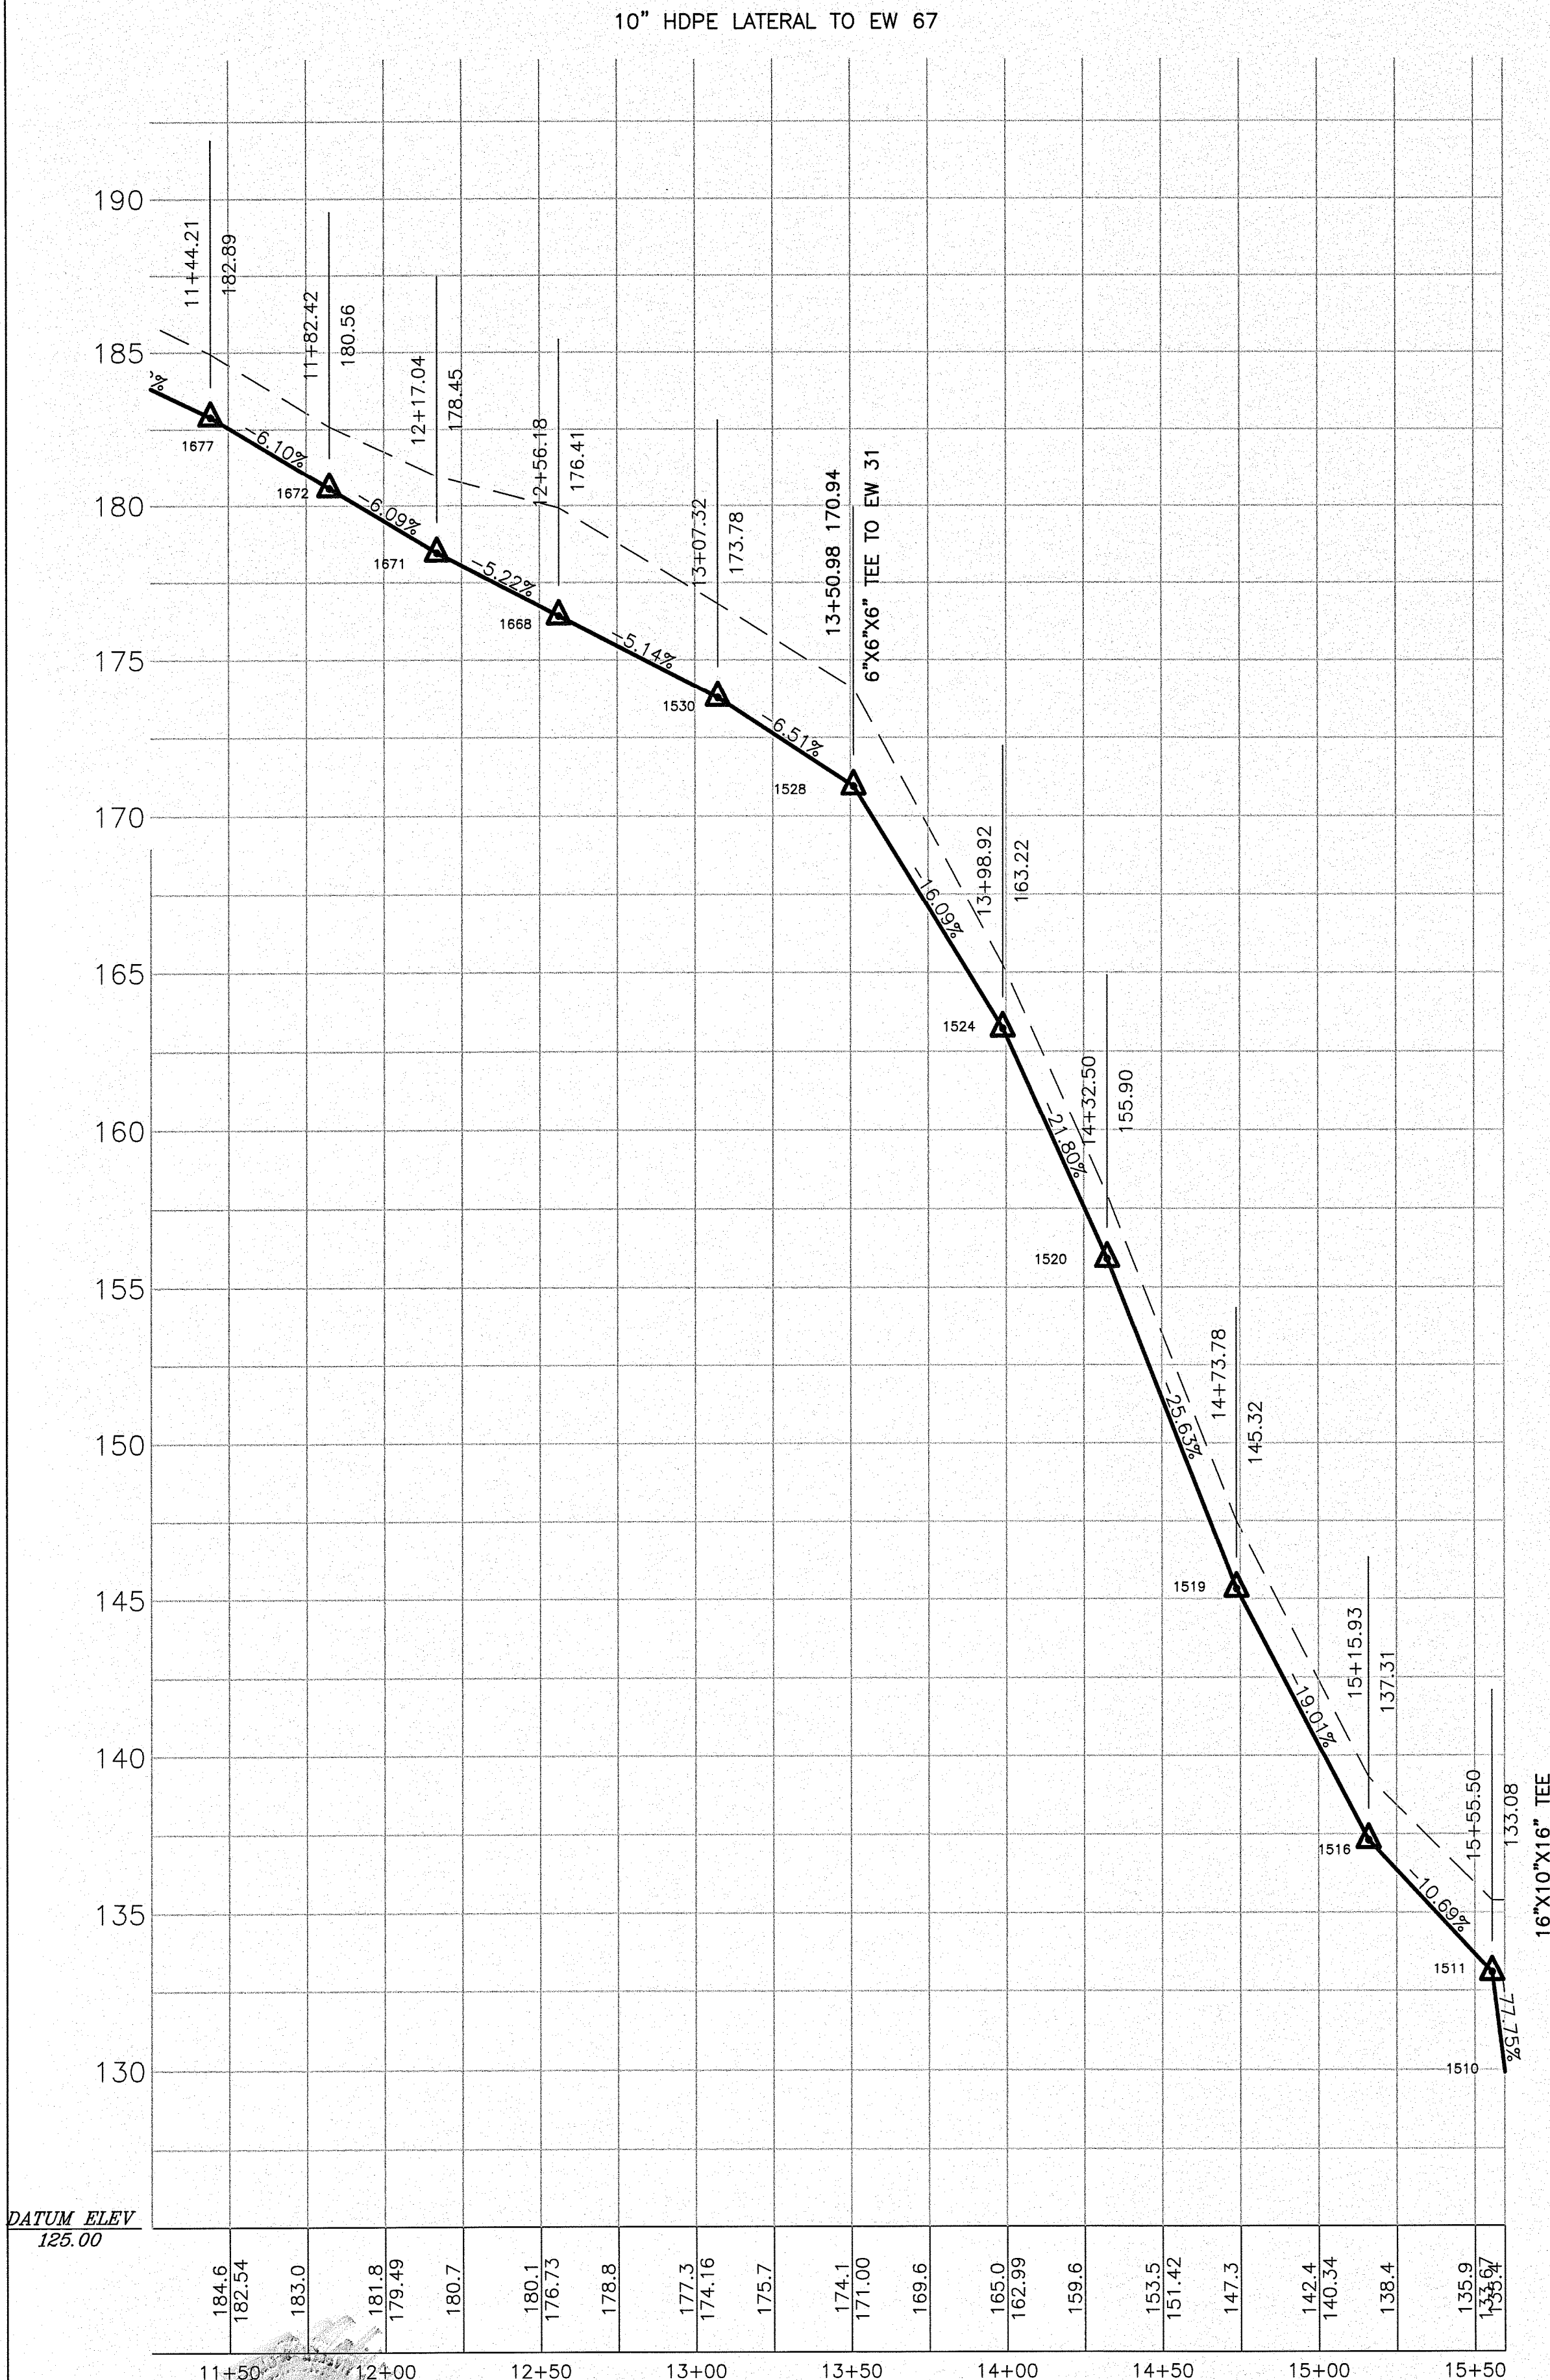

Barbara L. Herring
BARBARA L. HERRING, PSM #6194
DATE: 12-16-09

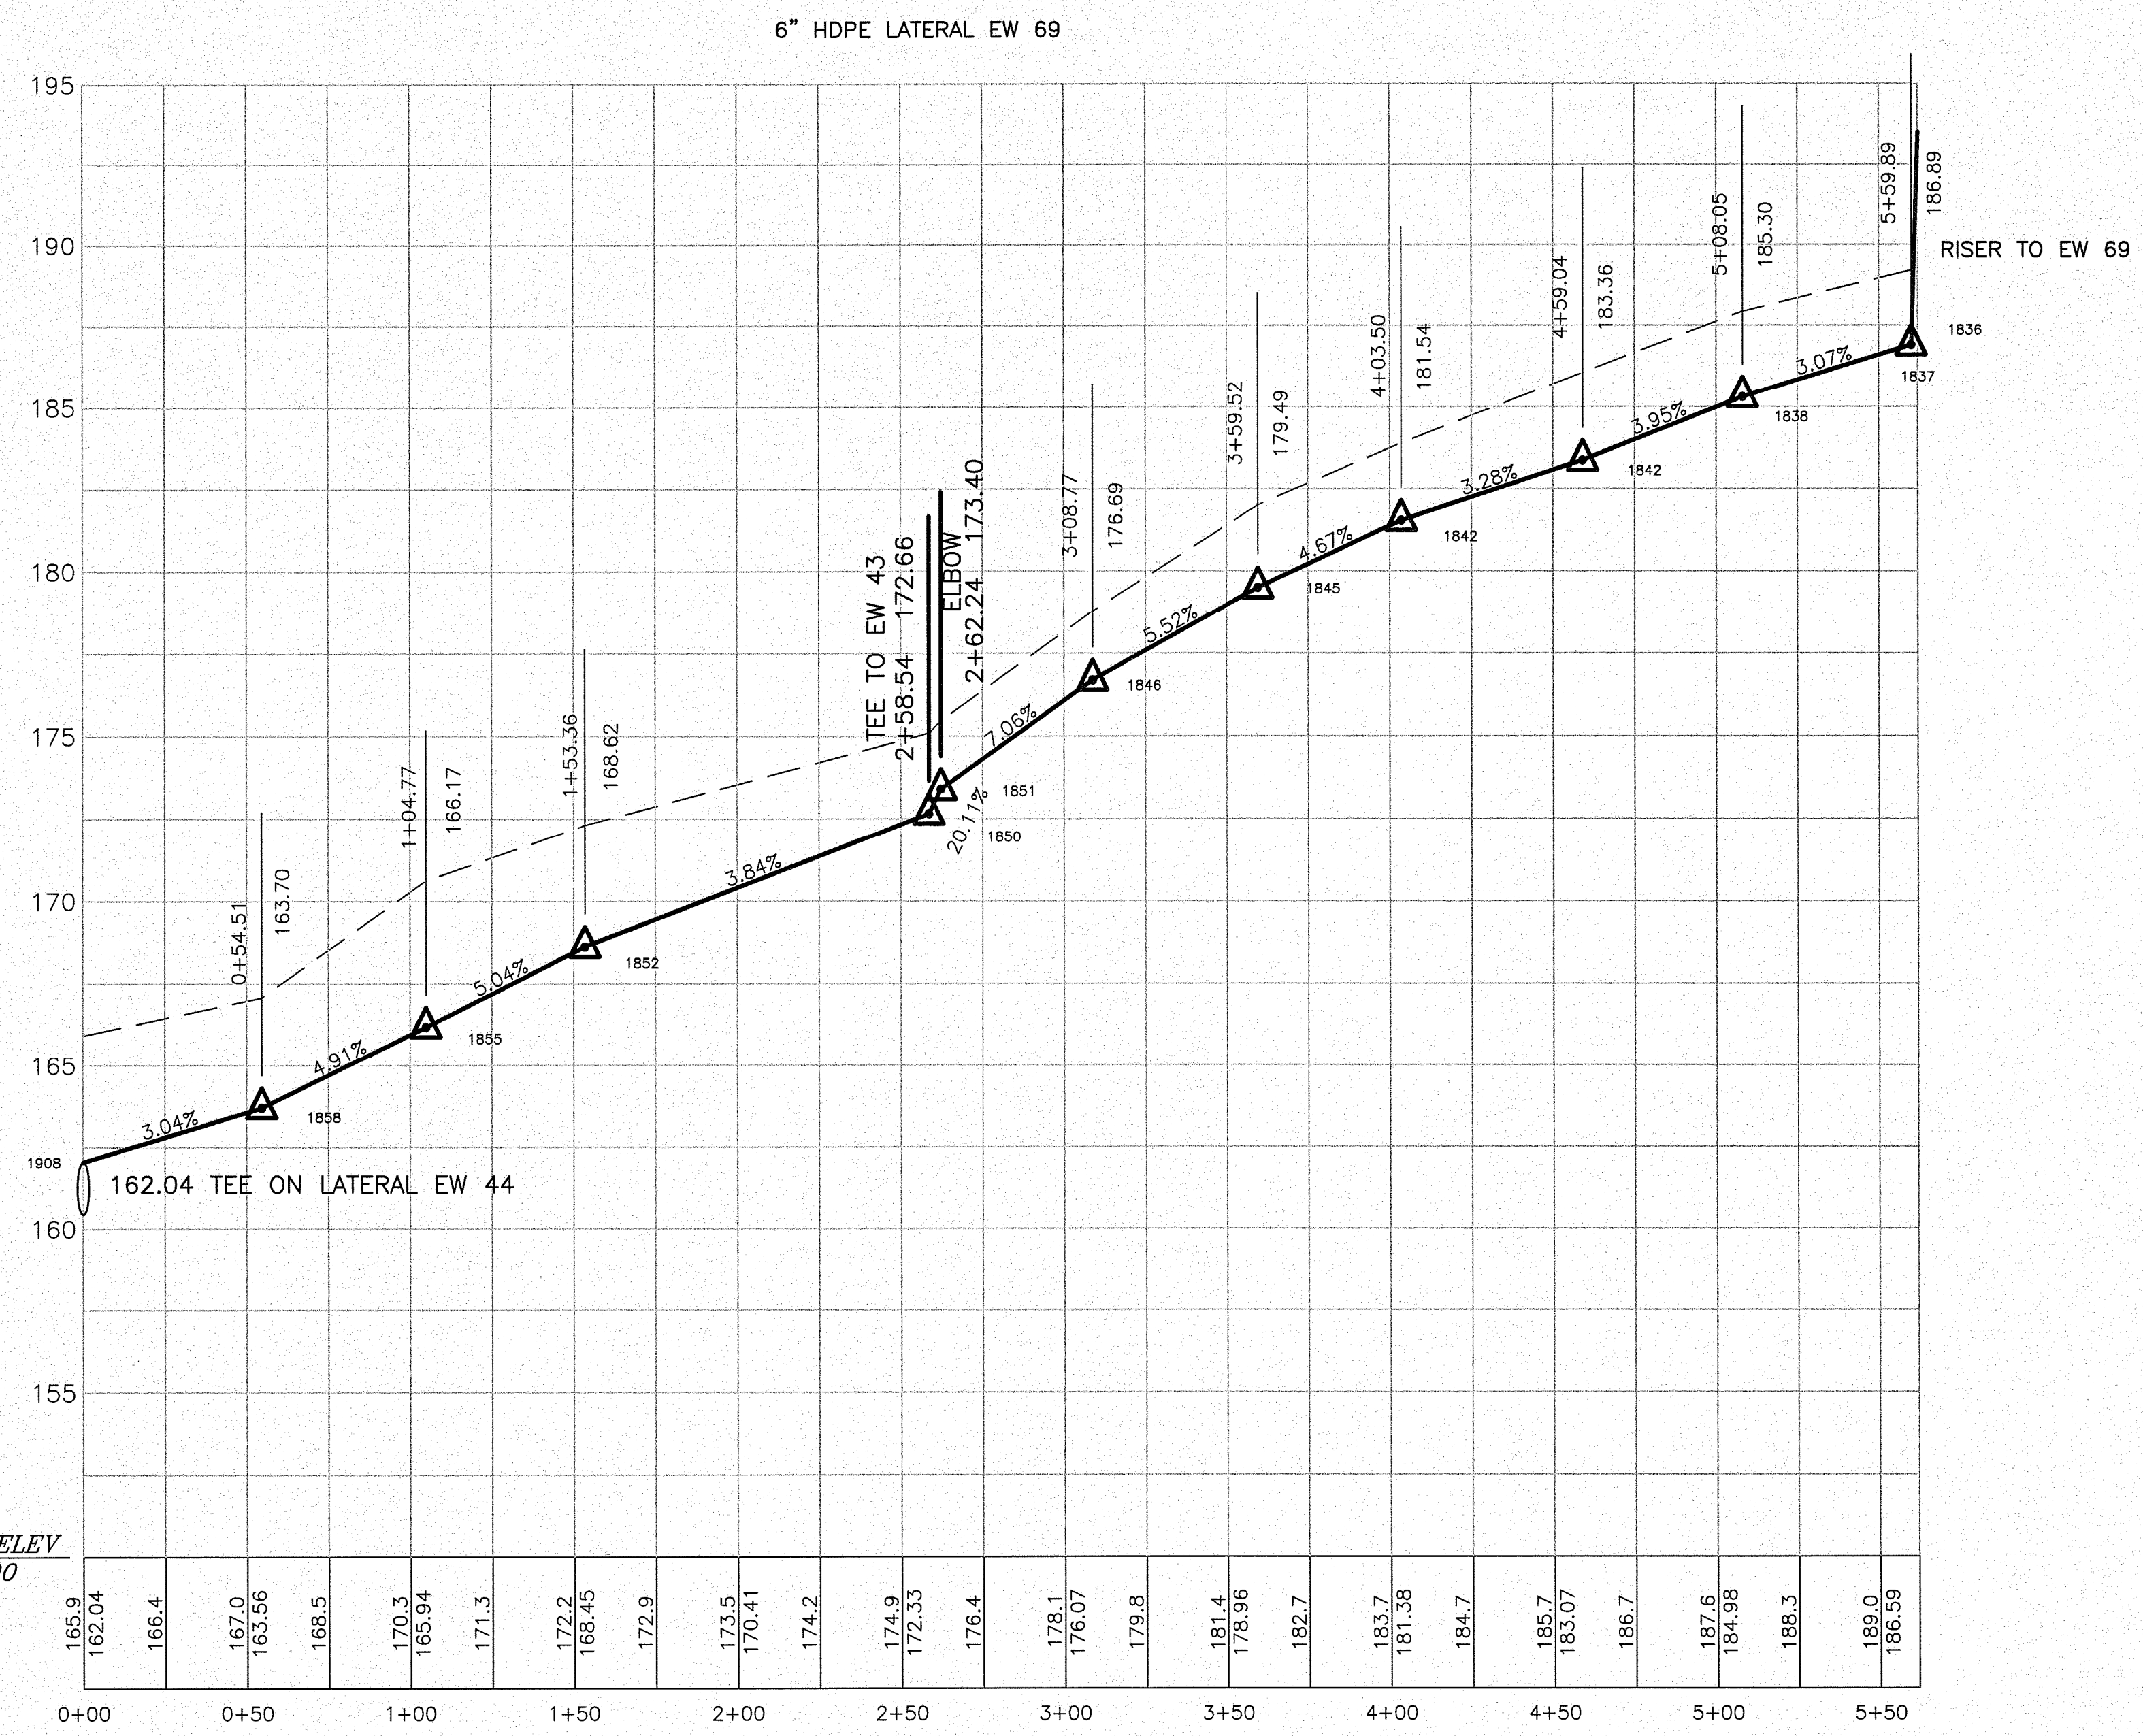

CONTRACTOR
**SOUTHEAST ENIRONMENTAL
CONTRACTING, INC.**
5667 VAL DEL ROAD, MAHIRA, GA 31832
229-794-3330 FAX 229-794-3332

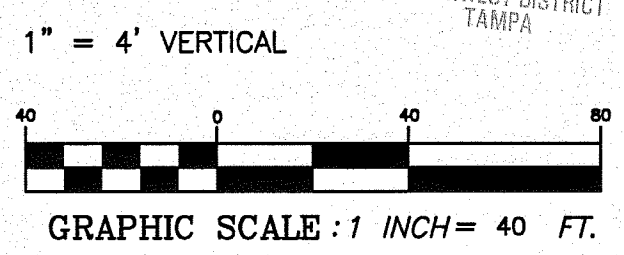

DESIGN ENGINEER
SCS ENGINEERS
STEARNS, CONRAD AND SCHMIDT
CONSULTING ENGINEERS
4041 PARK OAKS BLVD., SUITE 100, TAMPA, FL 33610
813 821-0080 FAX 813 823-6757
FLORIDA CERTIFICATE OF AUTHORIZATION NO. 00004892

DRAWING NO. 21	SCALE: 1" = 40'		DATE: DECEMBER 16, 2009		CADD FILE: PROFILE 40 SCALE		SOUTHEASTERN SURVEYING, INC. 801 N. ST. AUGUSTINE RD., VALDOSTA, GA 31601 229-258-9455 FAX 229-258-9926 FLORIDA CERTIFICATE OF AUTHORIZATION NO. 00007091 PROJ. NO. 09207055.00 DWN. BY: BLH CHK. BY: BLH TDR. BY: BLH C/A R/W BY: APP. BY:		CLIENT HILLSBOROUGH COUNTY SOLID WASTE MANAGEMENT DEPARTMENT TAMPA, FLORIDA	DRAWING TITLE PIPE PROFILES PROJECT TITLE SOUTHEAST COUNTY LANDFILL LANDFILL GAS COLLECTION AND CONTROL SYSTEM PROJECT		REV △ △ △ △ △ △ △ △ △ △	DATE	DESCRIPTION	BY