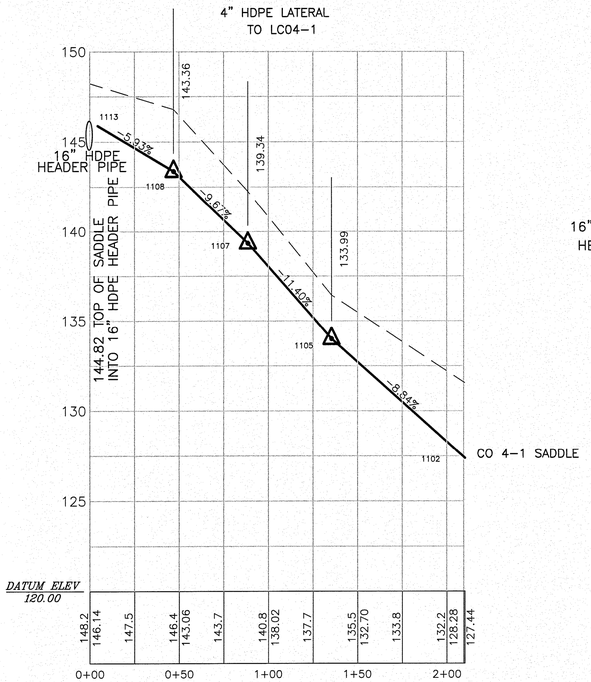


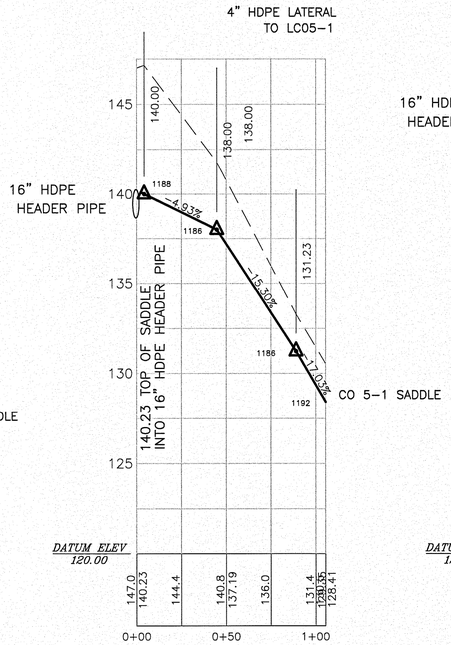


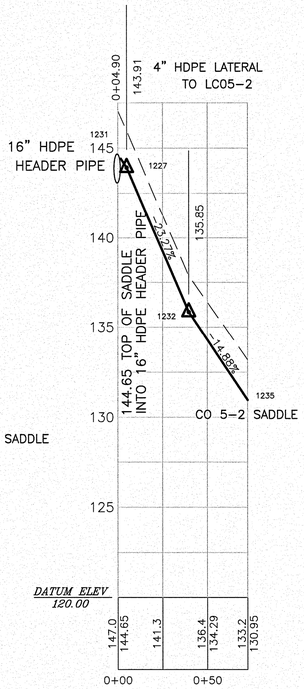


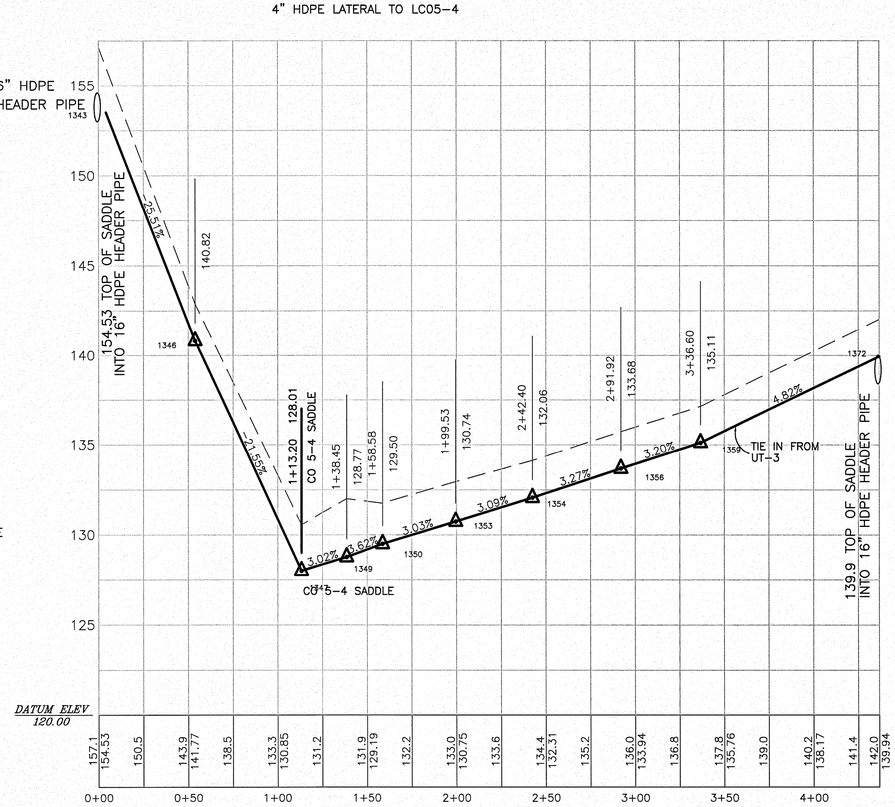


FLORIDA DEPARTMENT OF ENVIRONMENTAL PROTECTION
APR 16 2010
SOUTHWEST DISTRICT TAMPA

1" = 4' VERTICAL

GRAPHIC SCALE : 1 INCH = 40 FT.

Barbara L. Herring
BARBARA L. HERRING, PSM #6194
DATE: 12-16-09

CONTRACTOR
**SOUTHEAST ENIRONMENTAL CONTRACTING, INC.**
5667 VAL DEL ROAD, HAHIRA, GA 31632
229-794-3330 FAX 229-794-3332

DESIGN ENGINEER
**SCS ENGINEERS**
STEARNS, CONRAD AND SCHMIDT CONSULTING ENGINEERS
4041 PARK OAKS BLVD., SUITE 100, TAMPA, FL 33610
813 621-0080 FAX 813 623-6757
FLORIDA CERTIFICATE OF AUTHORIZATION NO. 00004892

| REV | DATE | DESCRIPTION | BY |
|---|---|---|---|
| | | | |

BARBARA L.HERRING, RLS
LICENSE NO. 6194

DRAWING TITLE
**PIPE PROFILES**

PROJECT TITLE
**SOUTHEAST COUNTY LANDFILL**
**LANDFILL GAS COLLECTION**
**AND CONTROL SYSTEM PROJECT**

CLIENT
**HILLSBOROUGH COUNTY**
**SOLID WASTE**
**MANAGEMENT DEPARTMENT**
**TAMPA, FLORIDA**

**SOUTHEASTERN SURVEYING, INC.**
801 N. ST. AUGUSTINE RD. VALDOSTA, GA 31601
229-259-9405 FAX 229-259-9928
FLORIDA CERTIFICATE OF AUTHORIZATION NO. 00007091

PROJ. NO. 09207055.00
DSN: BY: BLH
DWN. BY: BLH
CHK. BY: BLH
QA/QC RVW BY:
APP. BY:

CADD FILE: PROFILE 40 SCALE
DATE: DECEMBER 16, 2009
SCALE: 1" = 40'
DRAWING NO. **24**