


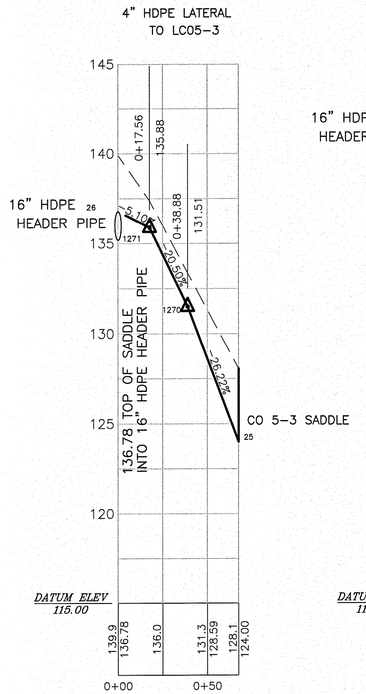


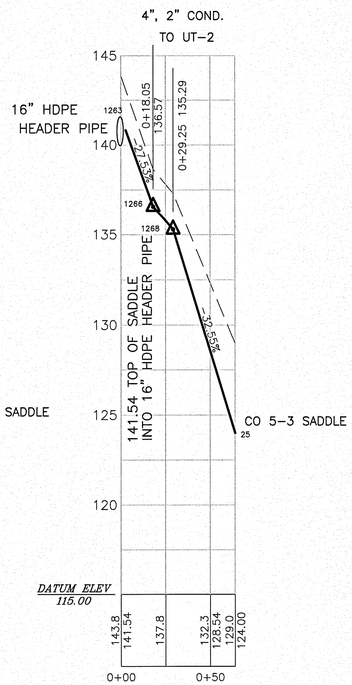

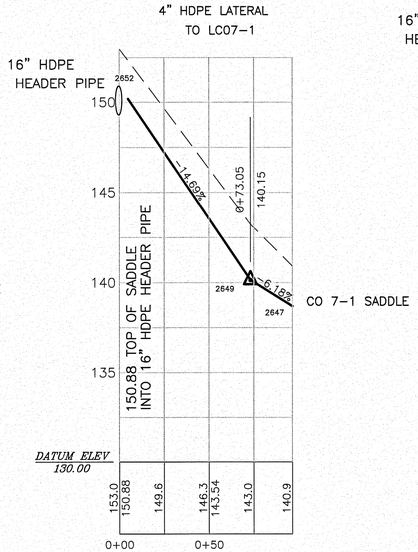

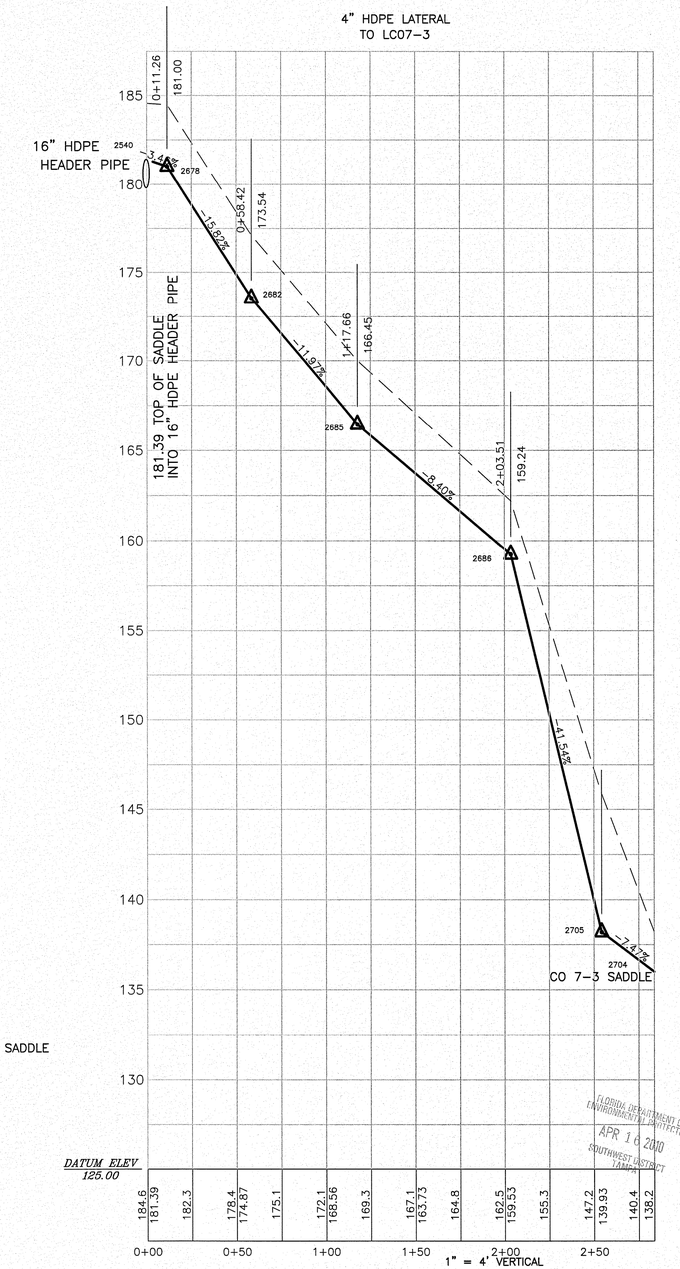

GRAPHIC SCALE : 1 INCH = 40 FT.

BARBARA L. HERRING, PSM #6194
DATE: 12-16-09

CONTRACTOR
SOUTHEAST ENIRONMENTAL CONTRACTING, INC.
5667 VAL DEL ROAD, HAHIRA, GA 31632
229-794-3330 FAX 229-794-3332

DESIGN ENGINEER
SCS ENGINEERS
STEARNS, CONRAD AND SCHMIDT
CONSULTING ENGINEERS
4041 PARK OAKS BLVD., SUITE 100, TAMPA, FL 33610
813 621-0080 FAX 813 623-6757
FLORIDA CERTIFICATE OF AUTHORIZATION NO. 00004892

REV	DATE	DESCRIPTION	BY

BARBARA L.HERRING, RLS
LICENSE NO. 6194

DRAWING TITLE
PIPE PROFILES

PROJECT TITLE
SOUTHEAST COUNTY LANDFILL
LANDFILL GAS COLLECTION
AND CONTROL SYSTEM PROJECT

CLIENT
HILLSBOROUGH COUNTY
SOLID WASTE
MANAGEMENT DEPARTMENT
TAMPA, FLORIDA

SOUTHEASTERN SURVEYING, INC.
601 N. ST. AUGUSTINE RD., VALDOSTA, GA 31601
229-259-8405 FAX 229-259-8609
FLORIDA CERTIFICATE OF AUTHORIZATION NO. 00007091

PROJ. NO. 09207055.00 | DWN. BY: BLH | Q/A RVW BY: | APP. BY:
DSN. BY: BLH | CHK. BY: BLH

CADD FILE: PROFILE 40 SCALE
DATE: DECEMBER 16, 2009
SCALE: 1" = 40'
DRAWING NO. **25**

FLORIDA DEPARTMENT OF ENVIRONMENTAL PROTECTION
APR 16 2010
SOUTHWEST DISTRICT TAMPA

K:\Data\LLSBOROUGH GAS\WORKING PROFILE1.dwg, 3/16/2010 10:13:53 AM, \\192.168.0.69\hp-240 WP