



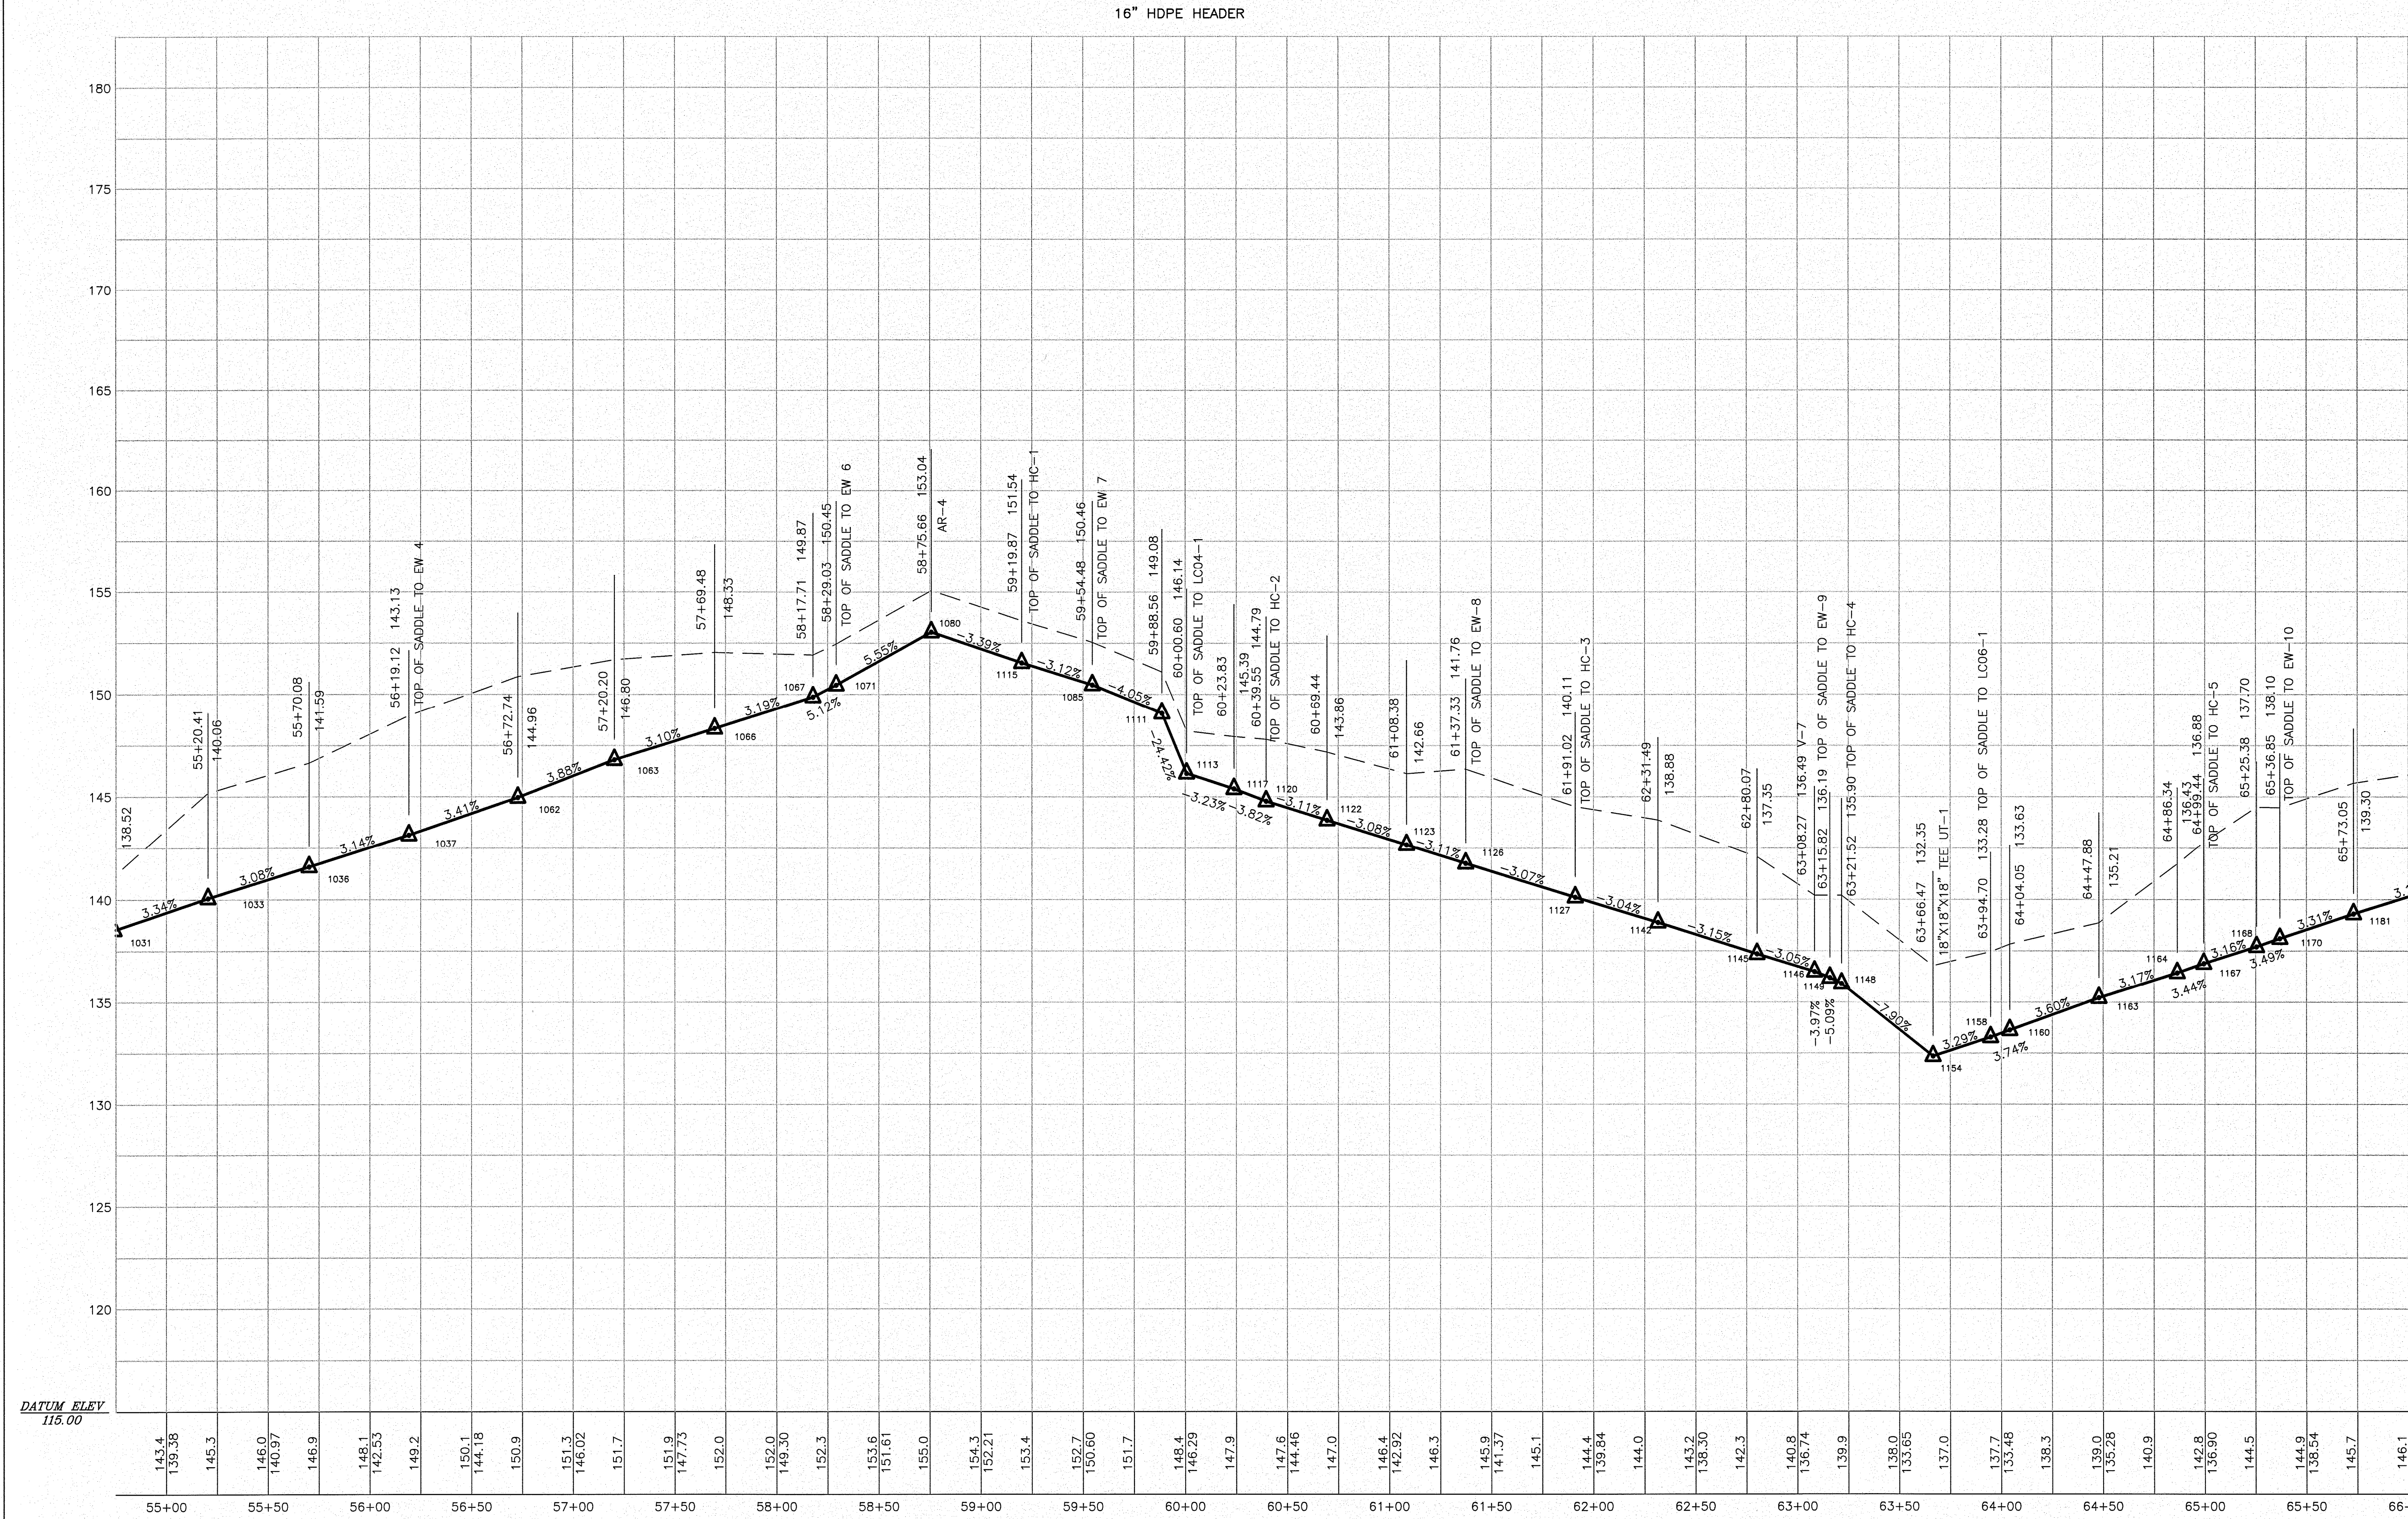

DATUM ELEV
115.00

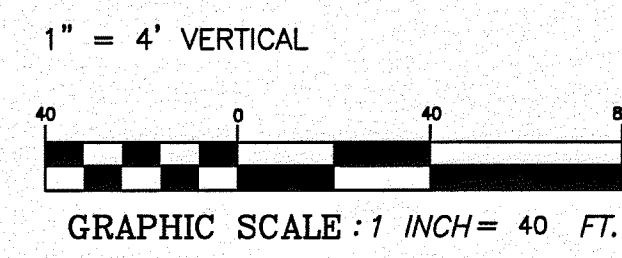

CONTRACTOR
**SOUTHEAST ENIRONMENTAL
CONTRACTING, INC.**
5687 VAL DEL ROAD, HAHIRA, GA 31632
229-794-3330 FAX 229-794-3332

DESIGN ENGINEER
SCS ENGINEERS
STEARNS, CONRAD AND SCHMIDT
CONSULTING ENGINEERS
4041 PARK OAKS BLVD., SUITE 100, TAMPA, FL 33610
813 821-0080 FAX 813 823-6757
FLORIDA CERTIFICATE OF AUTHORIZATION NO. 00004892

Barbara L. Herring
BARBARA L. HERRING, PSMC #6194
DATE: 12-16-09

DRAWING TITLE		REV	DATE	DESCRIPTION	BY
PIPE PROFILES		1			
PROJECT TITLE		1			
HILLSBOROUGH COUNTY SOLID WASTE MANAGEMENT DEPARTMENT TAMPA, FLORIDA		1			
PIPE PROFILES		1			
SOUTHEAST COUNTY LANDFILL LANDFILL GAS COLLECTION AND CONTROL SYSTEM PROJECT		1			
CLIENT		1			
SOUTHEASTERN SURVEYING, INC.		1			
601 N. ST. AUGUSTINE RD., VALDOSTA, GA 31601 229-259-9465 FAX 229-259-9628 FLORIDA CERTIFICATE OF AUTHORIZATION NO. 00007091		1			
CADD FILE: PROFILE 40 SCALE		1			
DATE: DECEMBER 16, 2009		1			
SCALE: 1" = 40'		1			
DRAWING NO.		1			
31		1			
BARBARA L. HERRING, PSMC #6194 DATE: 12-16-09		1			
FLORIDA DEPARTMENT OF ENVIRONMENTAL PROTECTION APR 16 2010 SOUTHWEST DISTRICT TAMPA		1			
BARBARA L. HERRING, PSMC #6194 DATE: 12-16-09		1			
K:\DWG\HILLSBOROUGH GASWORKING PROFILE1.dwg 3/16/2010 10:18:26 AM 102 193.3 601W 250 WP		1			