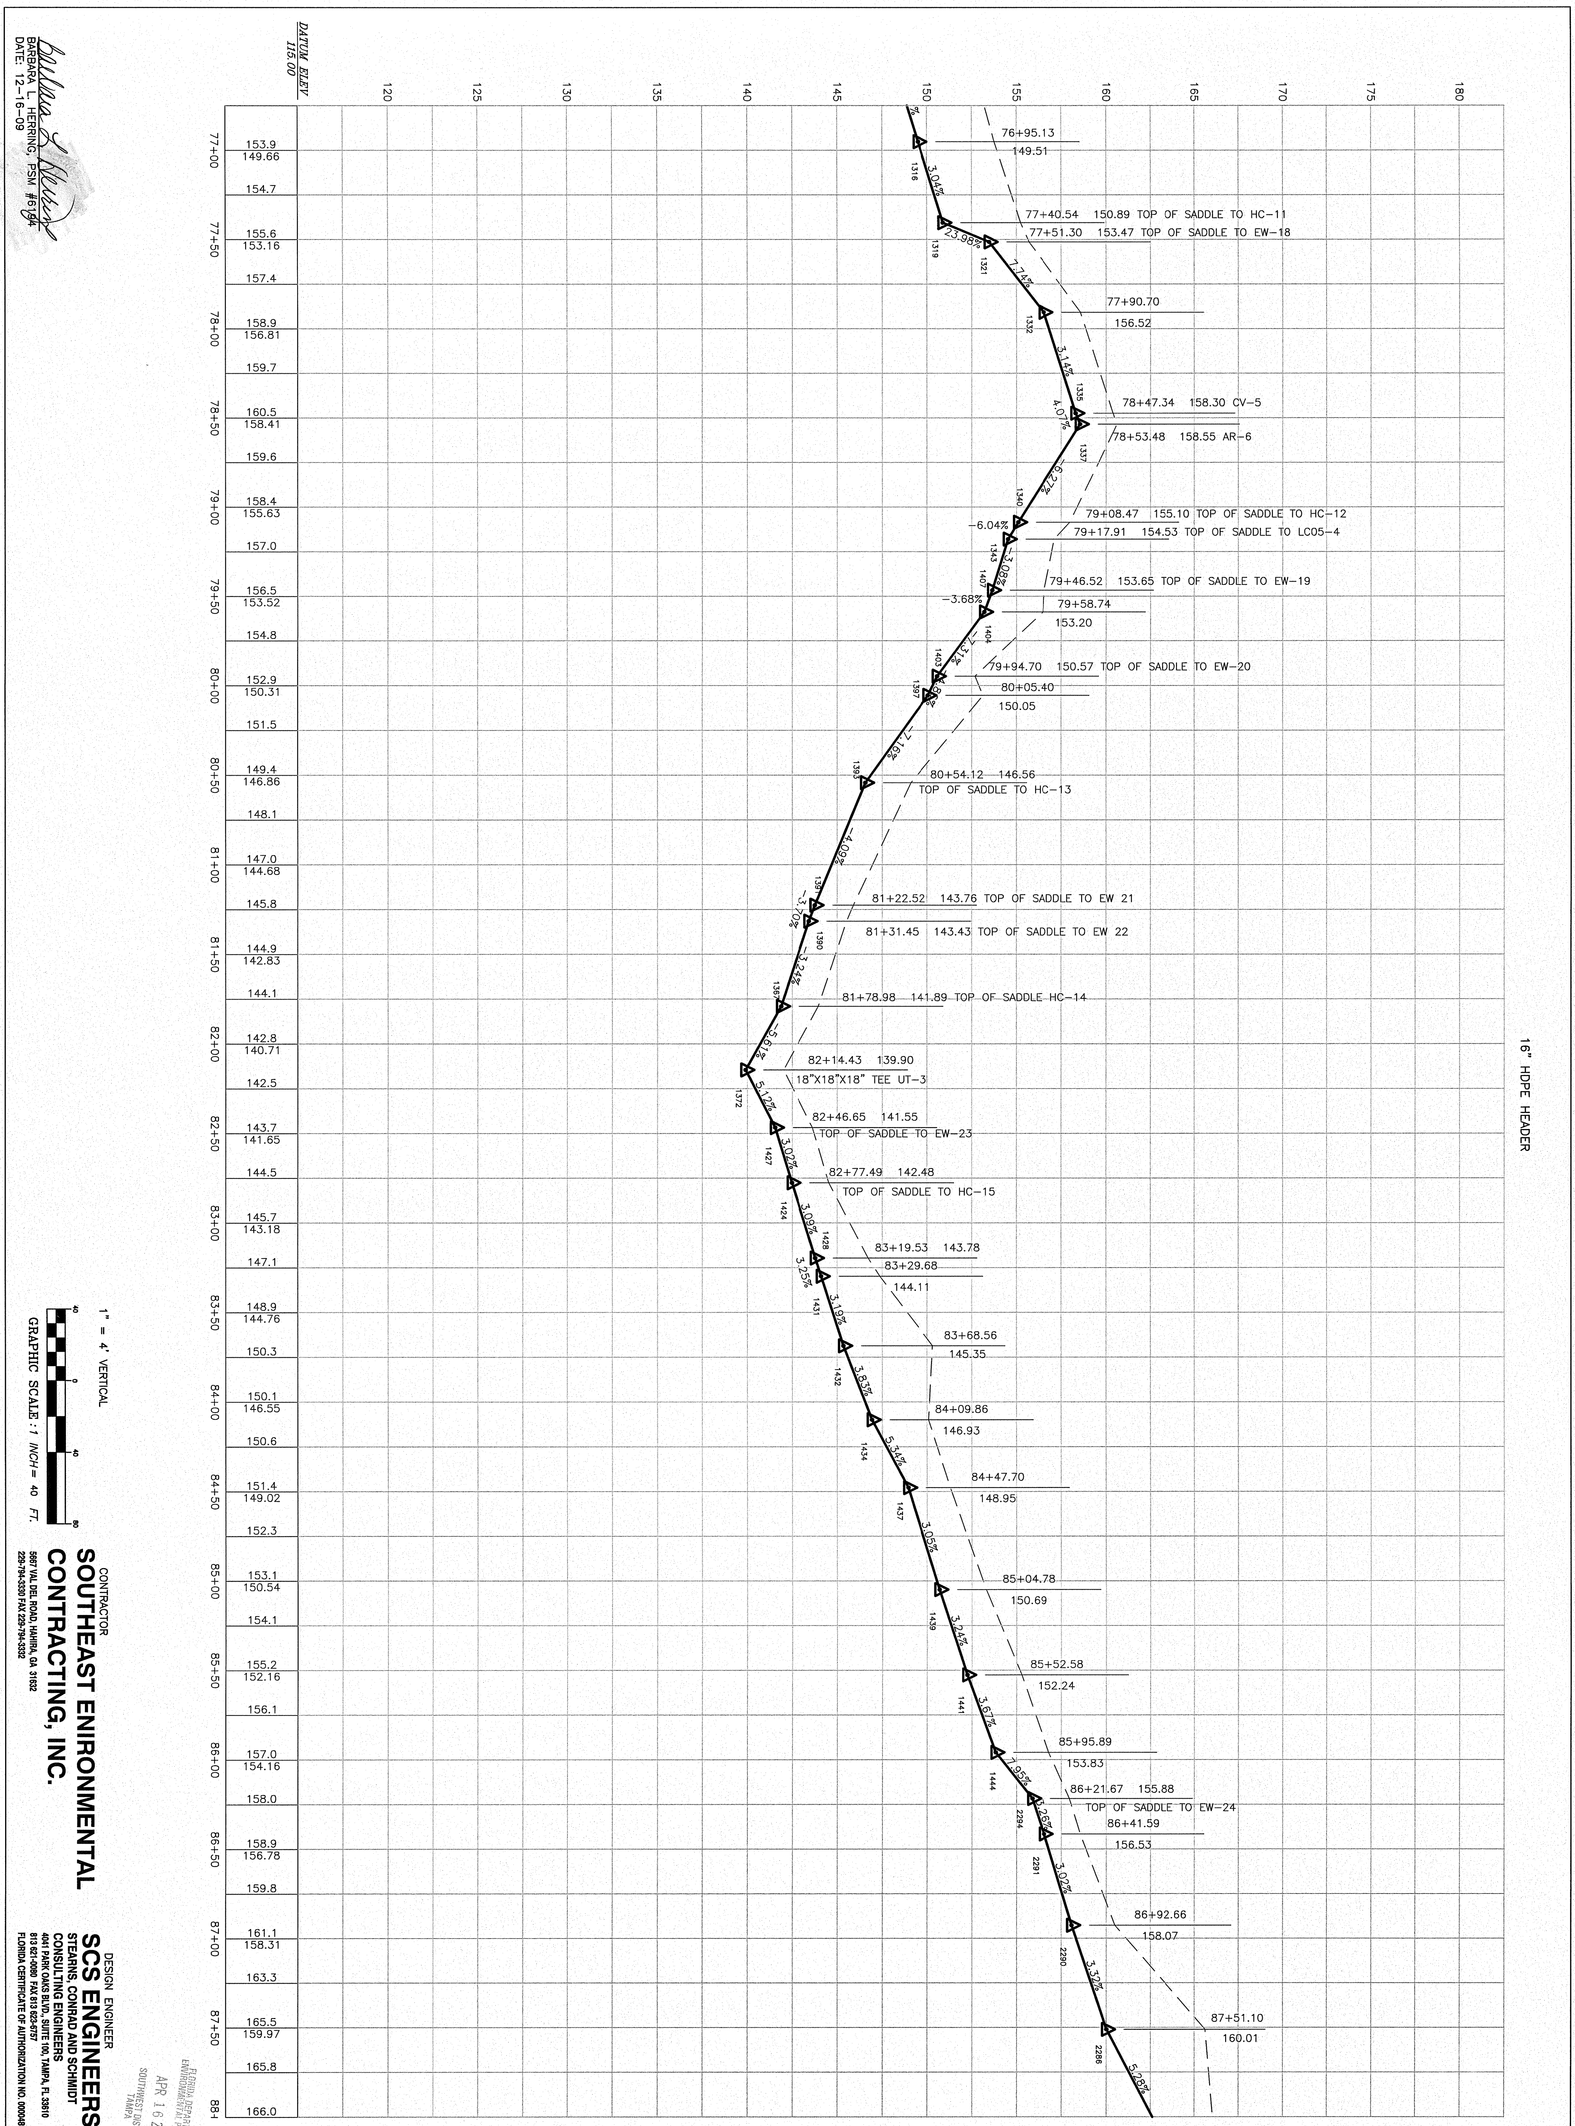


GRAPHIC SCALE: 1 INCH = 40 FT.

1" = 4' VERTICAL

BARBARA L. HERRING, PSM #6194
DATE: 12-16-09

APR 16 2010
SOUTHWEST DISTRICT TAMPA

FLORIDA DEPARTMENT OF ENVIRONMENTAL PROTECTION

CONTRACTOR
**SOUTHEAST ENIRONMENTAL CONTRACTING, INC.**
5897 VAL DEL ROAD, HAHIRA, GA 31632
229-794-5339 FAX 229-794-5332

DESIGN ENGINEER
**SCS ENGINEERS**
STEARNS, CONRAD AND SCHMIDT CONSULTING ENGINEERS
4041 PARK OAKS BLVD, SUITE 100, TAMPA, FL 33610
813 621-0080 FAX 813 623-6757
FLORIDA CERTIFICATE OF AUTHORIZATION NO. 00004892

| | | | |
|---|---|---|---|
| DRAWING NO. 33 | SCALE: 1" = 40' | CADD FILE: PROFILE 40 SCALE | DATE: DECEMBER 16, 2009 |

**SOUTHEASTERN SURVEYING, INC.**
601 N. ST. AUGUSTINE RD., VALDOSTA, GA 31601
229-259-9455 FAX 229-259-9926
FLORIDA CERTIFICATE OF AUTHORIZATION NO. 00007091

| PROJ. NO. | DWN. BY: | Q/A RVW BY: |
|---|---|---|
| 09207055.00 | BLH | |
| DSN. BY: BLH | CHK. BY: BLH | APP. BY: |

CLIENT
**HILLSBOROUGH COUNTY SOLID WASTE MANAGEMENT DEPARTMENT TAMPA, FLORIDA**

DRAWING TITLE
**PIPE PROFILES**

PROJECT TITLE
**SOUTHEAST COUNTY LANDFILL LANDFILL GAS COLLECTION AND CONTROL SYSTEM PROJECT**

| REV | DATE | DESCRIPTION | BY |
|---|---|---|---|
| 1 | | | |
| 2 | | | |
| 3 | | | |
| 4 | | | |
| 5 | | | |

BARBARA L.HERRING, RLS
LICENSE NO. 6194