


DATUM ELEV
115.00

16" HDPE HEADER

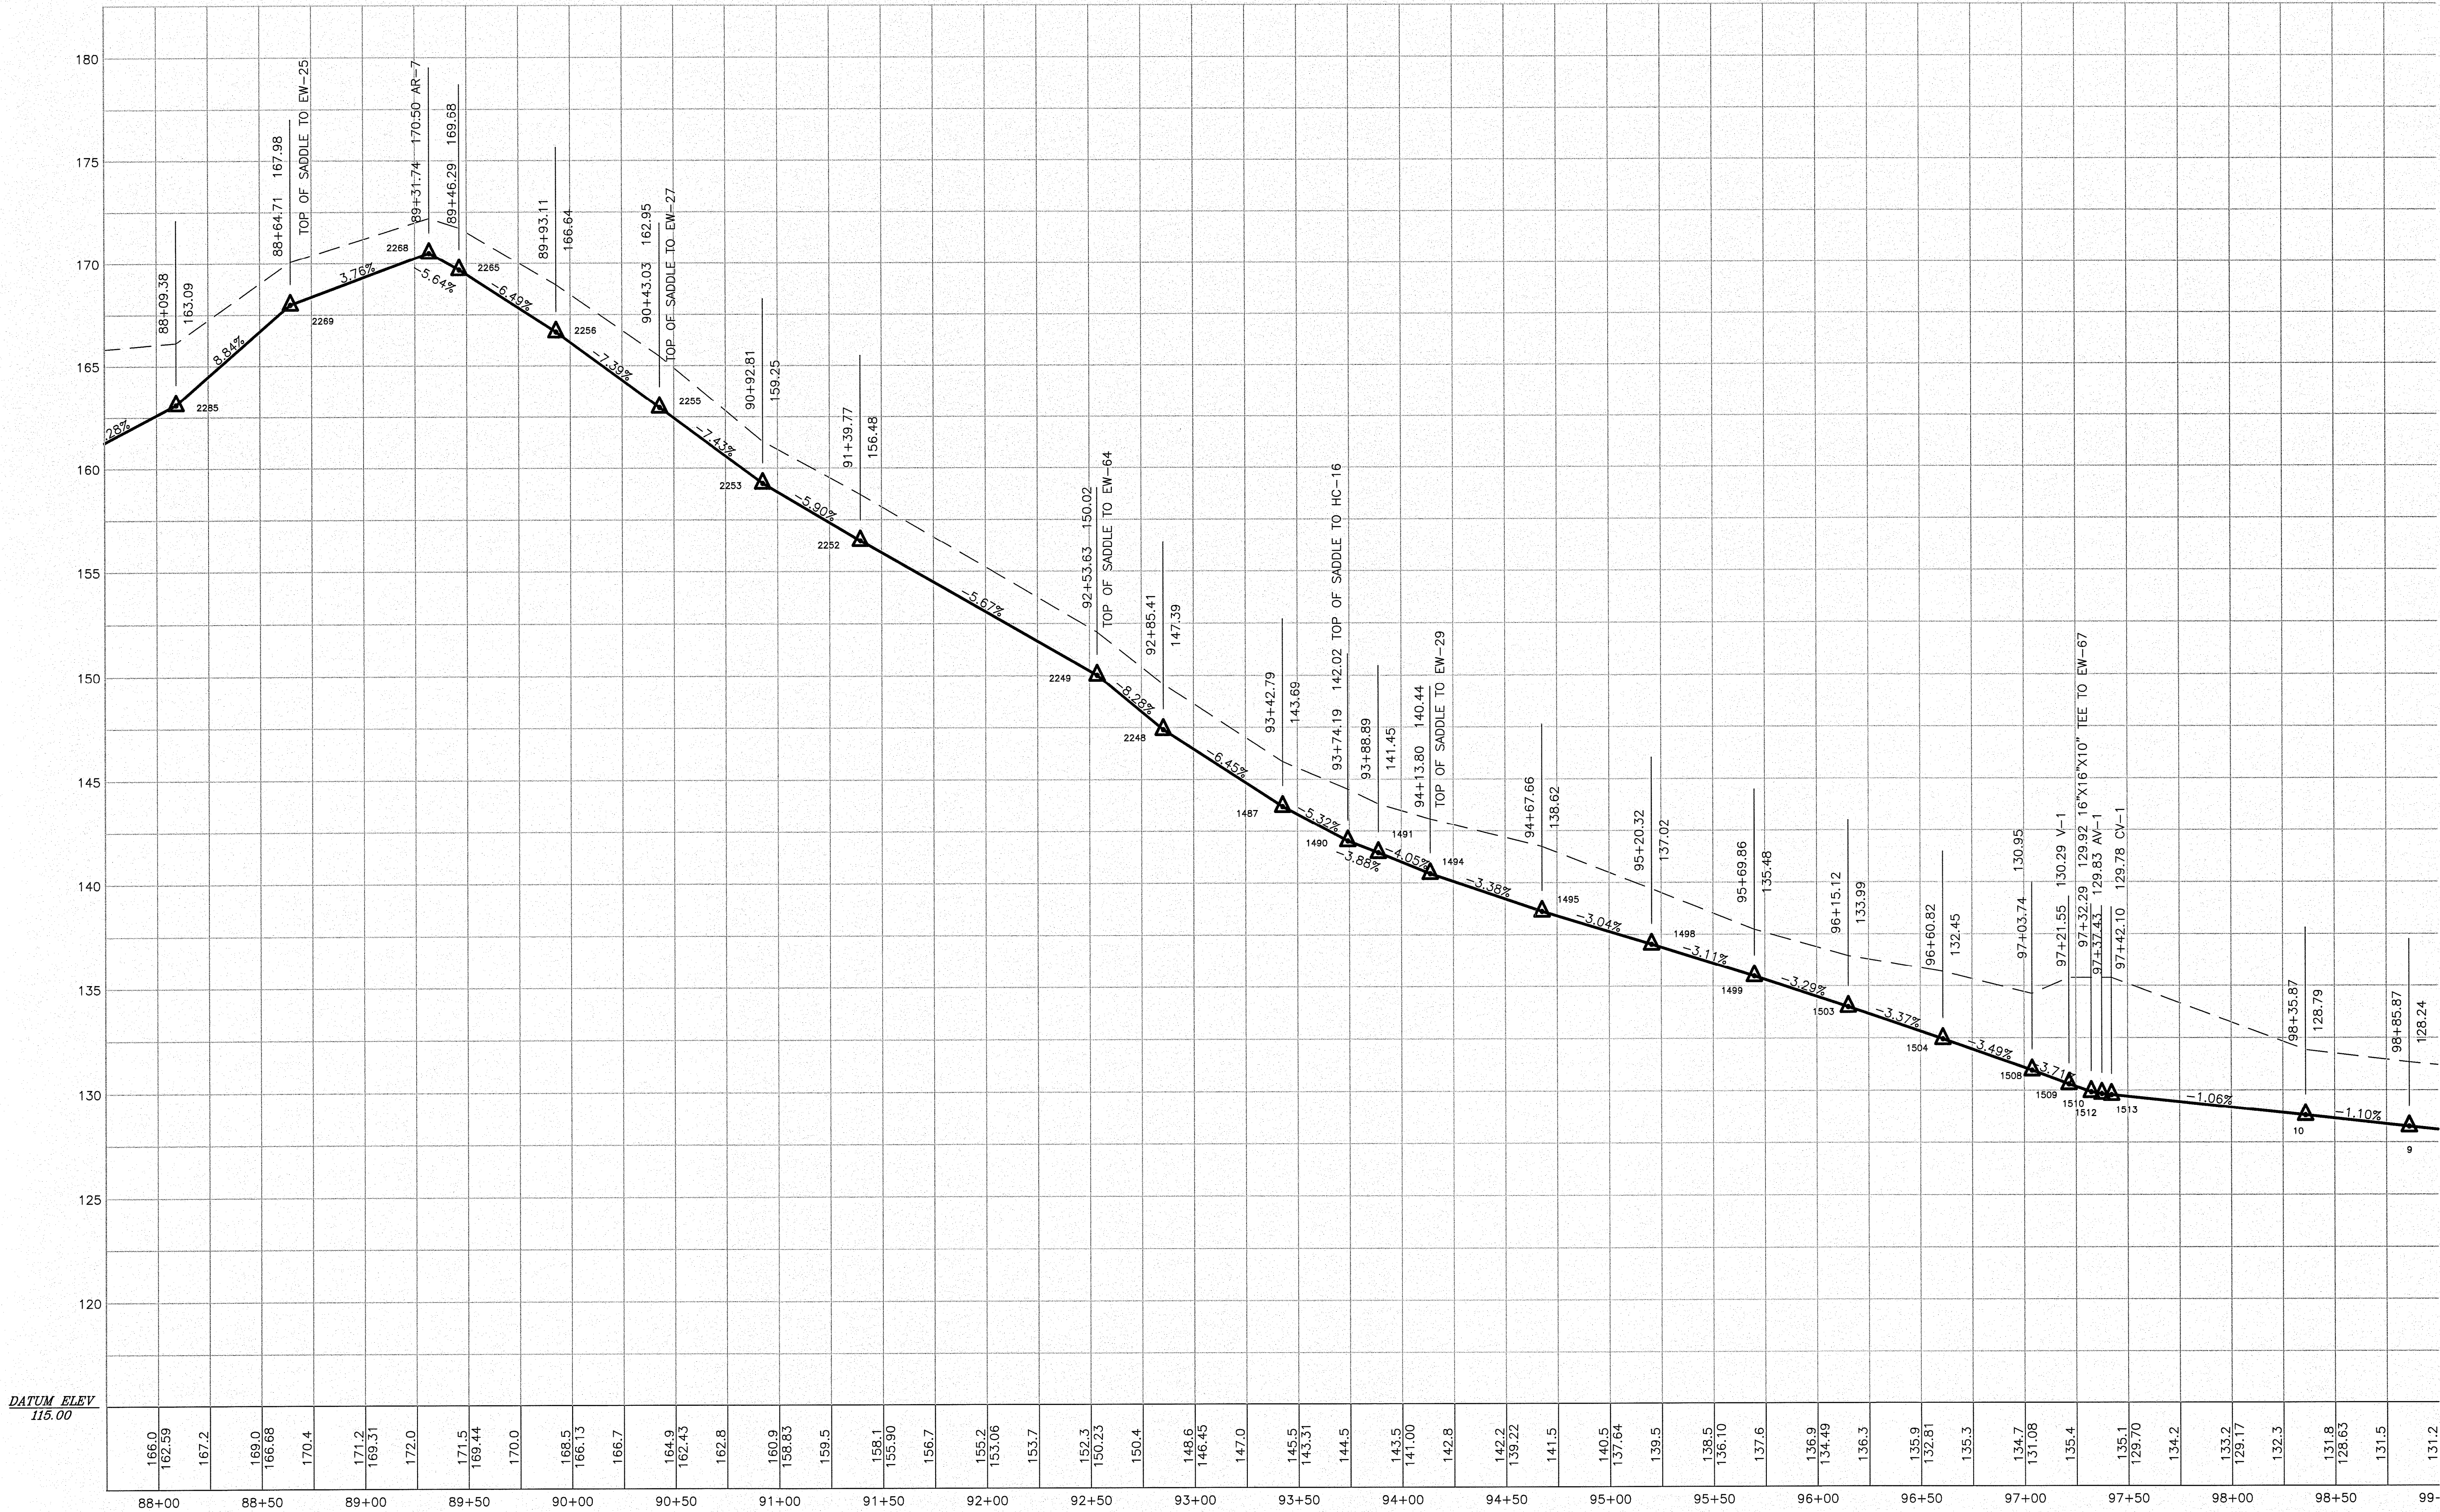

Barbara L. Herring
BARBARA L. HERRING, PSM #6184
DATE: 12-16-09

1" = 4' VERTICAL
GRAPHIC SCALE : 1 INCH = 40 FT.

CONTRACTOR
**SOUTHEAST ENIRONMENTAL
CONTRACTING, INC.**
5687 VAL DEL ROAD, HAHIRA, GA 31632
229-794-3330 FAX 229-794-3332

DESIGN ENGINEER
SCS ENGINEERS
STEARNS, CONRAD AND SCHMIDT
CONSULTING ENGINEERS
4041 PARK OAKS BLVD., SUITE 100, TAMPA, FL 33610
813 621-0080 FAX 813 623-6757
FLORIDA CERTIFICATE OF AUTHORIZATION NO. 00004892

DRAWING TITLE		REV	DATE	DESCRIPTION	BY
PIPE PROFILES		1			
PROJECT TITLE		1			
SOUTHEAST COUNTY LANDFILL LANDFILL GAS COLLECTION AND CONTROL SYSTEM PROJECT		1			
CLIENT		1			
HILLSBOROUGH COUNTY SOLID WASTE MANAGEMENT DEPARTMENT TAMPA, FLORIDA		1			
CADD FILE: PROFILE 40 SCALE		1			
DATE: DECEMBER 16, 2009		1			
SCALE: 1" = 40'		1			
DRAWING NO.		1			
34		1			
BARBARA L. HERRING, PSM #6184 LUCENE NO. 6194		1			