

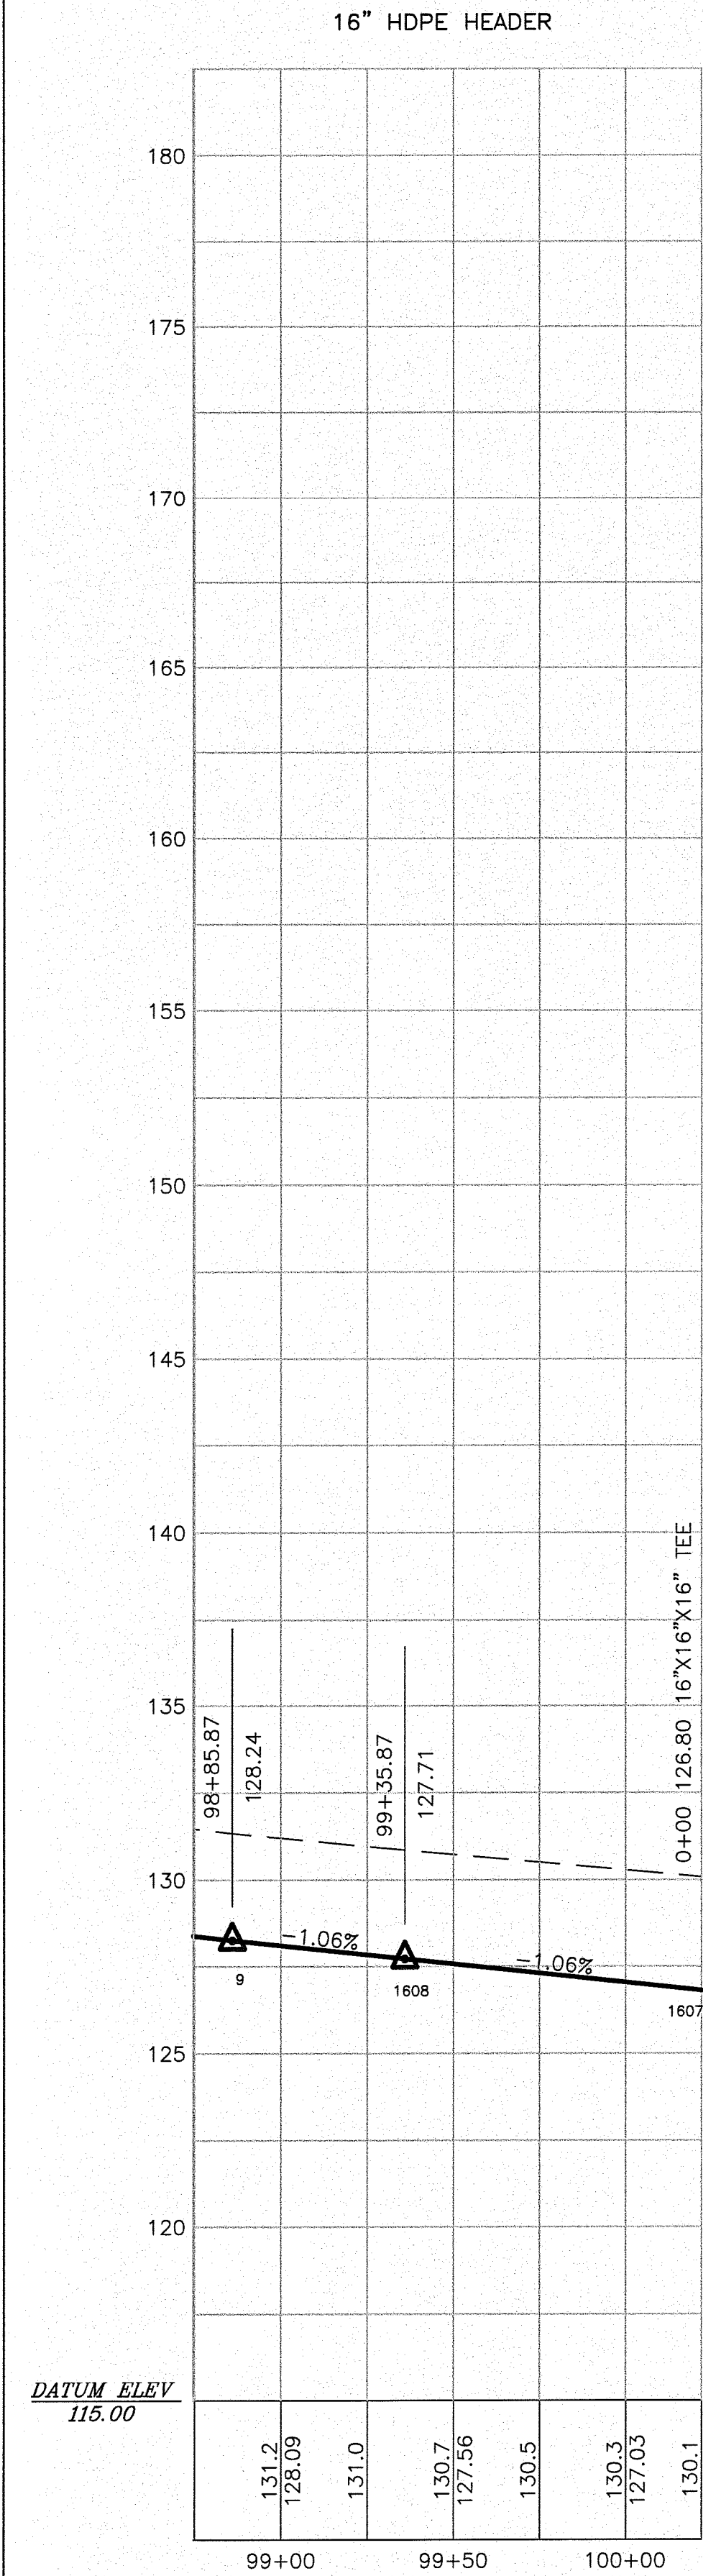


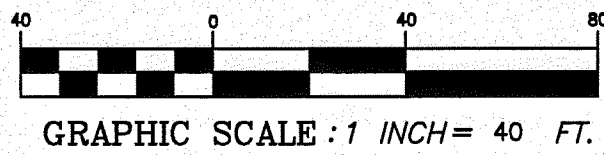

Barbara L. Herring
BARBARA L. HERRING, FSM #6194
DATE: 12-16-09

SECTION 7 & 8 16" HDPE

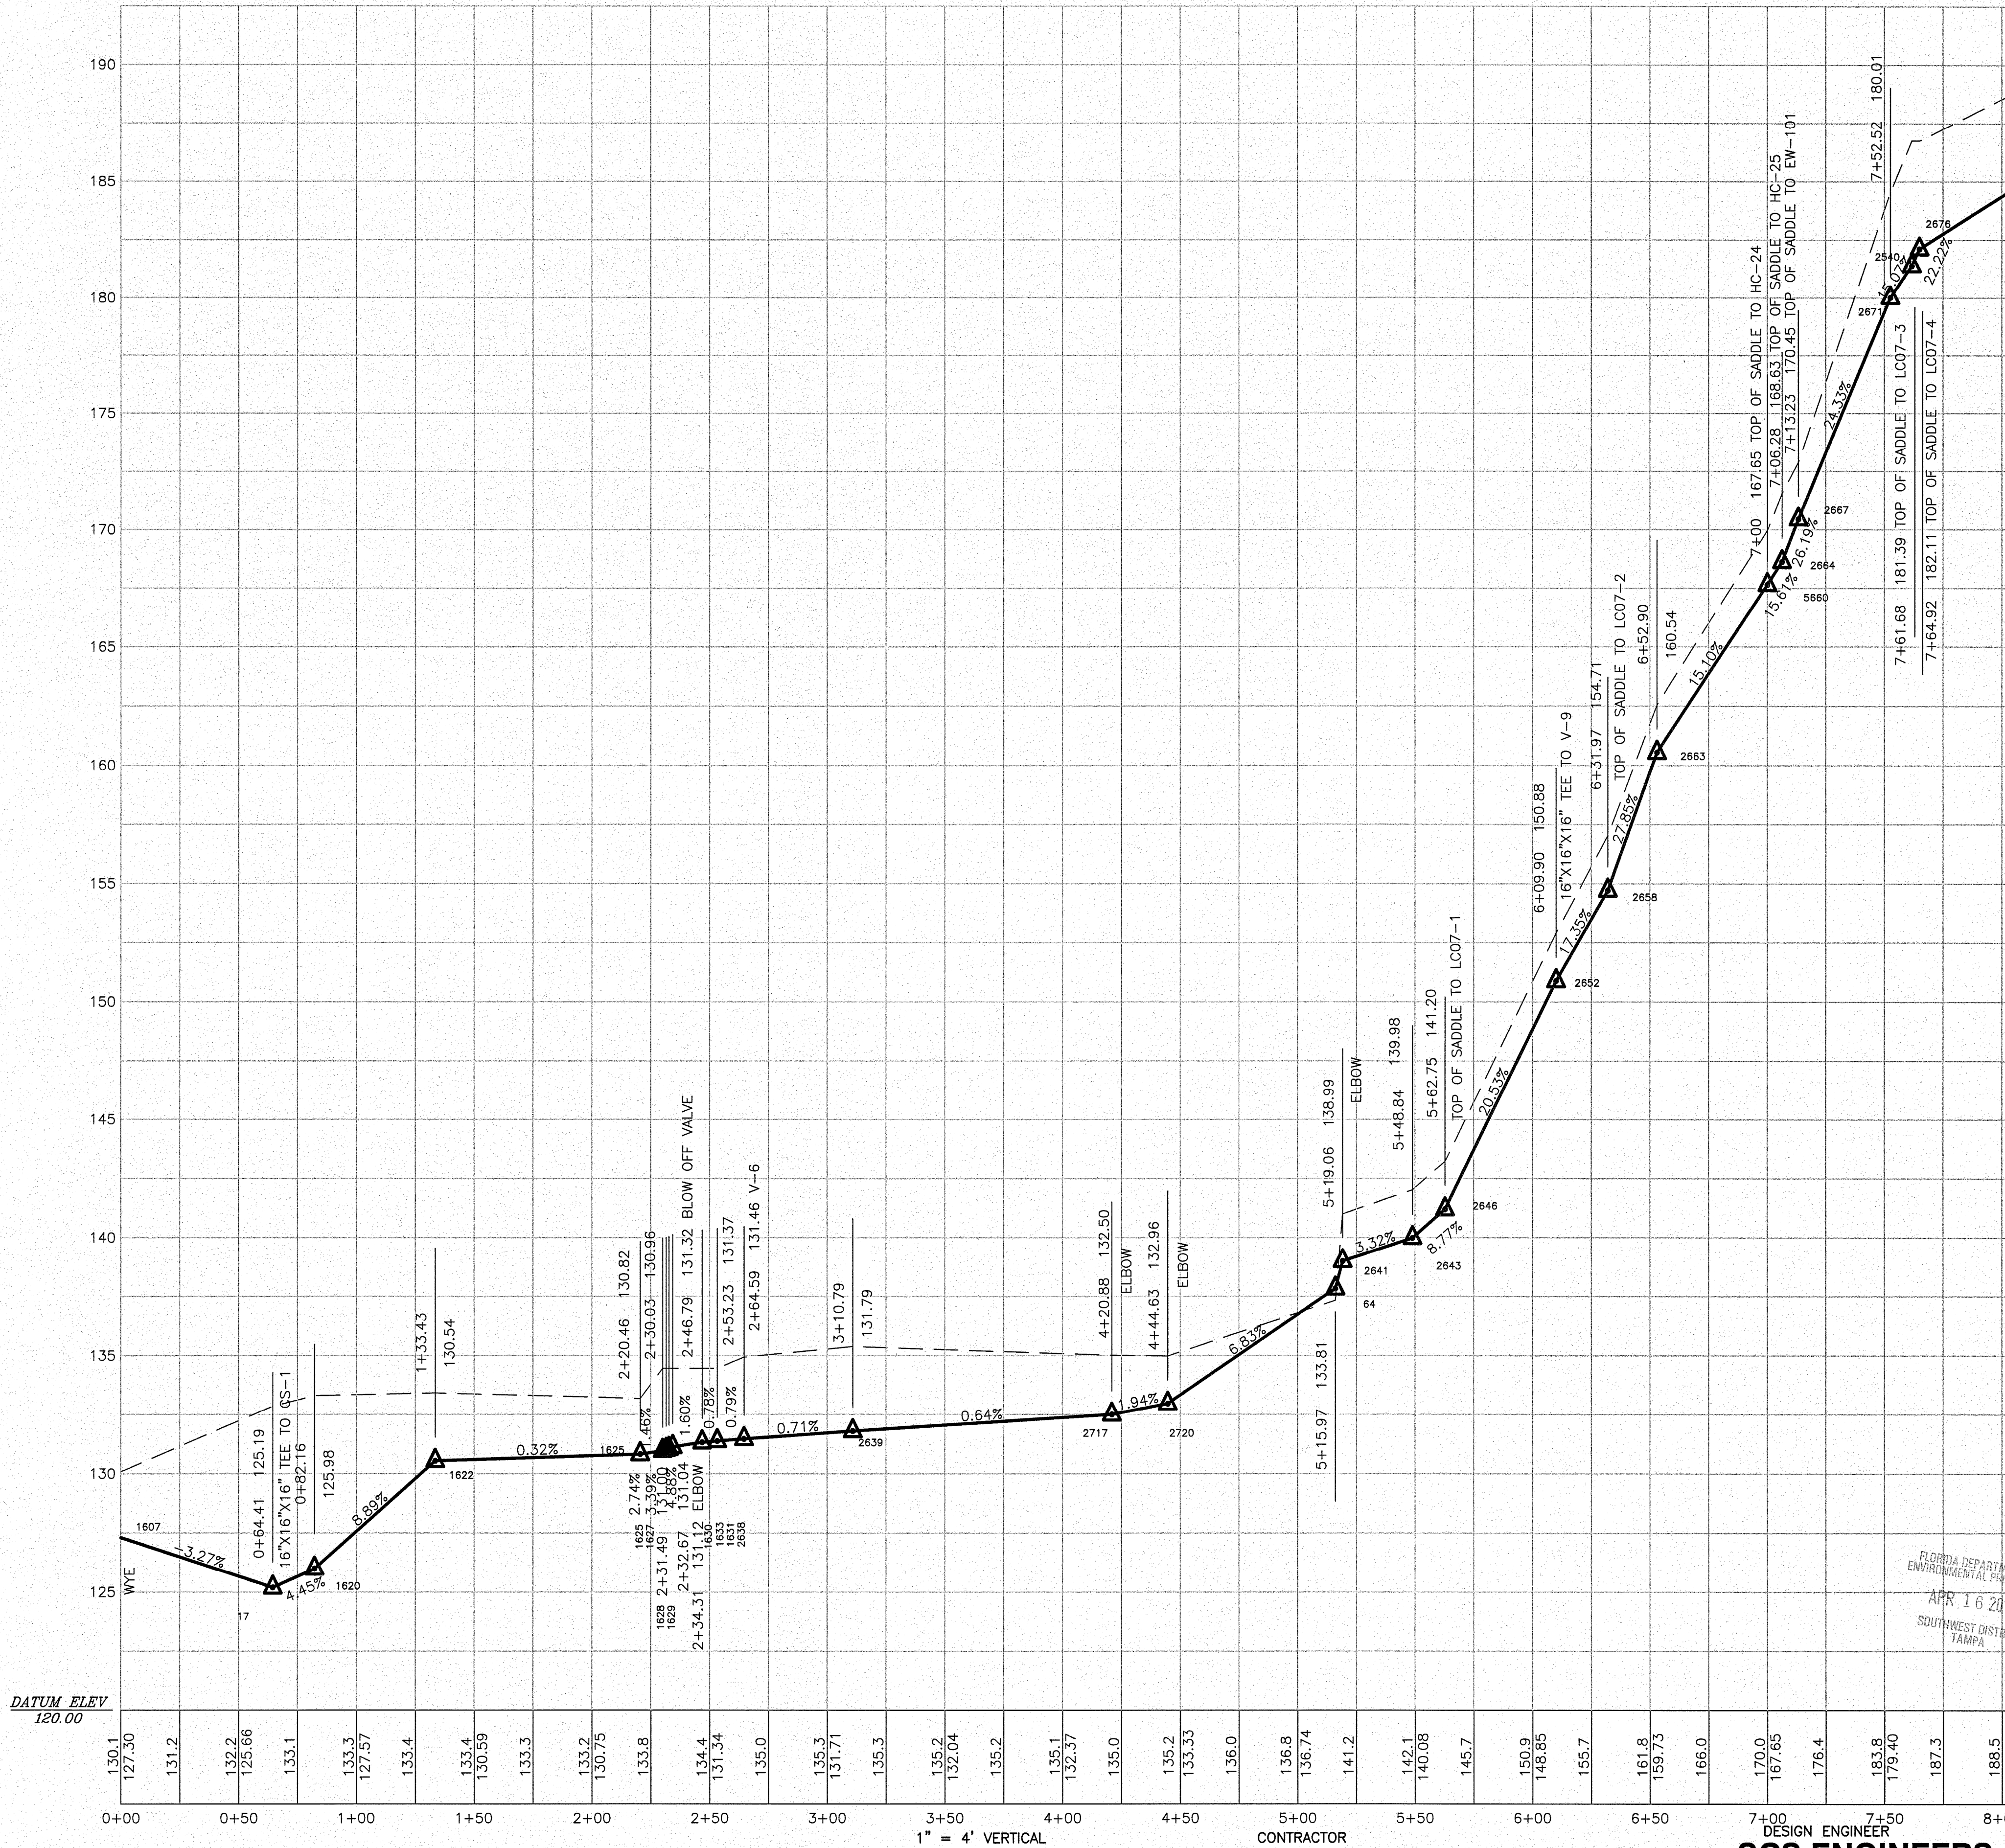

CONTRACTOR
**SOUTHEAST ENIRONMENTAL
CONTRACTING, INC.**

5667 VAL DEL ROAD, HAHIRA, GA 31632
229-794-3330 FAX 229-794-3332

SCS ENGINEERS
STEARNS, CONRAD AND SCHMIDT
CONSULTING ENGINEERS
4041 PARK OAKS BLVD., SUITE 100, TAMPA, FL 33610
813 821-0080 FAX 813 823-6757
FLORIDA CERTIFICATE OF AUTHORIZATION NO. 00004892

DRAWING TITLE		REV	DATE	DESCRIPTION	BY
PIPE PROFILES					
PROJECT TITLE					
SOUTHEAST COUNTY LANDFILL LANDFILL GAS COLLECTION AND CONTROL SYSTEM PROJECT					
CLIENT					
HILLSBOROUGH COUNTY SOLID WASTE MANAGEMENT DEPARTMENT TAMPA, FLORIDA					
CADD FILE:					
PROFILE 40 SCALE					
DATE:					
DECEMBER 16, 2009					
SCALE:					
1" = 40'					
DRAWING NO.					
35					
DESIGN ENGINEER					
APPROVED					
DATE					
BY					
DATE					
DESCRIPTION					
BY					
DATE					
DESCRIPTION					
