
SECTION 7 & 8 16" HDPE

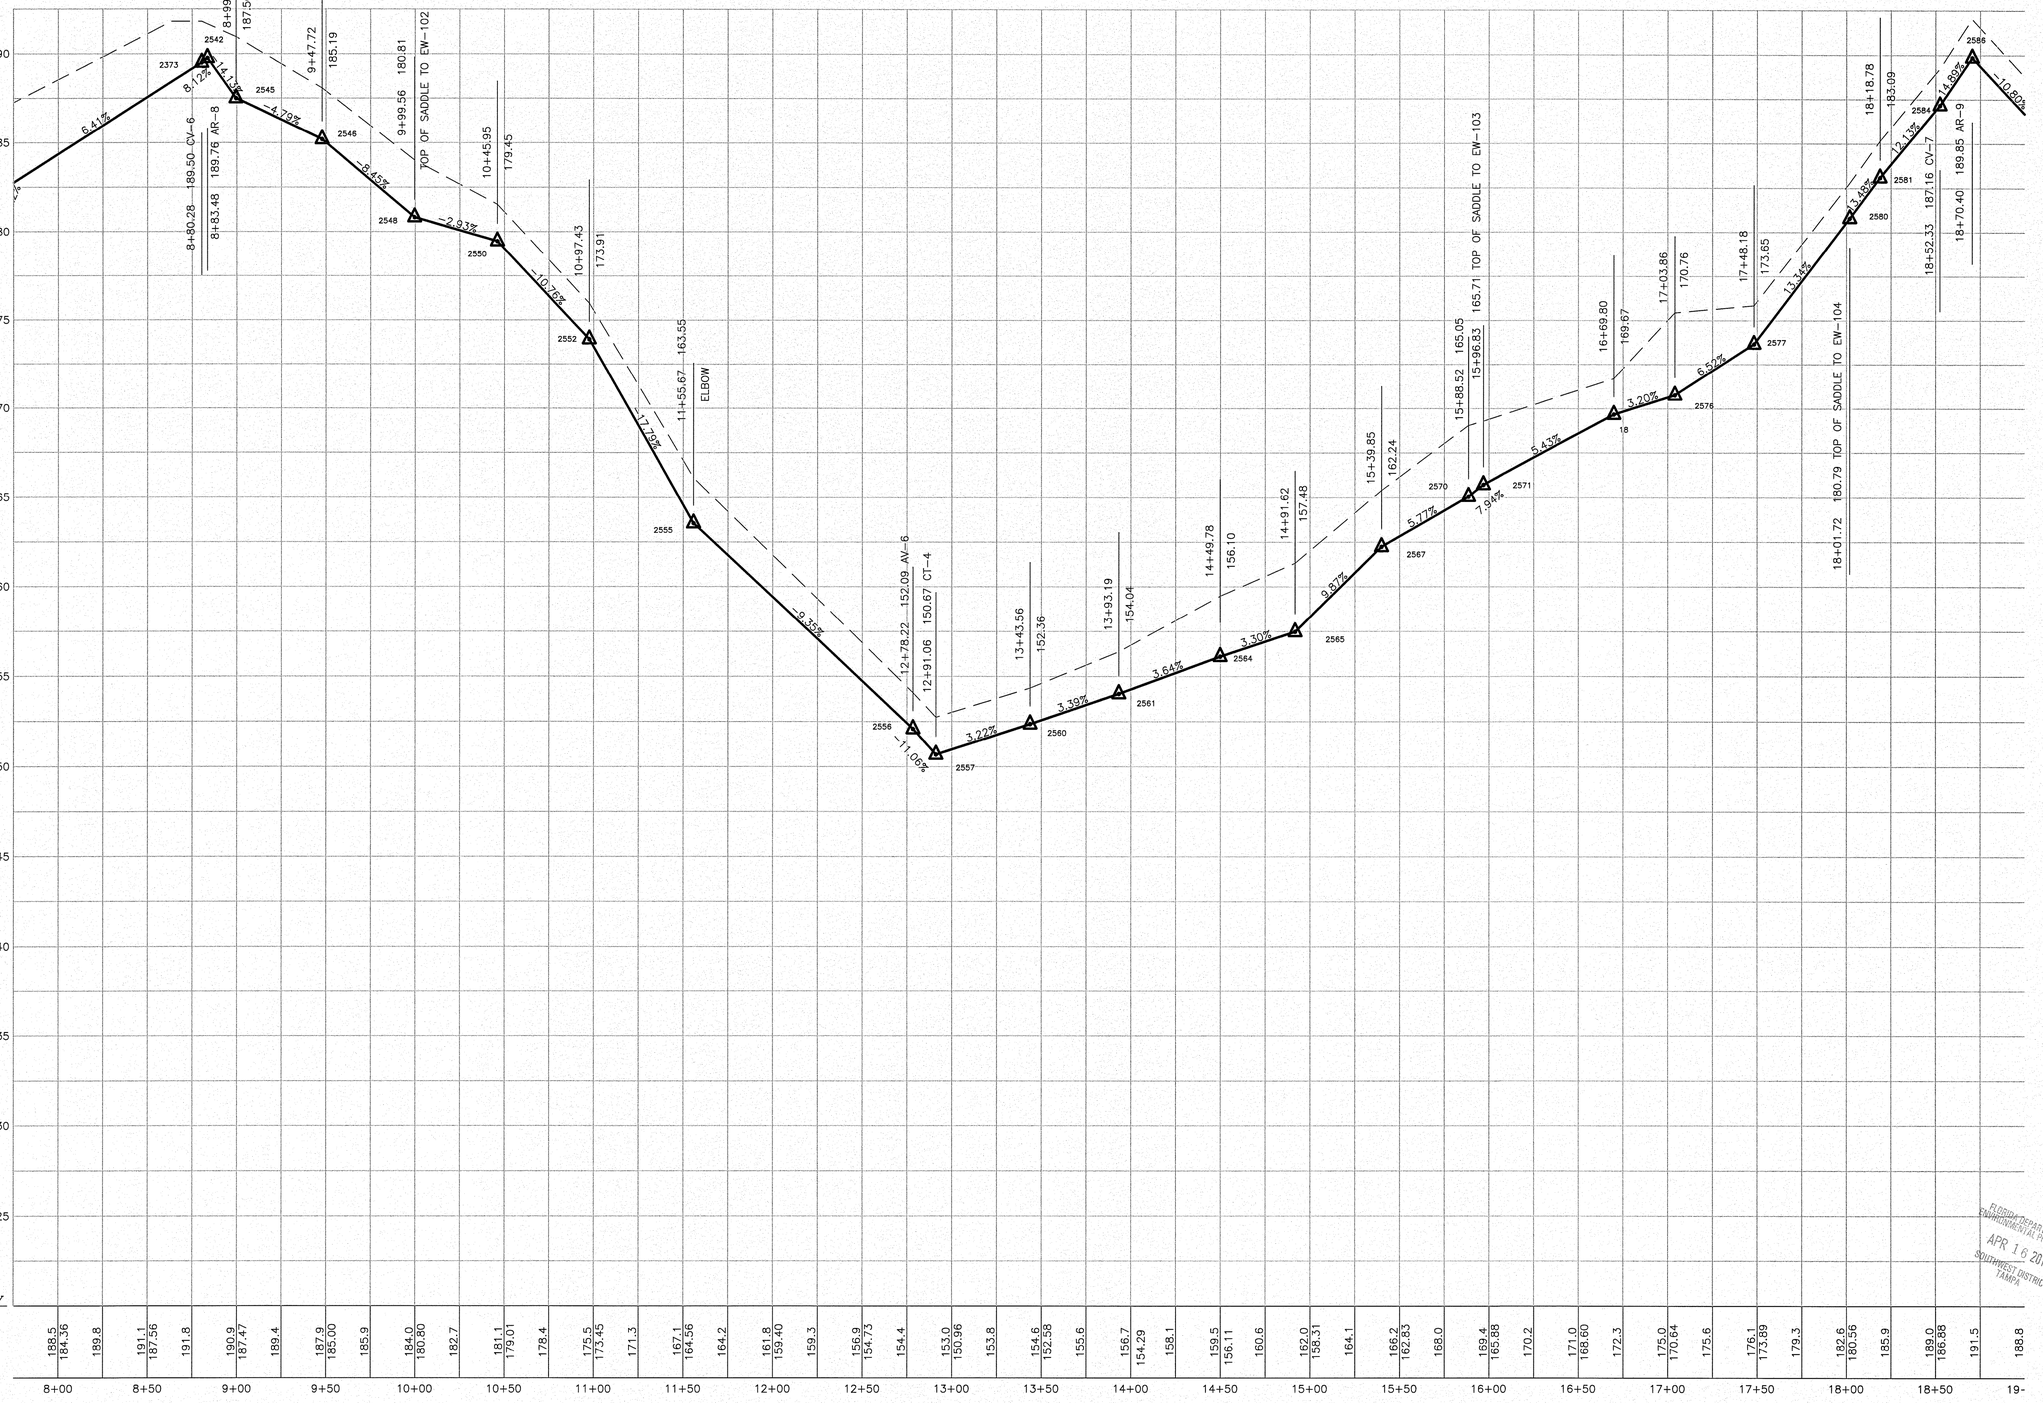

1" = 4' VERTICAL

GRAPHIC SCALE : 1 INCH = 40 FT.

Barbara L Herring
BARBARA L. HERRING, PSM #6194
DATE: 12-16-09

CONTRACTOR
SOUTHEAST ENIRONMENTAL CONTRACTING, INC.
5667 VAL DEL ROAD, HAHIRA, GA 31632
229-794-3330 FAX 229-794-3332

DESIGN ENGINEER
SCS ENGINEERS
STEARNS, CONRAD AND SCHMIDT CONSULTING ENGINEERS
4041 PARK OAKS BLVD., SUITE 100, TAMPA, FL 33610
813 621-0080 FAX 813 623-6757
FLORIDA CERTIFICATE OF AUTHORIZATION NO. 00004892

FLORIDA DEPARTMENT OF ENVIRONMENTAL PROTECTION
APR 16 2010
SOUTHWEST DISTRICT TAMPA

REV	DATE	DESCRIPTION	BY

BARBARA L HERRING, RLS
LICENSE NO. 6194

DRAWING TITLE: **PIPE PROFILES**

PROJECT TITLE: **SOUTHEAST COUNTY LANDFILL**
LANDFILL GAS COLLECTION
AND CONTROL SYSTEM PROJECT

CLIENT
HILLSBOROUGH COUNTY
SOLID WASTE
MANAGEMENT DEPARTMENT
TAMPA, FLORIDA

SOUTHEASTERN SURVEYING, INC.
801 N. ST. AUGUSTINE RD. VALDOSTA, GA. 31601
229-259-9405 FAX 229-259-9926
FLORIDA CERTIFICATE OF AUTHORIZATION NO. 00007091

PROJ. NO. 092071055.00
DWN.: BY: BLH
CHK.: BY: BLH
Q/A: R/W BY:
APP.: BY:

CADD FILE: PROFILE 40 SCALE
DATE: DECEMBER 16, 2009
SCALE: 1" = 40'
DRAWING NO. **36**

K:\Engr\HILLSBOROUGH GAS\WORKING PROFILE1.dwg, 3/10/2010 10:17:08 AM, \\192.168.5.66\HG-240 WP