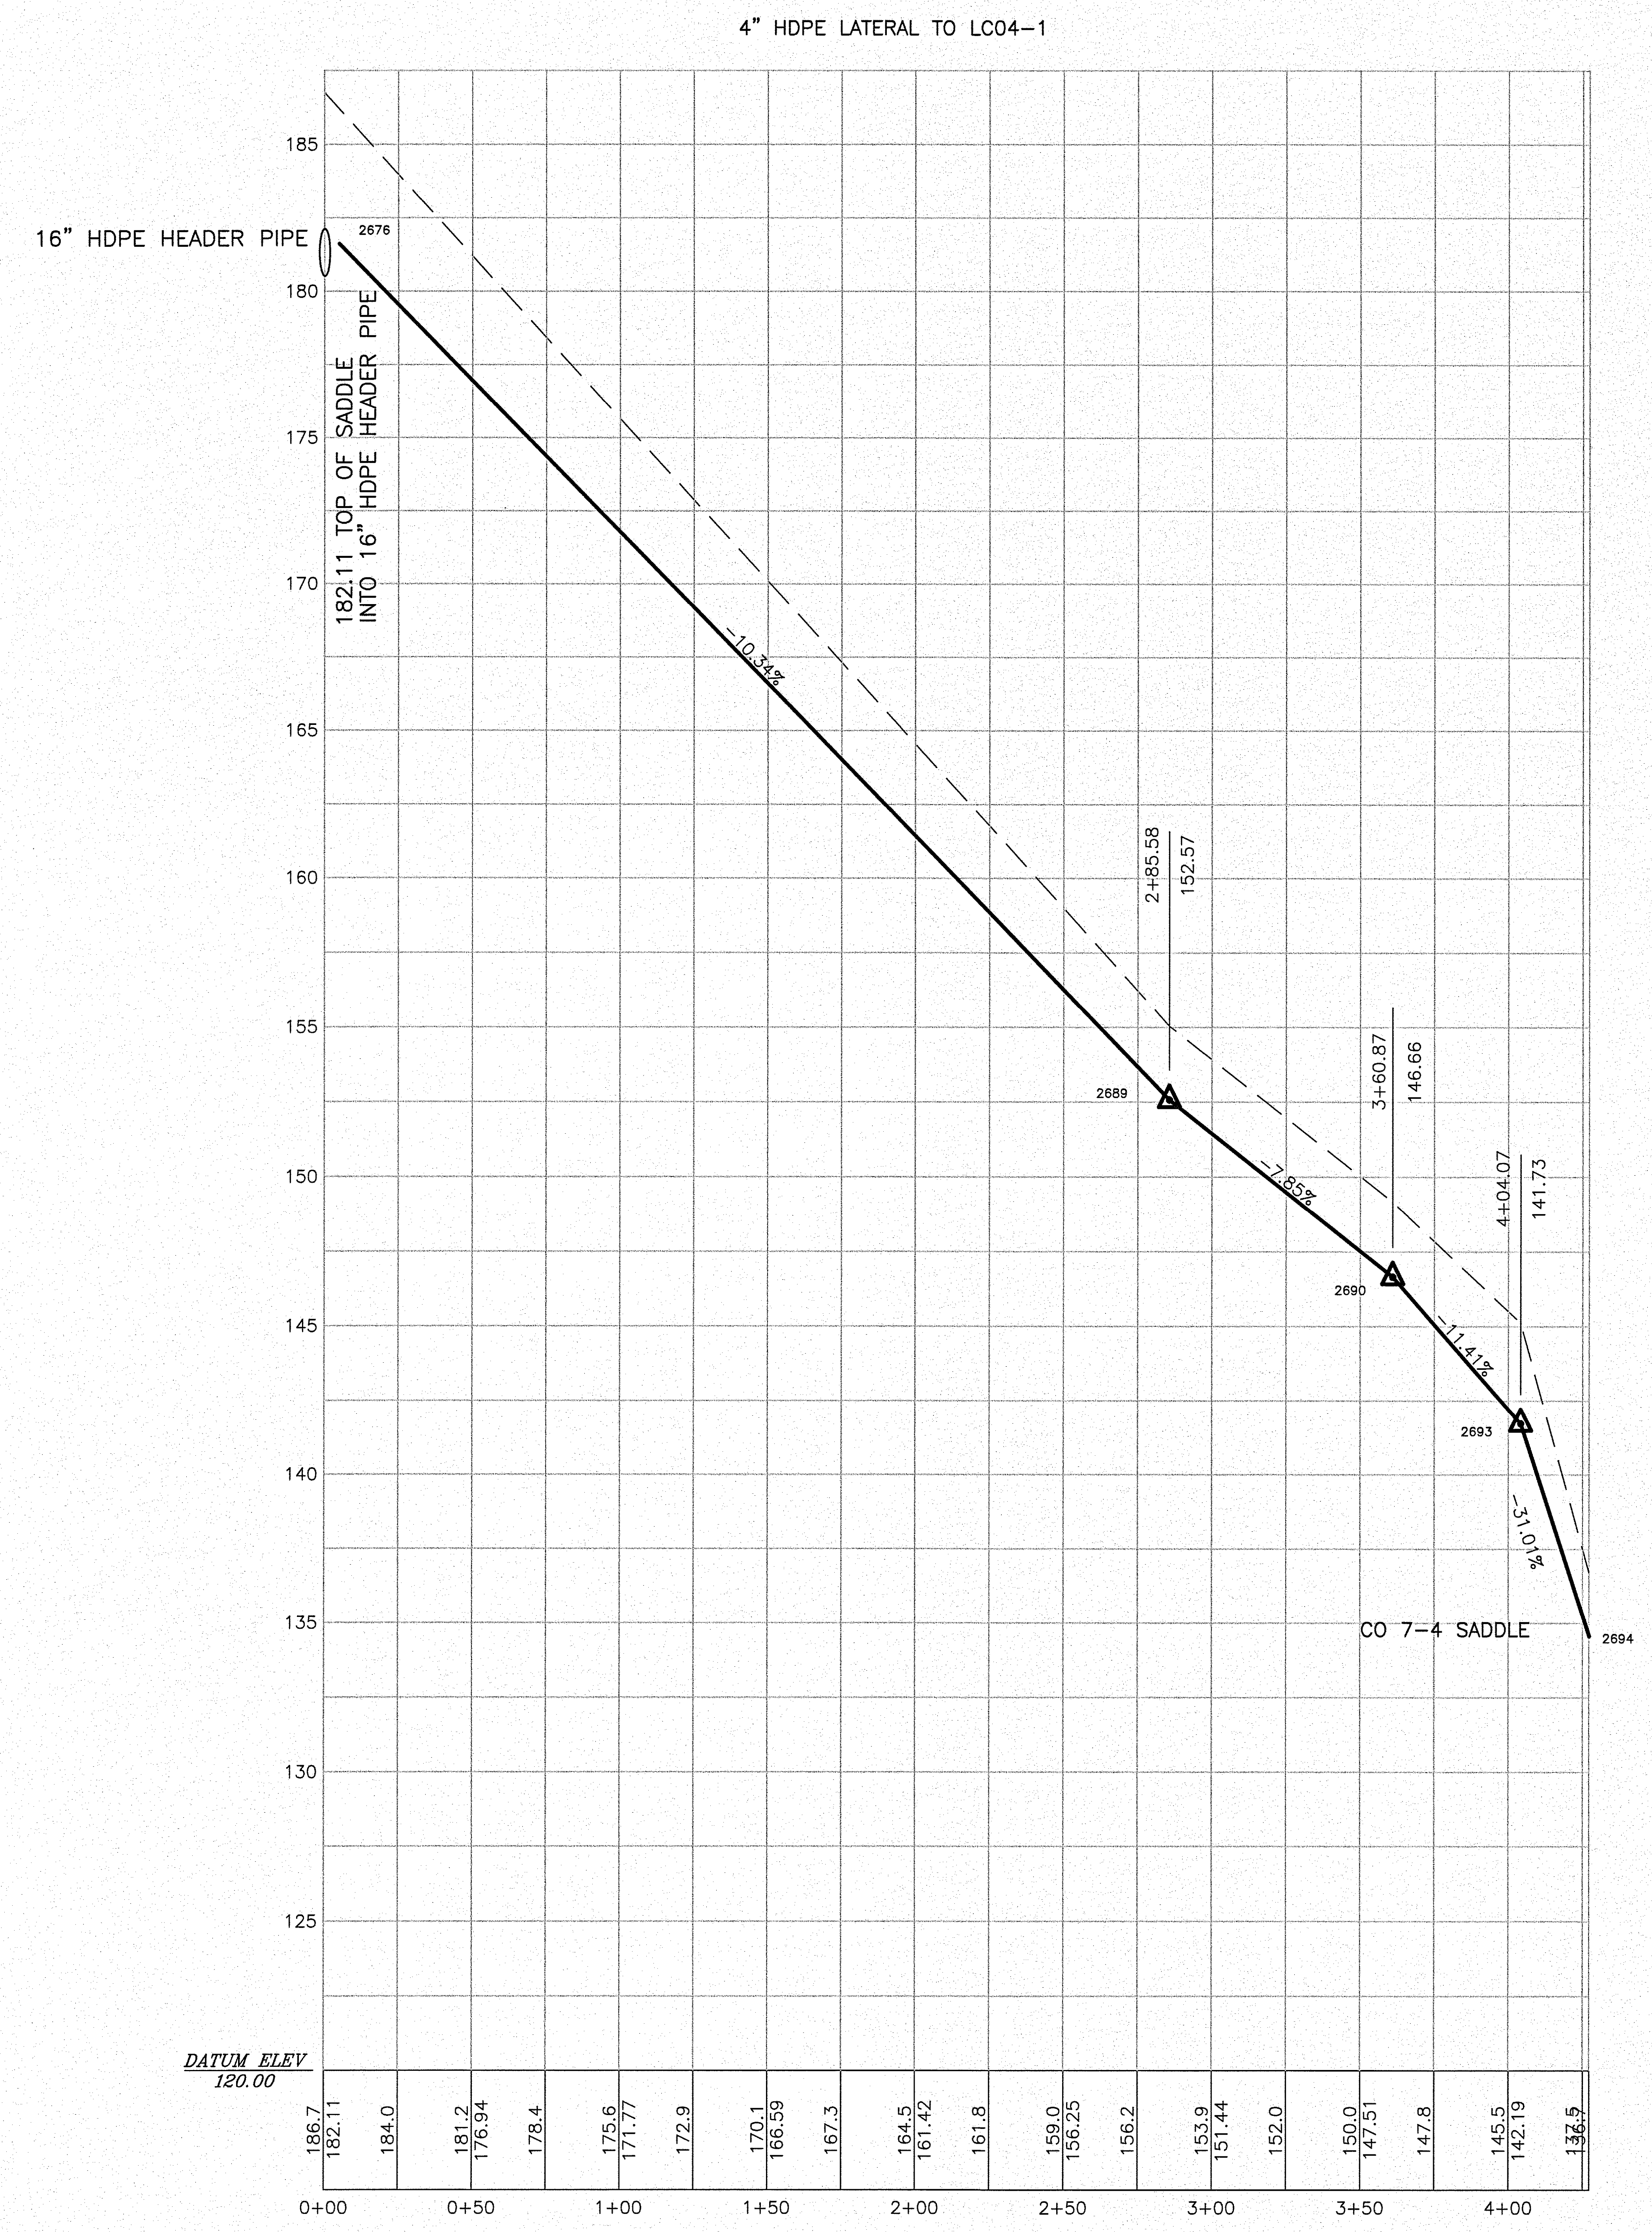

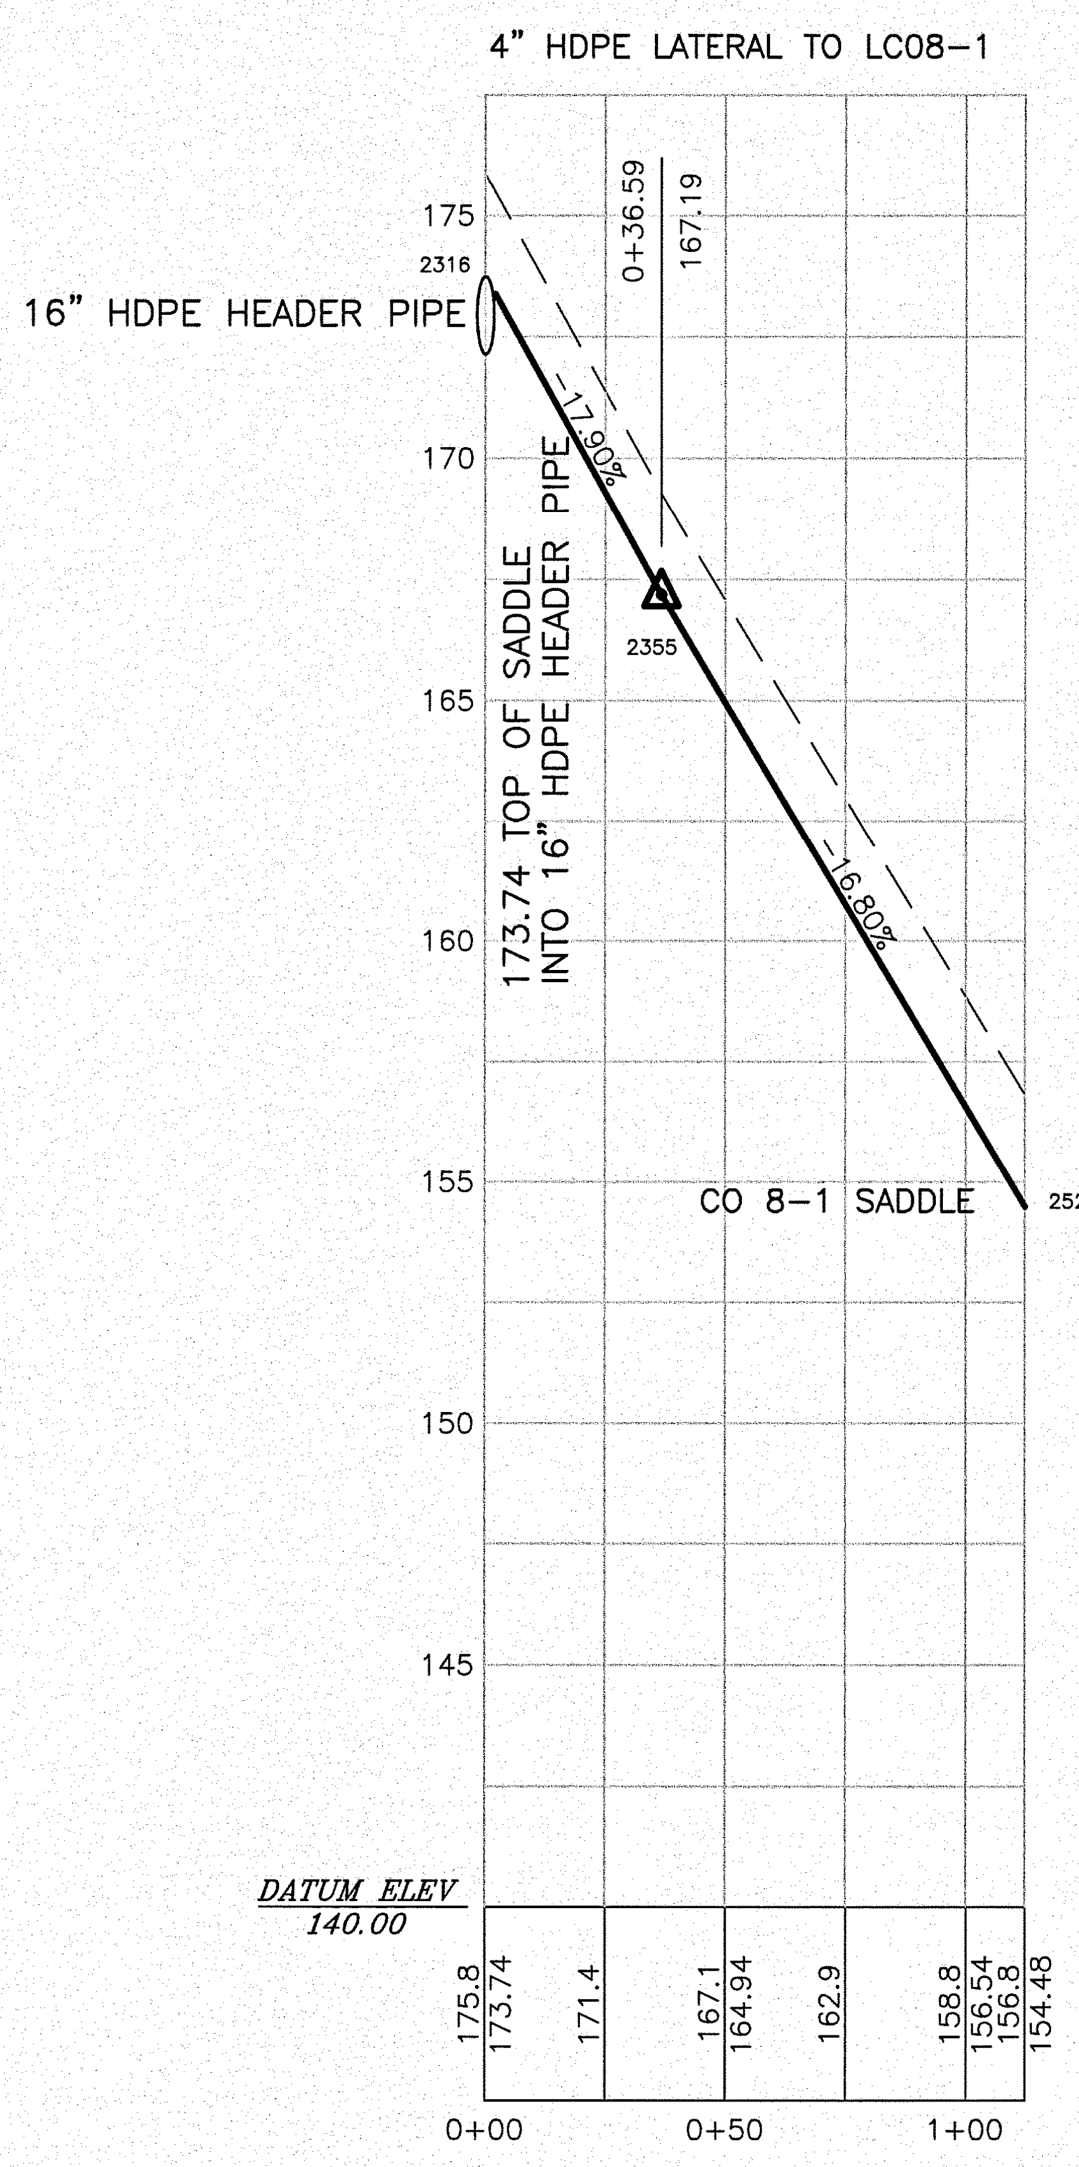

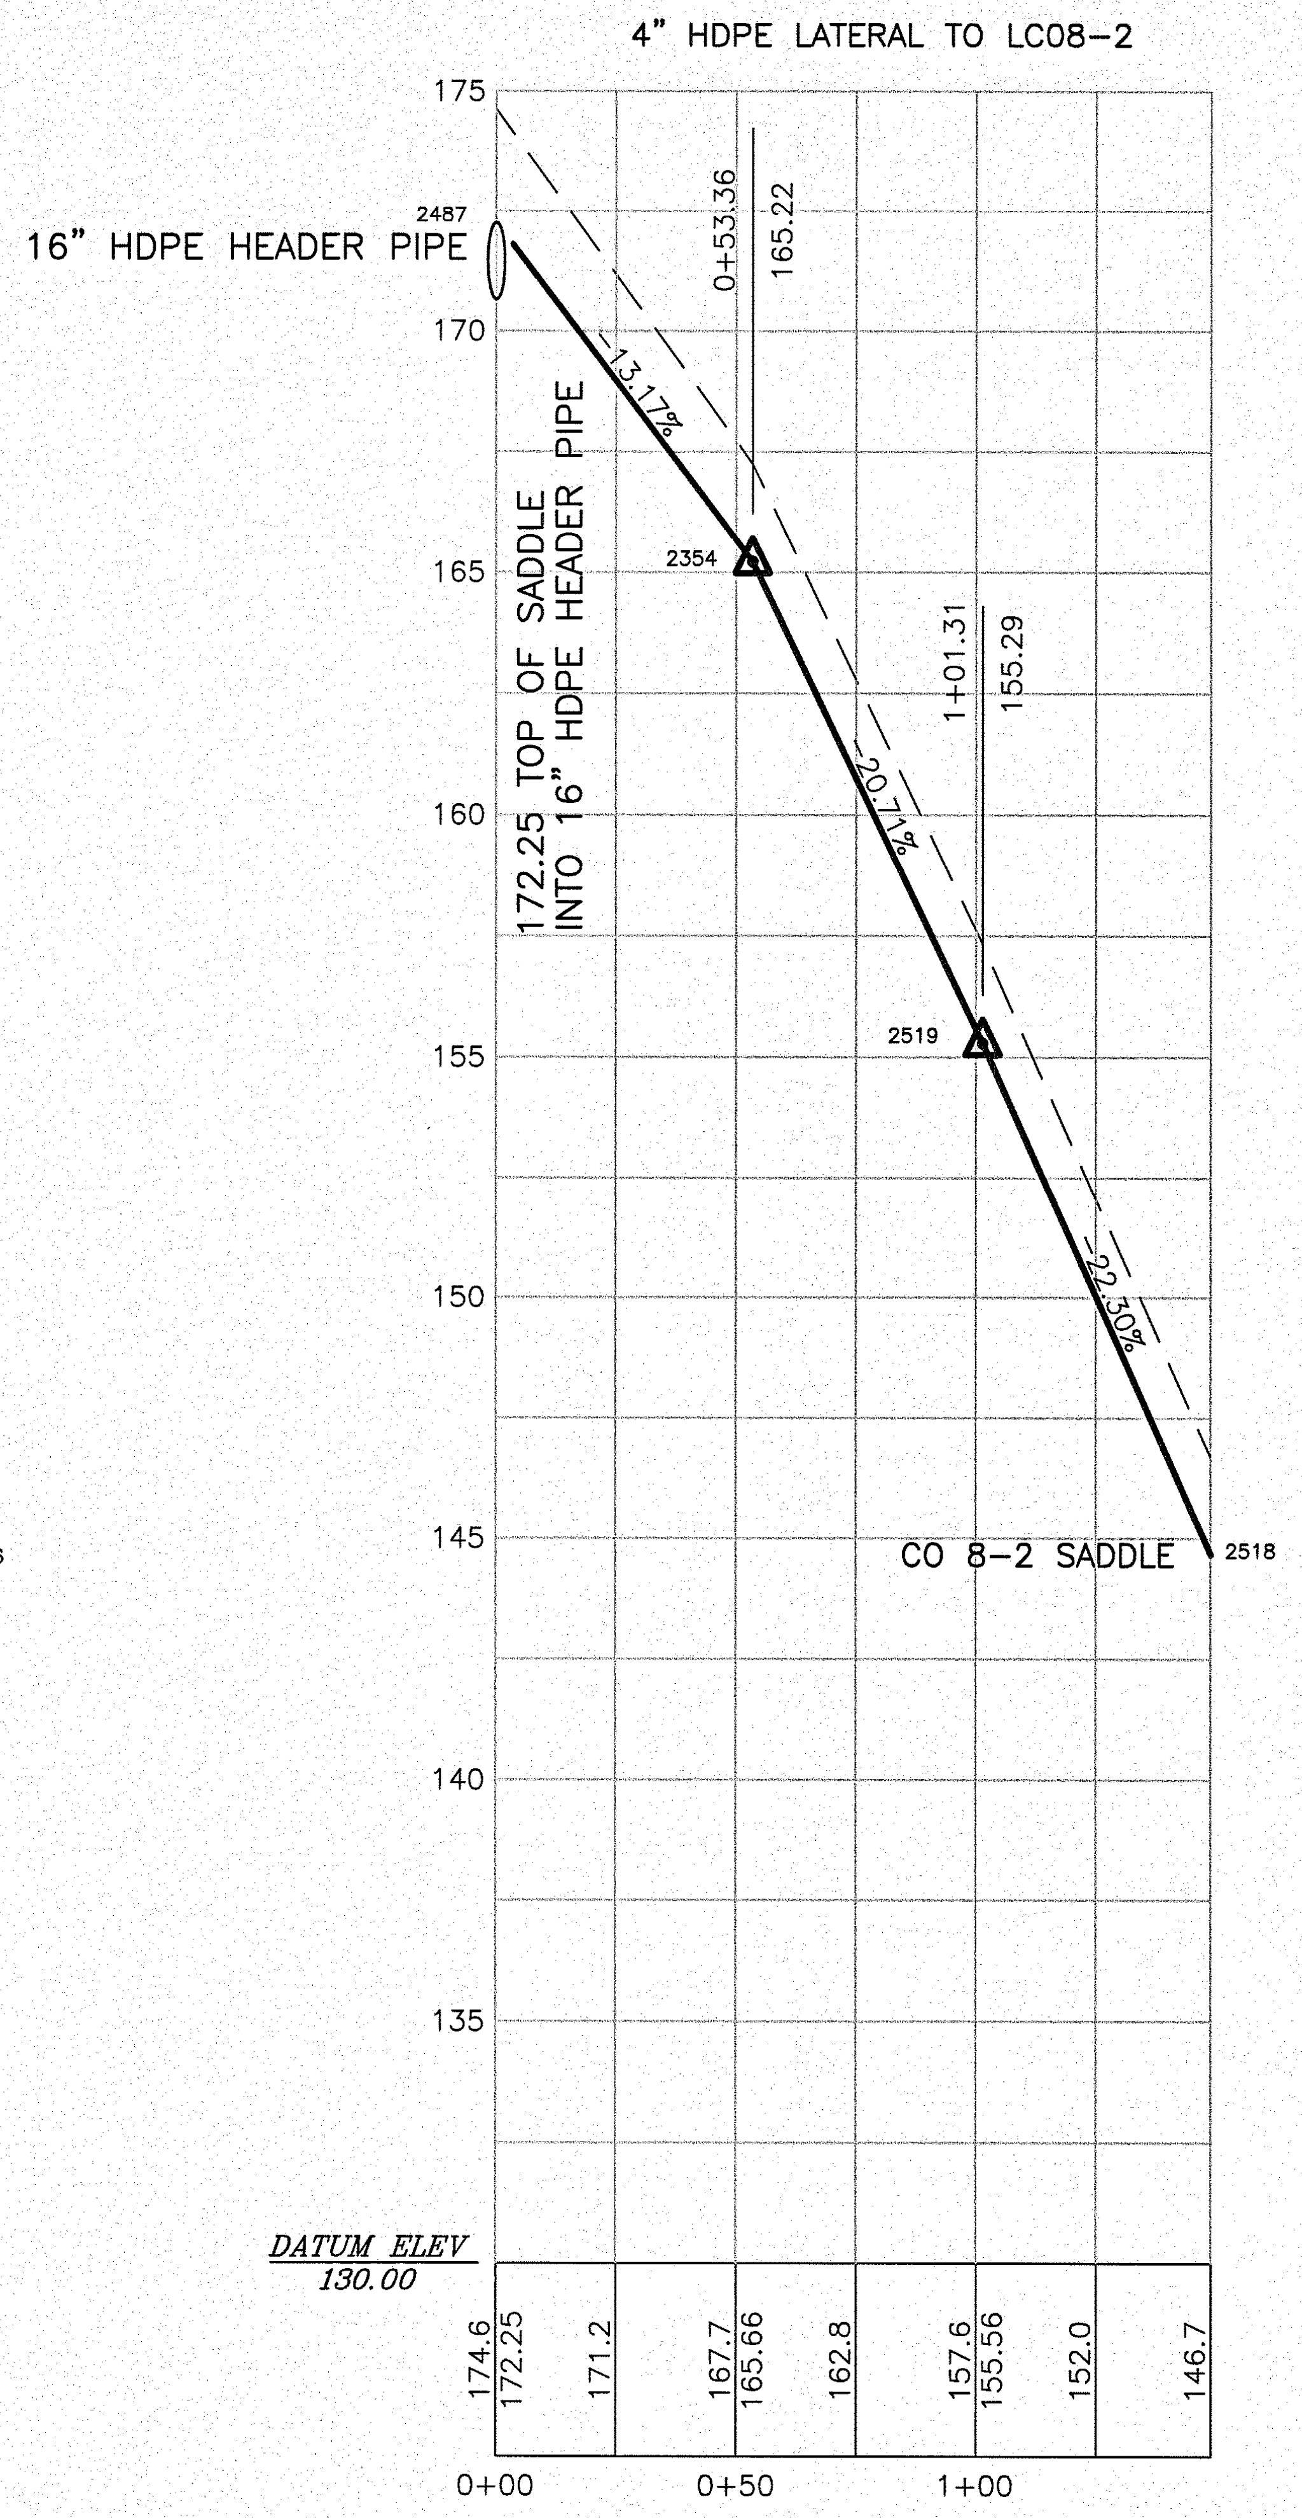

1" = 4' VERTICAL

40 0 40 80

GRAPHIC SCALE : 1 INCH = 40 FT.

CONTRACTOR

SOUTHEAST ENIRONMENTAL CONTRACTING, INC.

5667 VAL DEL ROAD, HAHIRA, GA 31632
229-794-3330 FAX 229-794-3332

DESIGN ENGINEER

SCS ENGINEERS

STEARNS, CONRAD AND SCHMIDT
CONSULTING ENGINEERS
4041 PARK OAKS BLVD., SUITE 100, TAMPA, FL 33610
813 621-0080 FAX 813 623-6757
FLORIDA CERTIFICATE OF AUTHORIZATION NO. 00004892

FLORIDA DEPARTMENT OF ENVIRONMENTAL PROTECTION
APR 16 2010
SOUTHWEST DISTRICT
TAMPA

Barbara L Herring
BARBARA L. HERRING, PSM #6194
DATE: 12-16-09

REV	DATE	DESCRIPTION	BY
△			
△			
△			
△			
△			
△			

BARBARA L.HERRING, RLS
LICENSE NO. 6194

DRAWING TITLE

PIPE PROFILES

PROJECT TITLE

**SOUTHEAST COUNTY LANDFILL
LANDFILL GAS COLLECTION
AND CONTROL SYSTEM PROJECT**

CLIENT

**HILLSBOROUGH COUNTY
SOLID WASTE
MANAGEMENT DEPARTMENT
TAMPA, FLORIDA**

SOUTHEASTERN SURVEYING, INC.

601 N. ST. AUGUSTINE RD., VALDOSTA, GA 31601
229-259-9455 FAX 229-259-9926
FLORIDA CERTIFICATE OF AUTHORIZATION NO. 00007091

PROJ. NO. 09207055.00
DWN. BY: BLH
Q/A RVW BY:
DSN. BY: BLH
CHK. BY: BLH
APP. BY:

CADD FILE:
PROFILE 40 SCALE

DATE:
DECEMBER 16, 2009

SCALE:
1" = 40'

DRAWING NO.

38