
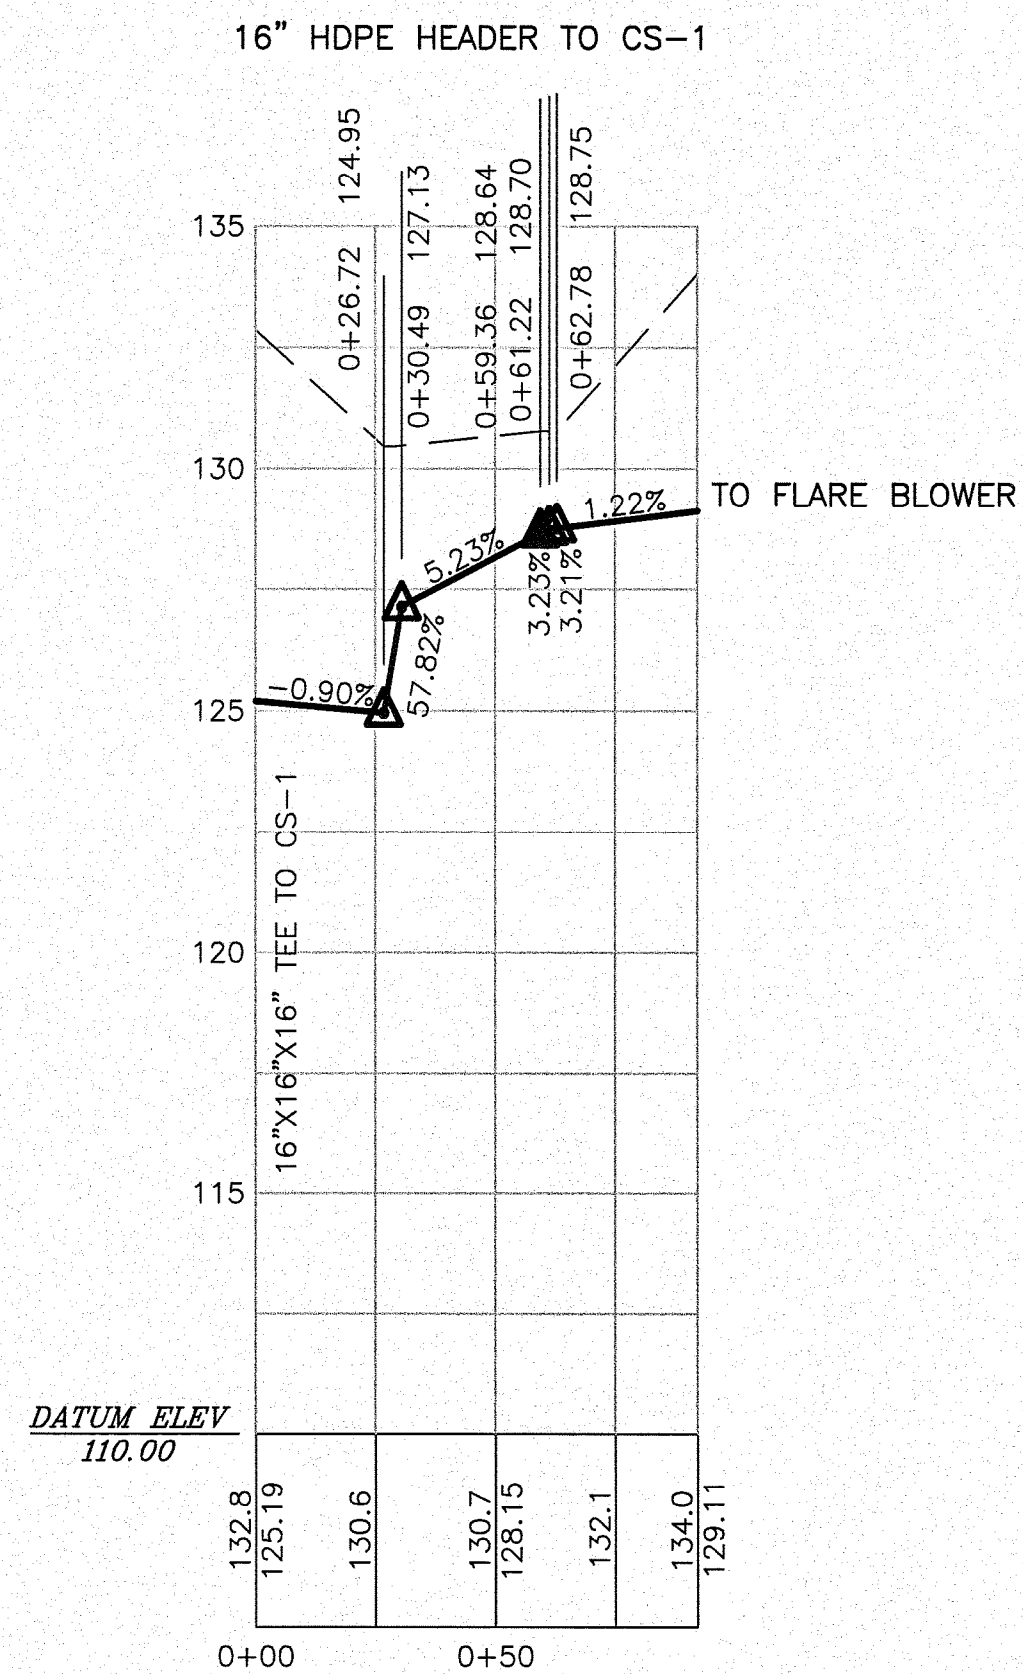


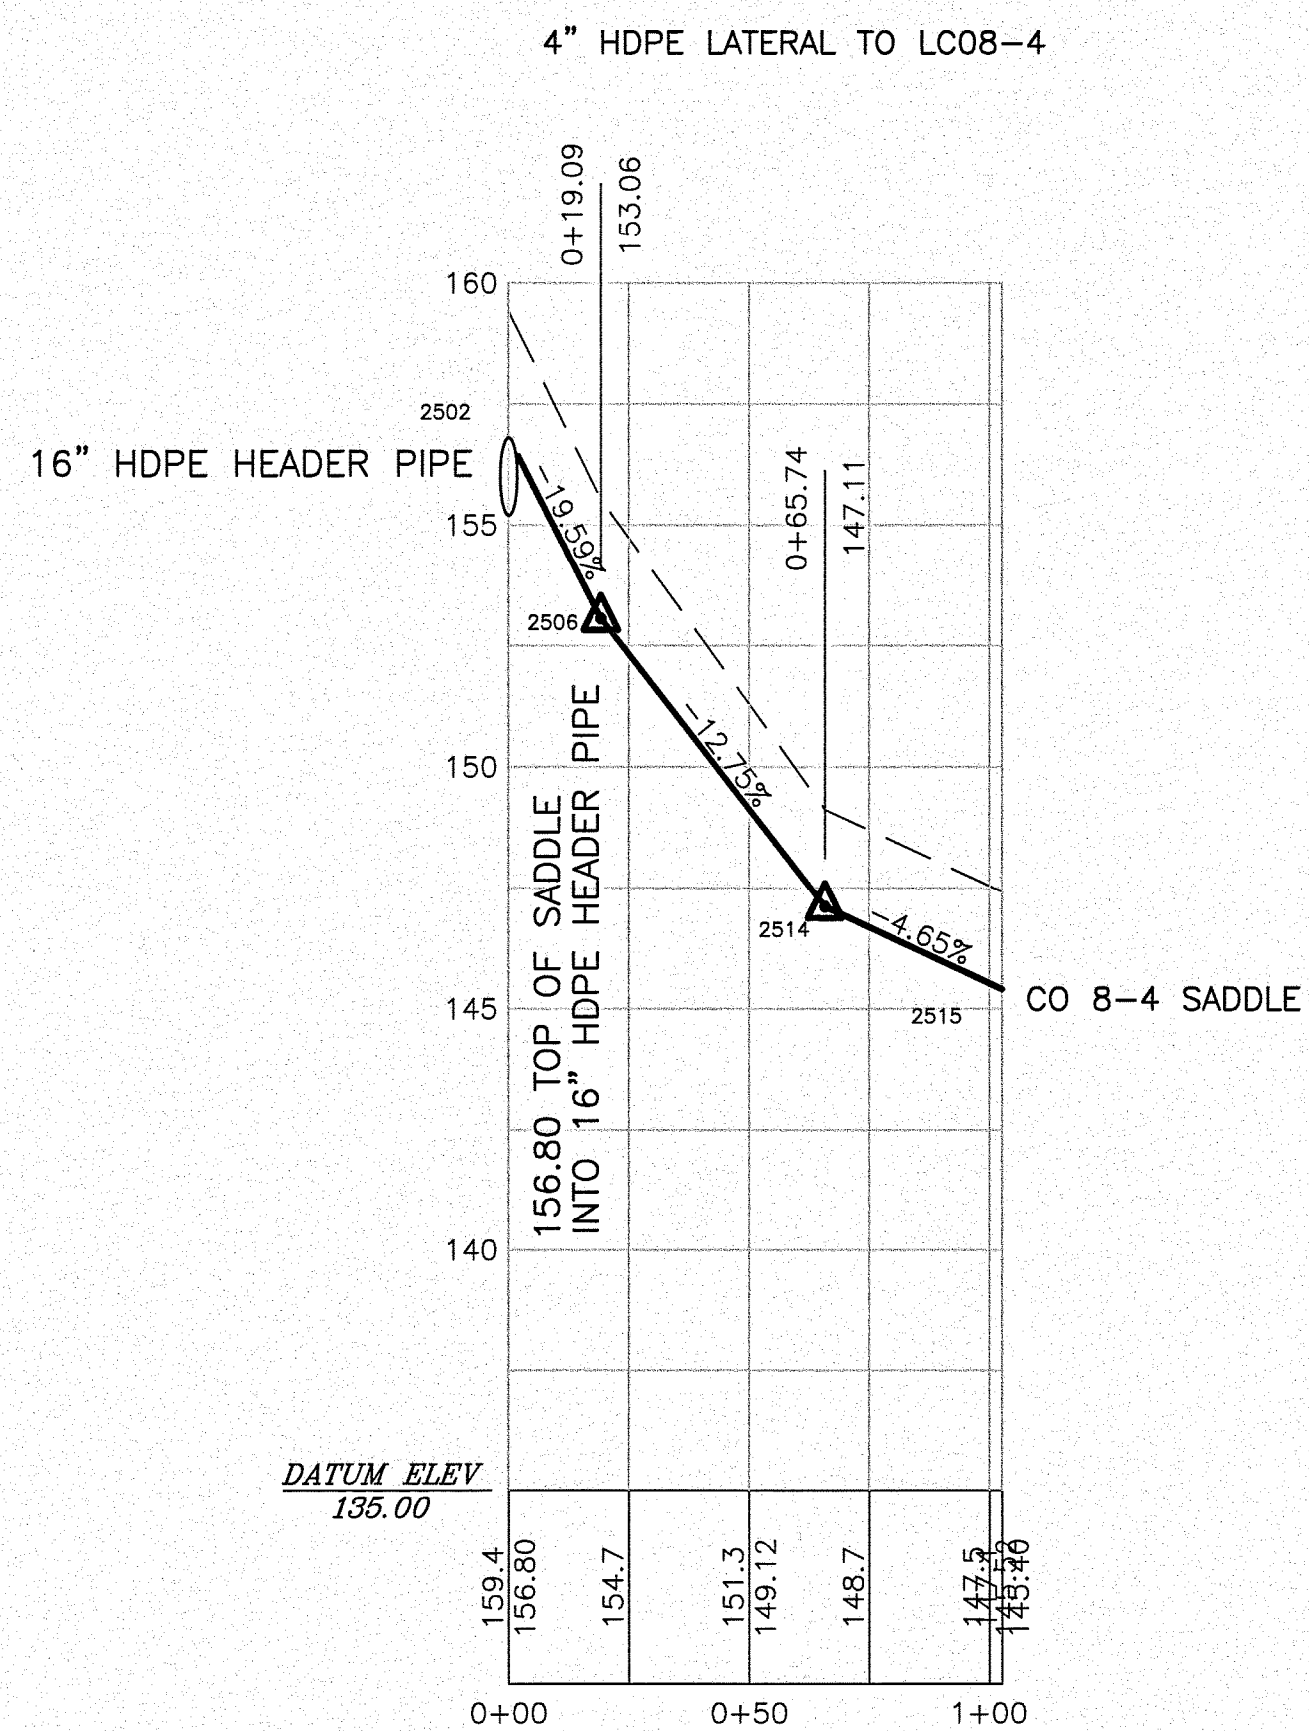

DESIGN ENGINEER
SCS ENGINEERS
STEARNS, CONRAD AND SCHMIDT
CONSULTING ENGINEERS
4041 PARK OAKS BLVD., SUITE 100, TAMPA, FL 33610
813 621-0080 FAX 813 623-6757
FLORIDA CERTIFICATE OF AUTHORIZATION NO. 00004892

SOUTHEASTERN SURVEYING, INC. 801 N. ST. AUGUSTINE RD., VALDOSTA, GA 31601 229-259-5455 FAX 229-259-9265 FLORIDA CERTIFICATE OF AUTHORIZATION NO. 00007091 FRODO. NO. TS&N - BL/H DWN. BY: BL/H S/A R/W BY: BL/H 09/20/7055.00 CHK. TYP. APP. BY:	CLIENT HILLSBOROUGH COUNTY SOLID WASTE MANAGEMENT DEPARTMENT TAMPA, FLORIDA	DRAWING TITLE PIPE PROFILES PROJECT TITLE SOUTHEAST COUNTY LANDFILL LANDFILL GAS COLLECTION AND CONTROL SYSTEM PROJECT	REV	DATE	DESCRIPTION	BY
			△			
			△			
			△			
			△			
			△			BARBARA L HERRING, RLS LICENSE NO. 6194