


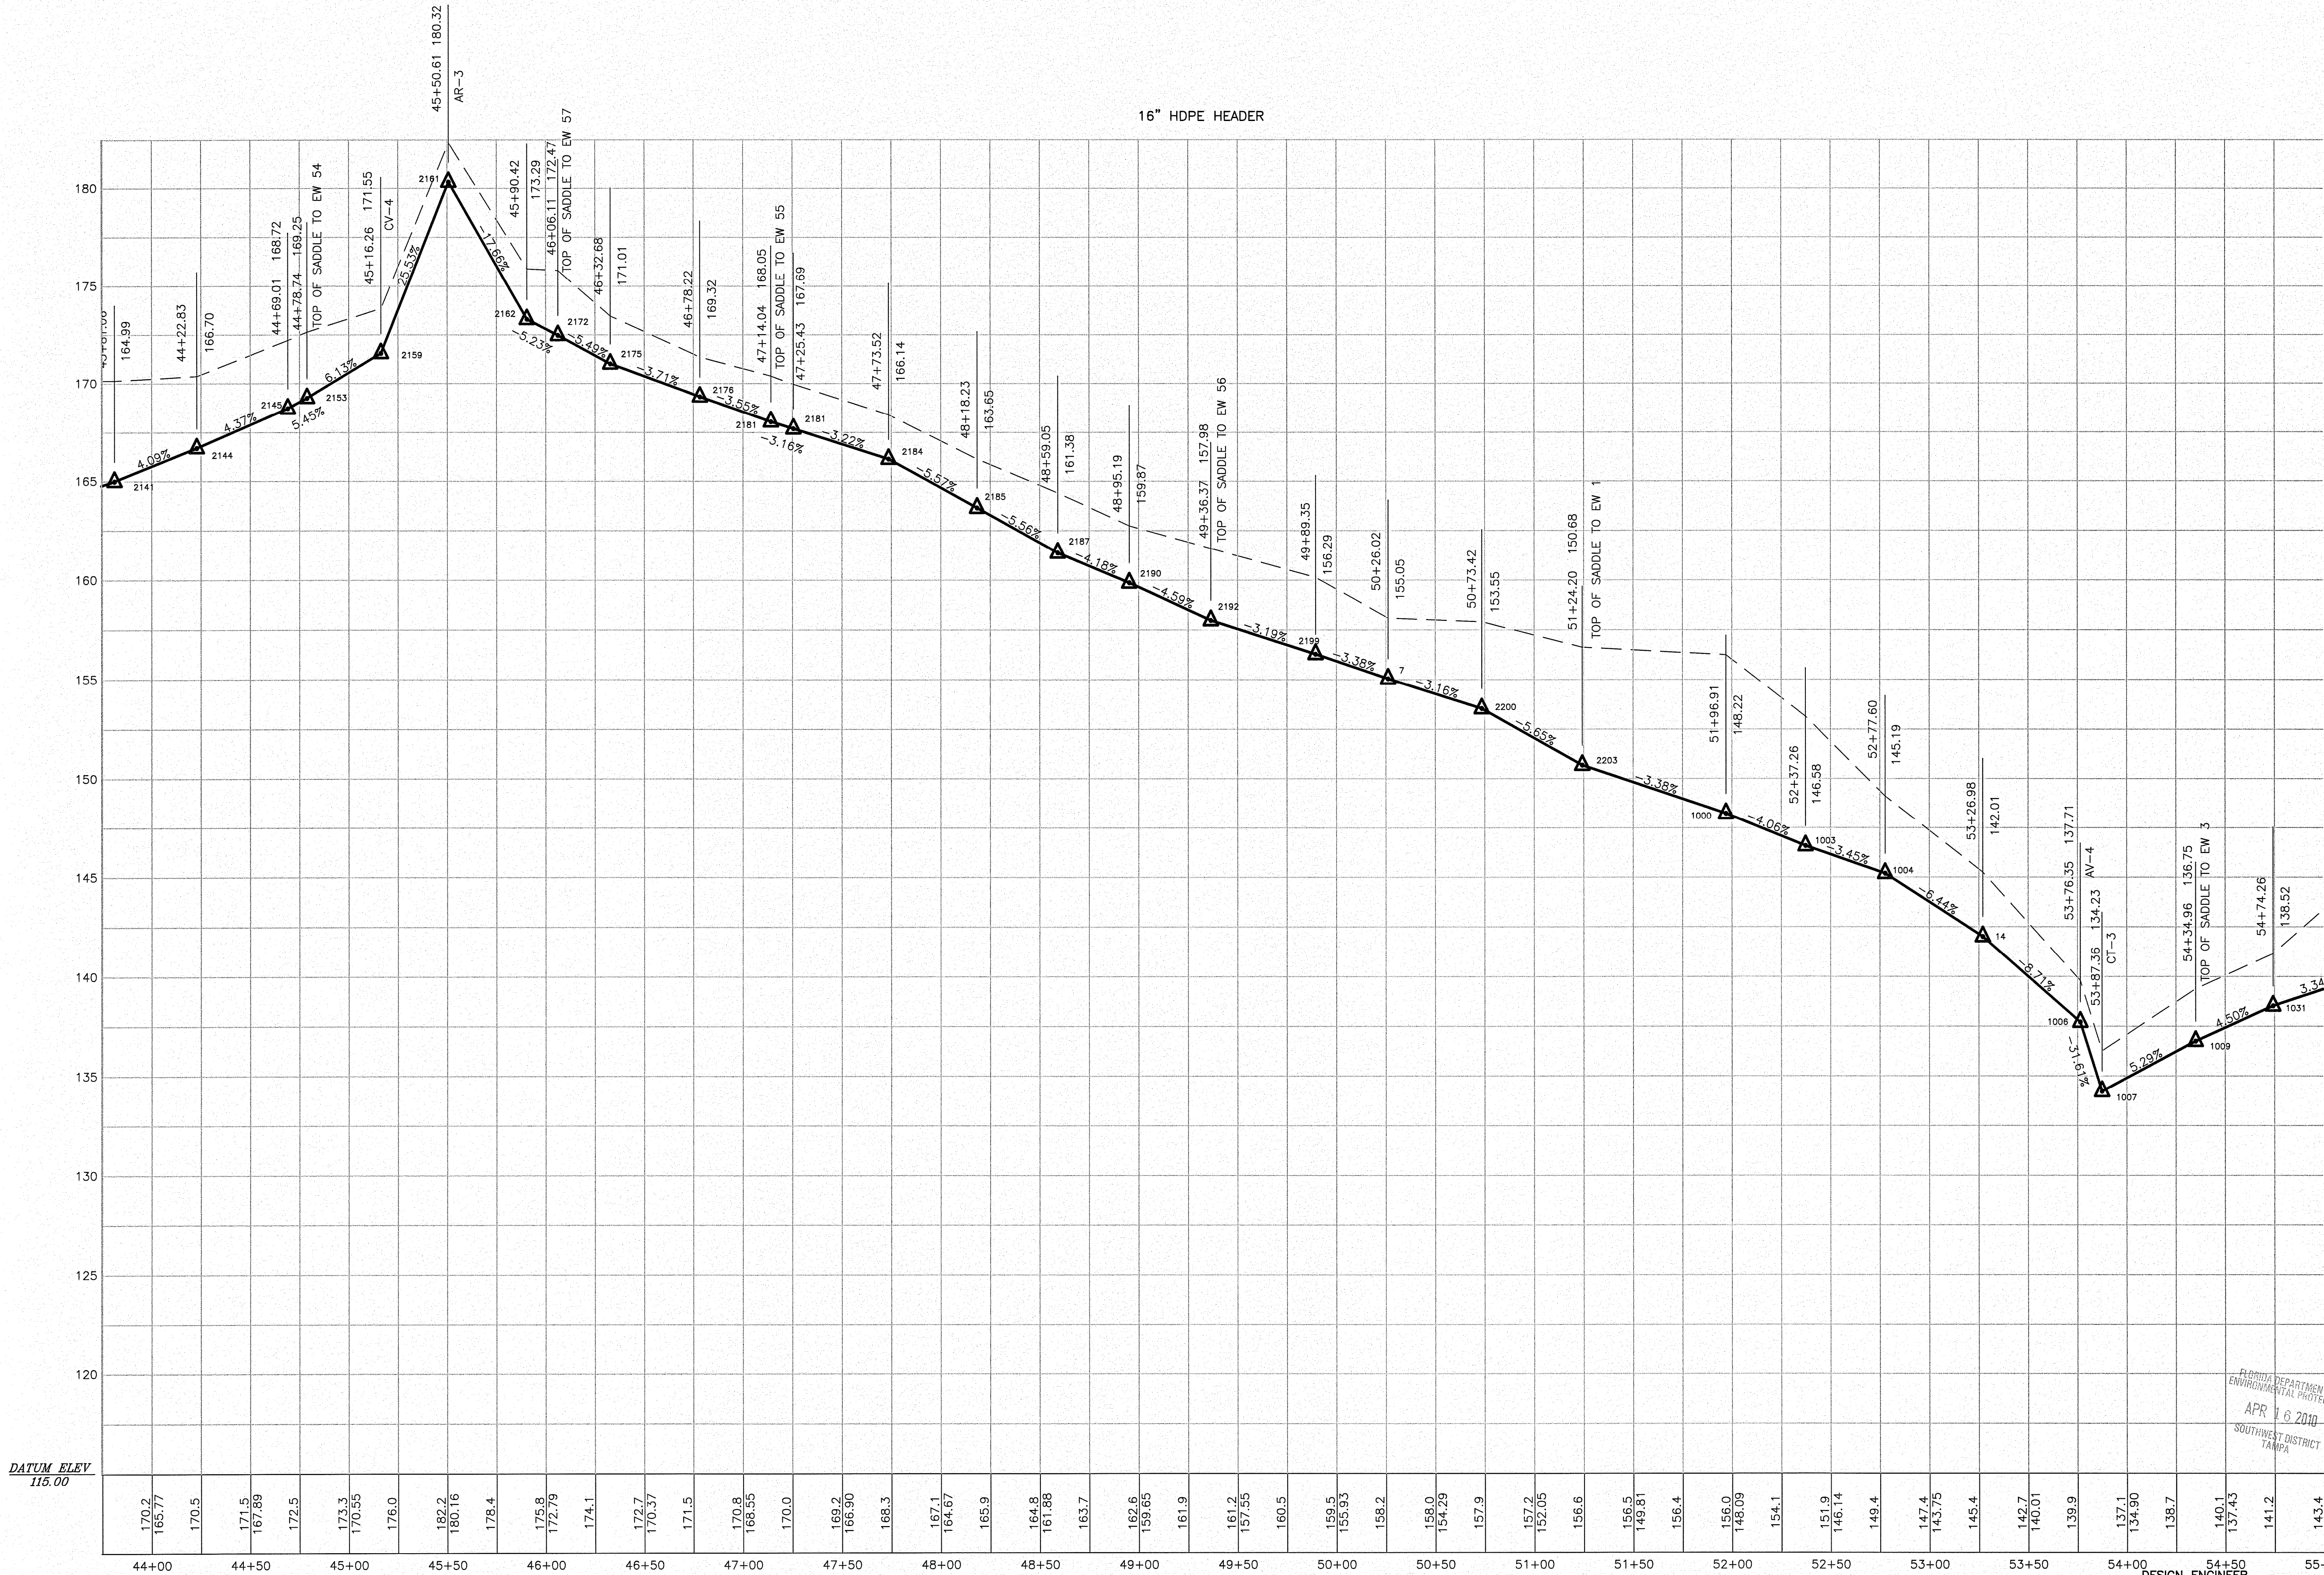

*Barbara L. Herring*  
BARBARA L. HERRING, PSM #6194  
DATE: 12-16-09

CONTRACTOR  
**SOUTHEAST ENIRONMENTAL  
CONTRACTING, INC.**  
5667 VAL DEL ROAD, HAHIRA, GA 31632  
229-794-3330 FAX 229-794-3332

DESIGN ENGINEER  
**SCS ENGINEERS**  
STEARNS, CONRAD AND SCHMIDT  
CONSULTING ENGINEERS  
4041 PARK OAKS BLVD., SUITE 100, TAMPA, FL 33610  
813 821-0080 FAX 813 822-6757  
FLORIDA CERTIFICATE OF AUTHORIZATION NO. 00004892

|             |  
|-------------|--|----------|--|-------------------|--|-------------------|--|---|--|-------------------------------------------------------------------------------|--|------------------------------------------------------------------------------------|--|-----|--|------|--|-------------|--|---------------------------------------------|--|
| DRAWING NO. |  | SCALE:   |  | DATE:             |  | CADD FILE:        |  | SOUTHEASTERN SURVEYING, INC.   |  | CLIENT                                                                        |  | DRAWING TITLE                                                                      |  | REV |  | DATE |  | DESCRIPTION |  | BY                                          |  |
| 30          |  | 1" = 40' |  | DECEMBER 16, 2009 |  | PROFILE: 40 SCALE |  | 901 A ST. AUGUSTINE RD., VALDOSTA, GA 31601<br>229-259-9465 FAX 229-259-9626<br>FLORIDA CERTIFICATE OF AUTHORIZATION NO. 00007091 |  | HILLSBOROUGH COUNTY<br>SOLID WASTE<br>MANAGEMENT DEPARTMENT<br>TAMPA, FLORIDA |  | PIPE PROFILES                                                                      |  | △   |  | △    |  | △           |  | △                                           |  |
|             |  |          |  |                   |  |                   |  | PROJ. NO. 09207055.00<br>DGN. BFL BLH<br>C/A RWM BFL                                                                              |  |                                                                               |  | PROJECT TITLE                                                                      |  | △   |  | △    |  | △           |  | △                                           |  |
|             |  |          |  |                   |  |                   |  |   |  |                                                                               |  | SOUTHEAST COUNTY LANDFILL<br>LANDFILL GAS COLLECTION<br>AND CONTROL SYSTEM PROJECT |  | △   |  | △    |  | △           |  | △                                           |  |
|             |  |          |  |                   |  |                   |  |   |  |                                                                               |  |                                                                                    |  | △   |  | △    |  | △           |  | BARBARA L. HERRING, RLS<br>LICENSE NO. 6194 |  |