

STAFF GAUGES (ELEVATIONS AND LOCATIONS)						
STW-1	LAT. 27°12' 20.29997" N	LON. 82°23' 44.70003" W	N 1044126.72	E 527537.34	EL.=21.187	60 D NAIL SET 3 MARK
STW-2	LAT. 27°11' 59.30004" N	LON. 82°23' 51.10018" W	N 1042008.01	E 526952.77	EL.=20.305	60 D NAIL SET 4 MARK
STW-3	LAT. 27°11' 35.99997" N	LON. 82°23' 46.09994" W	N 1039653.78	E 527396.81	EL.=20.191	60 D NAIL SET 4 MARK
STW-4	LAT. 27°11' 26.30003" N	LON. 82°23' 40.70000" W	N 1038672.76	E 527881.32	EL.=19.342	60 D NAIL SET 4 MARK
STW-5A	LAT. 27°11' 26.20004" N	LON. 82°23' 25.80000" W	N 1038658.45	E 529226.73	EL.=19.788	60 D NAIL SET 4 MARK
STW-6	LAT. 27°11' 17.60004" N	LON. 82°23' 03.79996" W	N 1037783.90	E 531210.63	EL.=19.37	60 D NAIL SET 4 MARK
STW-7	LAT. 27°11' 47.69996" N	LON. 82°22' 41.50005" W	N 1040817.21	E 533233.48	EL.=22.287	60 D NAIL SET 4 MARK
STW-1A	LAT. 27°12' 25.36691" N	LON. 82°23' 44.09811" W	N 1044638.2	E 527593.3	EL.=21.23	4 MARK ON GAUGE
STW-2A	LAT. 27°12' 06.68149" N	LON. 82°23' 49.08702" W	N 1042752.8	E 527136.9	EL.=20.18	5 MARK ON GAUGE
STW-3A	LAT. 27°11' 44.29897" N	LON. 82°23' 41.54104" W	N 1040490.5	E 527811.1	EL.=18.43	4 MARK ON GAUGE
STW-4A	LAT. 27°11' 29.12034" N	LON. 82°23' 40.17525" W	N 1038957.4	E 527929.6	EL.=17.35	4 MARK ON GAUGE
STW-5B	LAT. 27°11' 29.26687" N	LON. 82°23' 25.32995" W	N 1038968.0	E 529270.5	EL.=18.04	4 MARK ON GAUGE
STW-6A	LAT. 27°11' 22.06970" N	LON. 82°23' 01.85435" W	N 1038234.7	E 531387.7	EL.=17.67	5 MARK ON GAUGE
STW-7A	LAT. 27°11' 47.77891" N	LON. 82°22' 30.14043" W	N 1040822.1	E 534259.2	EL.=19.02	4 MARK ON GAUGE

PIEZOMETER WELLS					
MW-3	LAT. 27°12' 00.10000" N	LON. 82°22' 36.50000" W	N 1042067.983	E 533688.714	TOP OF CASING EL.=23.34
MW-5	LAT. 27°11' 47.70000" N	LON. 82°22' 26.30000" W	N 1040813.096	E 534605.941	TOP OF CASING EL.=23.19


PIEZOMETER WELLS - PHASE II					
P-5-1	LAT. 27°12' 16.13612" N	LON. 82°23' 41.74957" W	N 1043705.42	E 527802.40	TOP OF CASING EL.=25.85 GROUND SURFACE EL.=23.60
P-5-2	LAT. 27°12' 14.83624" N	LON. 82°23' 31.16288" W	N 1043571.16	E 528757.83	TOP OF CASING EL.=26.457 GROUND SURFACE EL.=23.90
P-5-3	LAT. 27°12' 06.85829" N	LON. 82°23' 37.48724" W	N 1042767.35	E 528184.29	TOP OF CASING EL.=26.267 GROUND SURFACE EL.=23.50
P-5-4	LAT. 27°12' 05.84257" N	LON. 82°23' 44.29600" W	N 1043666.72	E 527569.21	TOP OF CASING EL.=26.003 GROUND SURFACE EL.=23.40
P-D-1(SHALLOW)	LAT. 27°12' 11.62889" N	LON. 82°23' 38.80118" W	N 1043249.45	E 528067.17	TOP OF CASING EL.=26.487 GROUND SURFACE EL.=23.40
P-D-1(DEEP)	LAT. 27°12' 11.39723" N	LON. 82°23' 38.81222" W	N 1043226.06	E 528066.10	TOP OF CASING EL.=26.237 GROUND SURFACE EL.=23.30
P-D-2(SHALLOW)	LAT. 27°12' 04.72867" N	LON. 82°23' 31.92717" W	N 1042550.73	E 528685.63	TOP OF CASING EL.=26.114 GROUND SURFACE EL.=23.60
P-D-2(DEEP)	LAT. 27°12' 04.64686" N	LON. 82°23' 31.99987" W	N 1042542.49	E 528679.04	TOP OF CASING EL.=25.804 GROUND SURFACE EL.=23.30

MONITORING WELLS					
MW-1R	LAT. 27°12' 19.78765" N	LON. 82°23' 03.60796" W	N 1044063.44	E 531247.22	TOP OF CASING EL.=24.428
MW-8A	LAT. 27°12' 03.17721" N	LON. 82°23' 12.23027" W	N 1042388.54	E 530463.57	TOP OF CASING EL.=28.637
MW-9	LAT. 27°12' 03.22649" N	LON. 82°23' 20.61821" W	N 1042395.86	E 529706.24	TOP OF CASING EL.=35.112
MW-10R	LAT. 27°12' 03.12655" N	LON. 82°23' 26.21601" W	N 1042392.39	E 529200.80	TOP OF CASING EL.=31.792
MW-15	LAT. 27°12' 03.28496" N	LON. 82°23' 31.40745" W	N 1042404.8	E 528732.1	TOP OF CASING EL.=44.32
MW-16	LAT. 27°12' 03.32557" N	LON. 82°23' 37.41159" W	N 1042410.6	E 528190.0	TOP OF CASING EL.=43.73
MW-17	LAT. 27°12' 03.58818" N	LON. 82°23' 43.68232" W	N 1042438.9	E 527623.9	TOP OF CASING EL.=46.15
MW-18	LAT. 27°12' 06.34977" N	LON. 82°23' 47.32484" W	N 1042718.8	E 527295.9	TOP OF CASING EL.=39.14
MW-19	LAT. 27°12' 10.45660" N	LON. 82°23' 44.86950" W	N 1043132.8	E 527518.9	TOP OF CASING EL.=36.81
MW-20	LAT. 27°12' 16.34699" N	LON. 82°23' 44.85929" W	N 1043727.6	E 527521.7	TOP OF CASING EL.=35.96

COMPLIANCE WELLS					
CW-8A	LAT. 27°12' 02.89428" N	LON. 82°23' 12.58659" W	N 1042360.07	E 530431.31	TOP OF CASING EL.=26.132
CW-9	LAT. 27°12' 02.77901" N	LON. 82°23' 21.24197" W	N 1042350.85	E 529649.78	TOP OF CASING EL.=26.582
CW-10R	LAT. 27°12' 02.71032" N	LON. 82°23' 26.49836" W	N 1042345.39	E 529175.16	TOP OF CASING EL.=26.982

SURVEYOR'S NOTES

- THIS IS NOT A BOUNDARY SURVEY.
- ADDITIONS OR DELETIONS TO THE SURVEY MAP BY OTHER THAN THE SIGNING PARTY IS PROHIBITED WITHOUT THE WRITTEN CONSENT OF THE SIGNING PARTY.
- ELEVATIONS ARE BASED ON SARASOTA COUNTY BENCHMARK NUMBER 363, ELEVATION BEING 15.261 FEET N.G.V.D. 1929.
- THIS SPECIFIC PURPOSE SURVEY WAS PERFORMED TO SET TEMPORARY BENCHMARKS AND ESTABLISH ELEVATIONS AT STAFF GAUGES, PIEZOMETER WELLS AND MONITORING WELLS LYING WITHIN THE CENTRAL COUNTY SOLID WASTE DISPOSAL COMPLEX LOCATED IN SECTIONS 2,3,10 & 11, TOWNSHIP 38 SOUTH, RANGE 18 EAST.

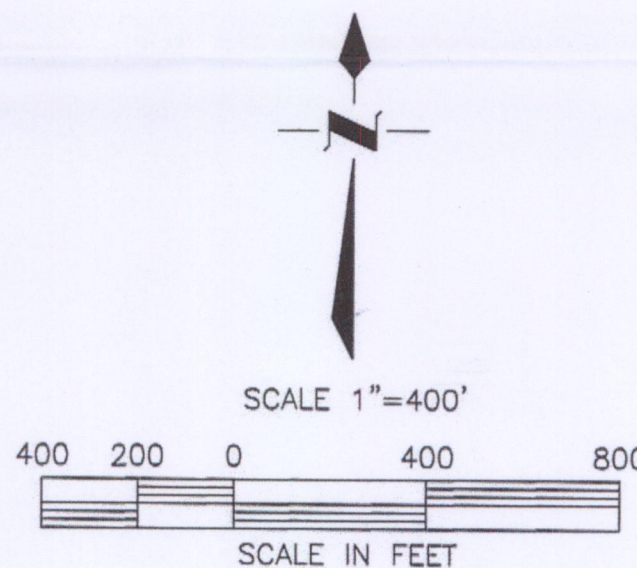

REVISION: REMOVED WELLS MW11-R, CW11-R & MW12-R. ADDED MW15, MW16, MW17, MW18, MW19, MW20 & STW-1A, STW-2A, STW-3A, STW-4A, STW-5B, STW-6A, STW-7A JRM 07-09-08
REVISION: UPDATED ELEVATION AND LOCATION ON MW-3 JRM 11-07-08
REVISION: ADDED LATITUDE AND LONGITUDE JRM 4-01-08

SPECIFIC PURPOSE SURVEY CENTRAL COUNTY SOLID WASTE DISPOSAL COMPLEX

PROJ. NO.: 08032	DWG DATE: 3-18-08	SHEET NO.
SEC: 2,3,10,11 TWP: 38 S. RGE: 18 E.	FIELD DATE: 3-14-08	1
FIELD BOOK 496 PAGE 73-76	DRAWN BY: J.R.M.	1
I:\PDSBC\SURVEY\Landfill_knights\Landfill_knights.dwg	CHECKED BY: T.O.	

