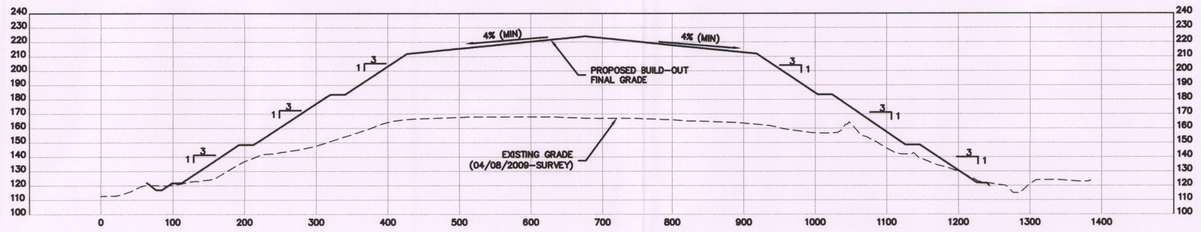

SECTION A/3

SCALE: 1"= 100' HORZ.
1"= 50' VERT.

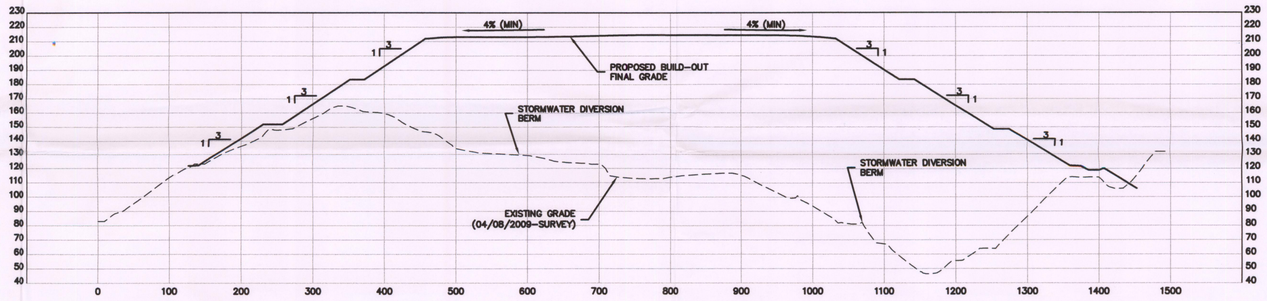

SECTION B/3

SCALE: 1"= 100' HORZ.
1"= 50' VERT.

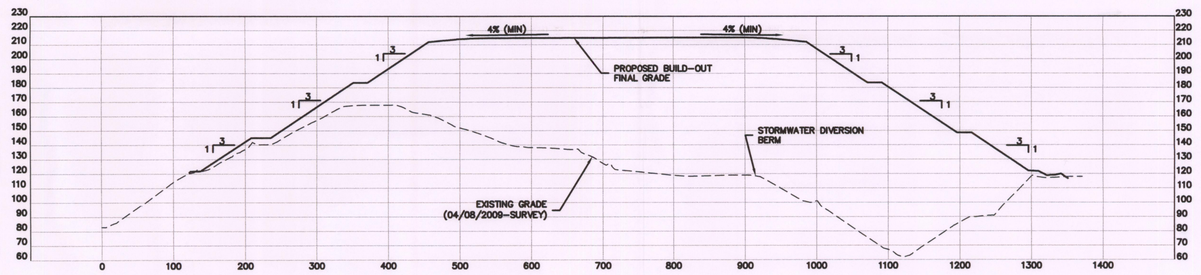

SECTION C/3

SCALE: 1"= 100' HORZ.
1"= 50' VERT.

These are all block references.

4921 Memorial Highway
One Memorial Center, Suite 300
Tampa, Florida 33634
Phone 813 880-8881
Fax 813 880-8882
www.kingengineering.com
Engineering License #2610

King
ENGINEERING ASSOCIATES, INC.

CITRUS COUNTY
CENTRAL LANDFILL
REMAINING CAPACITY REPORT

FOR

CITRUS COUNTY BOARD OF COUNTY COMMISSIONERS

NO.	DATE	DESCRIPTION	APPD BY

TITLE

FINAL BUILDOUT vs. 04/08/2009 SURVEY CROSS-SECTIONS

THE SIGNATURE OF THE QUALITY CONTROL OFFICER IN THIS SPACE INDICATES THAT ALL REQUIRED PERMITS HAVE BEEN OBTAINED AND THAT CONSTRUCTION IS AUTHORIZED TO COMMENCE.

PROFESSIONAL SEAL

JOB NO.	SHEET NO.
4217-003-001	5
DATE: MAY 2009	OF 6
SCALE: AS SHOWN	

D:\ENV_ENG\4217\000\00\cad\dwgs\2009 APPSECTIONS 2009-04.dwg, June 18, 2009 11:01 AM, CS, King Engineering Associate Inc.
Copyright © 2009 King Engineering Associates, Inc. All rights reserved. The reproduction, alteration or use, in whole or in part, of this design, plan or drawing without the prior written consent of King Engineering Associates, Inc. is prohibited by law. Any unauthorized reuse will be fully prosecuted. Use of this design, plan or drawing is limited to the purposes and the parties for which it was prepared and publication thereof is expressly limited to such use. Reproduction or publication by any person or entity, for any purpose, is prohibited. Title to the data and drawings is retained by King Engineering Associates, Inc. Unauthorized use of this design, plan or drawing shall be at the user's sole risk and without liability to King Engineering Associates, Inc. and user shall indemnify and hold King Engineering Associates, Inc. harmless from all claims, damages, losses and expenses including attorney's fees arising out of or resulting therefrom. Any unauthorized use, modification, or transfer to any other party of this design, plan or drawing which is not expressly authorized by King Engineering Associates, Inc. in writing shall be without liability to King Engineering Associates, Inc. and such unauthorized user shall indemnify and hold King Engineering Associates, Inc. harmless from all claims, damages, losses and expenses including attorney's fees arising out of or resulting therefrom.
CONSENT IS HEREBY GRANTED SPECIFICALLY TO GOVERNMENTAL AGENCIES TO REPRODUCE THIS DOCUMENT IN COMPLIANCE WITH F.S. CHAPTER 119.