
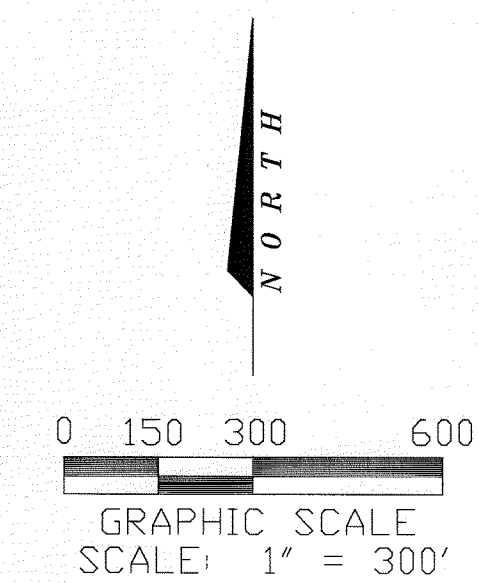


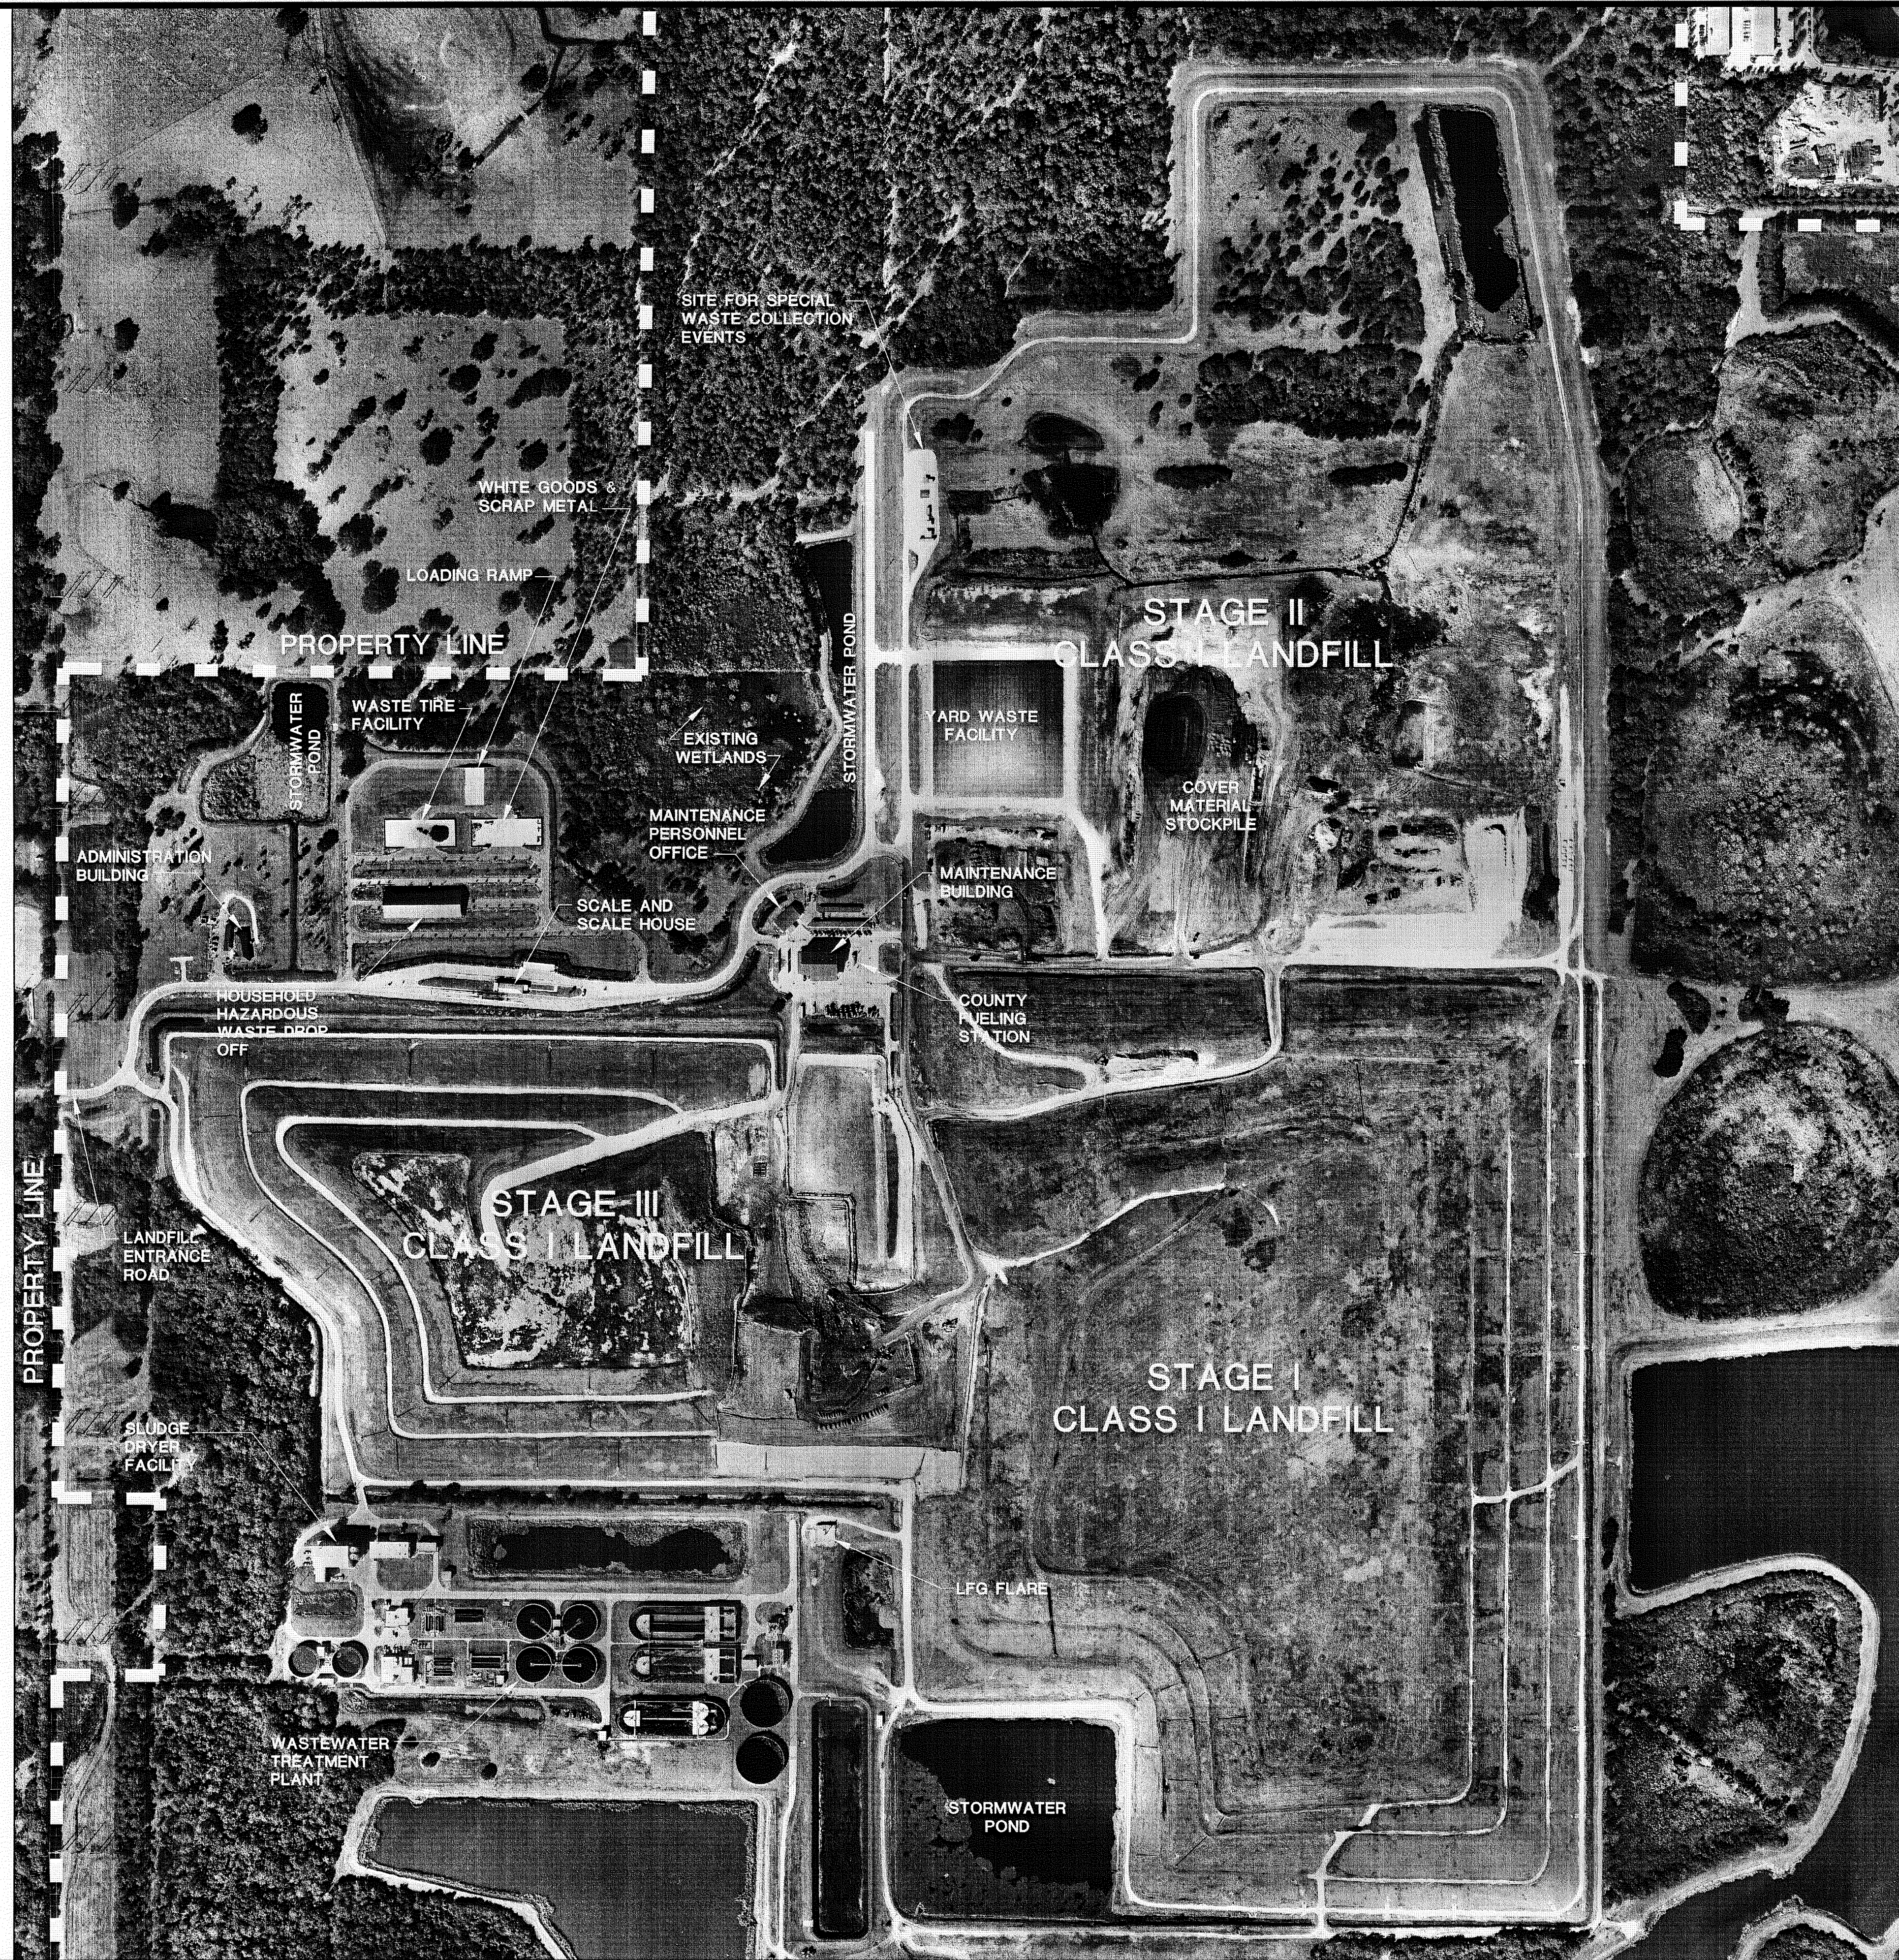

AERIAL PHOTOGRAPH PROVIDED BY:
I.F. ROOKS & ASSOCIATES, INC.
106 N.W. DRANE ST.
PLANT CITY, FL 33566
(813) 752-2113

DATE FLOWN: JANUARY 25, 2010

REPLACE 2009 AERIAL PHOTOGRAPHY
WITH 2010 AERIAL PHOTOGRAPHY

FLORIDA DEPARTMENT OF
ENVIRONMENTAL PROTECTION
MAY 18 2010
SOUTHWEST DISTRICT
TAMPA

C-2



482 South Keller Road
ORLANDO, FL 32810-6101
TEL. (407) 647-7275
FAX. (407) 647-0624
WWW.PBS&J.COM
POST BUCKLEY, SCHUH & JERNIGAN, Inc.
a/k/a PBS&J
5300 West Cypress Street Suite 200
Tampa, FL 33607
FBPR Certificate of Authorization No.: 24

CLIENT
**MANATEE COUNTY
BOARD OF COUNTY COMMISSIONERS**

PROJECT
**LENA ROAD LANDFILL
FILL SEQUENCE PLAN**

TASK
GENERAL SITE PLAN

ORIGINAL NOV. 2009
REVISIONS:
1. APRIL 2010
2.
3.
4.
5.

6.
7.
8.
9.
10.
11.
12.

Name: JOSEPH L. WILDER
Florida P.E. #16177
Address: PBS&J
482 S. Keller Road
Orlando, FL 32810-6101
Signature: [Signature]
Date: 05/11/2010

JOB NO. 100008517
DRAWN: RCC
DESIGN: RGC/JLM
CHECKED: JLM
Q.C.: DED
SHEET / #