
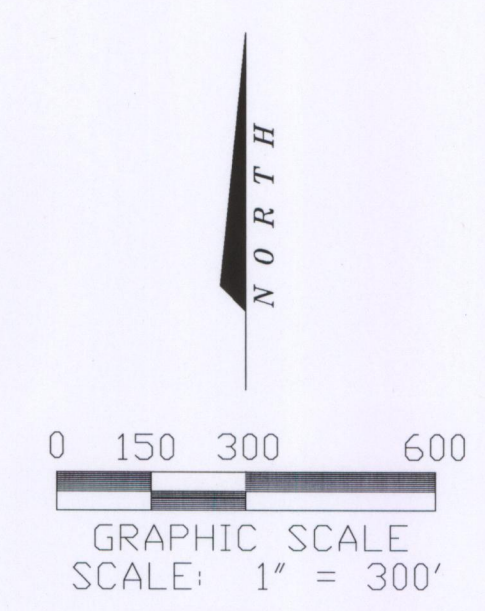


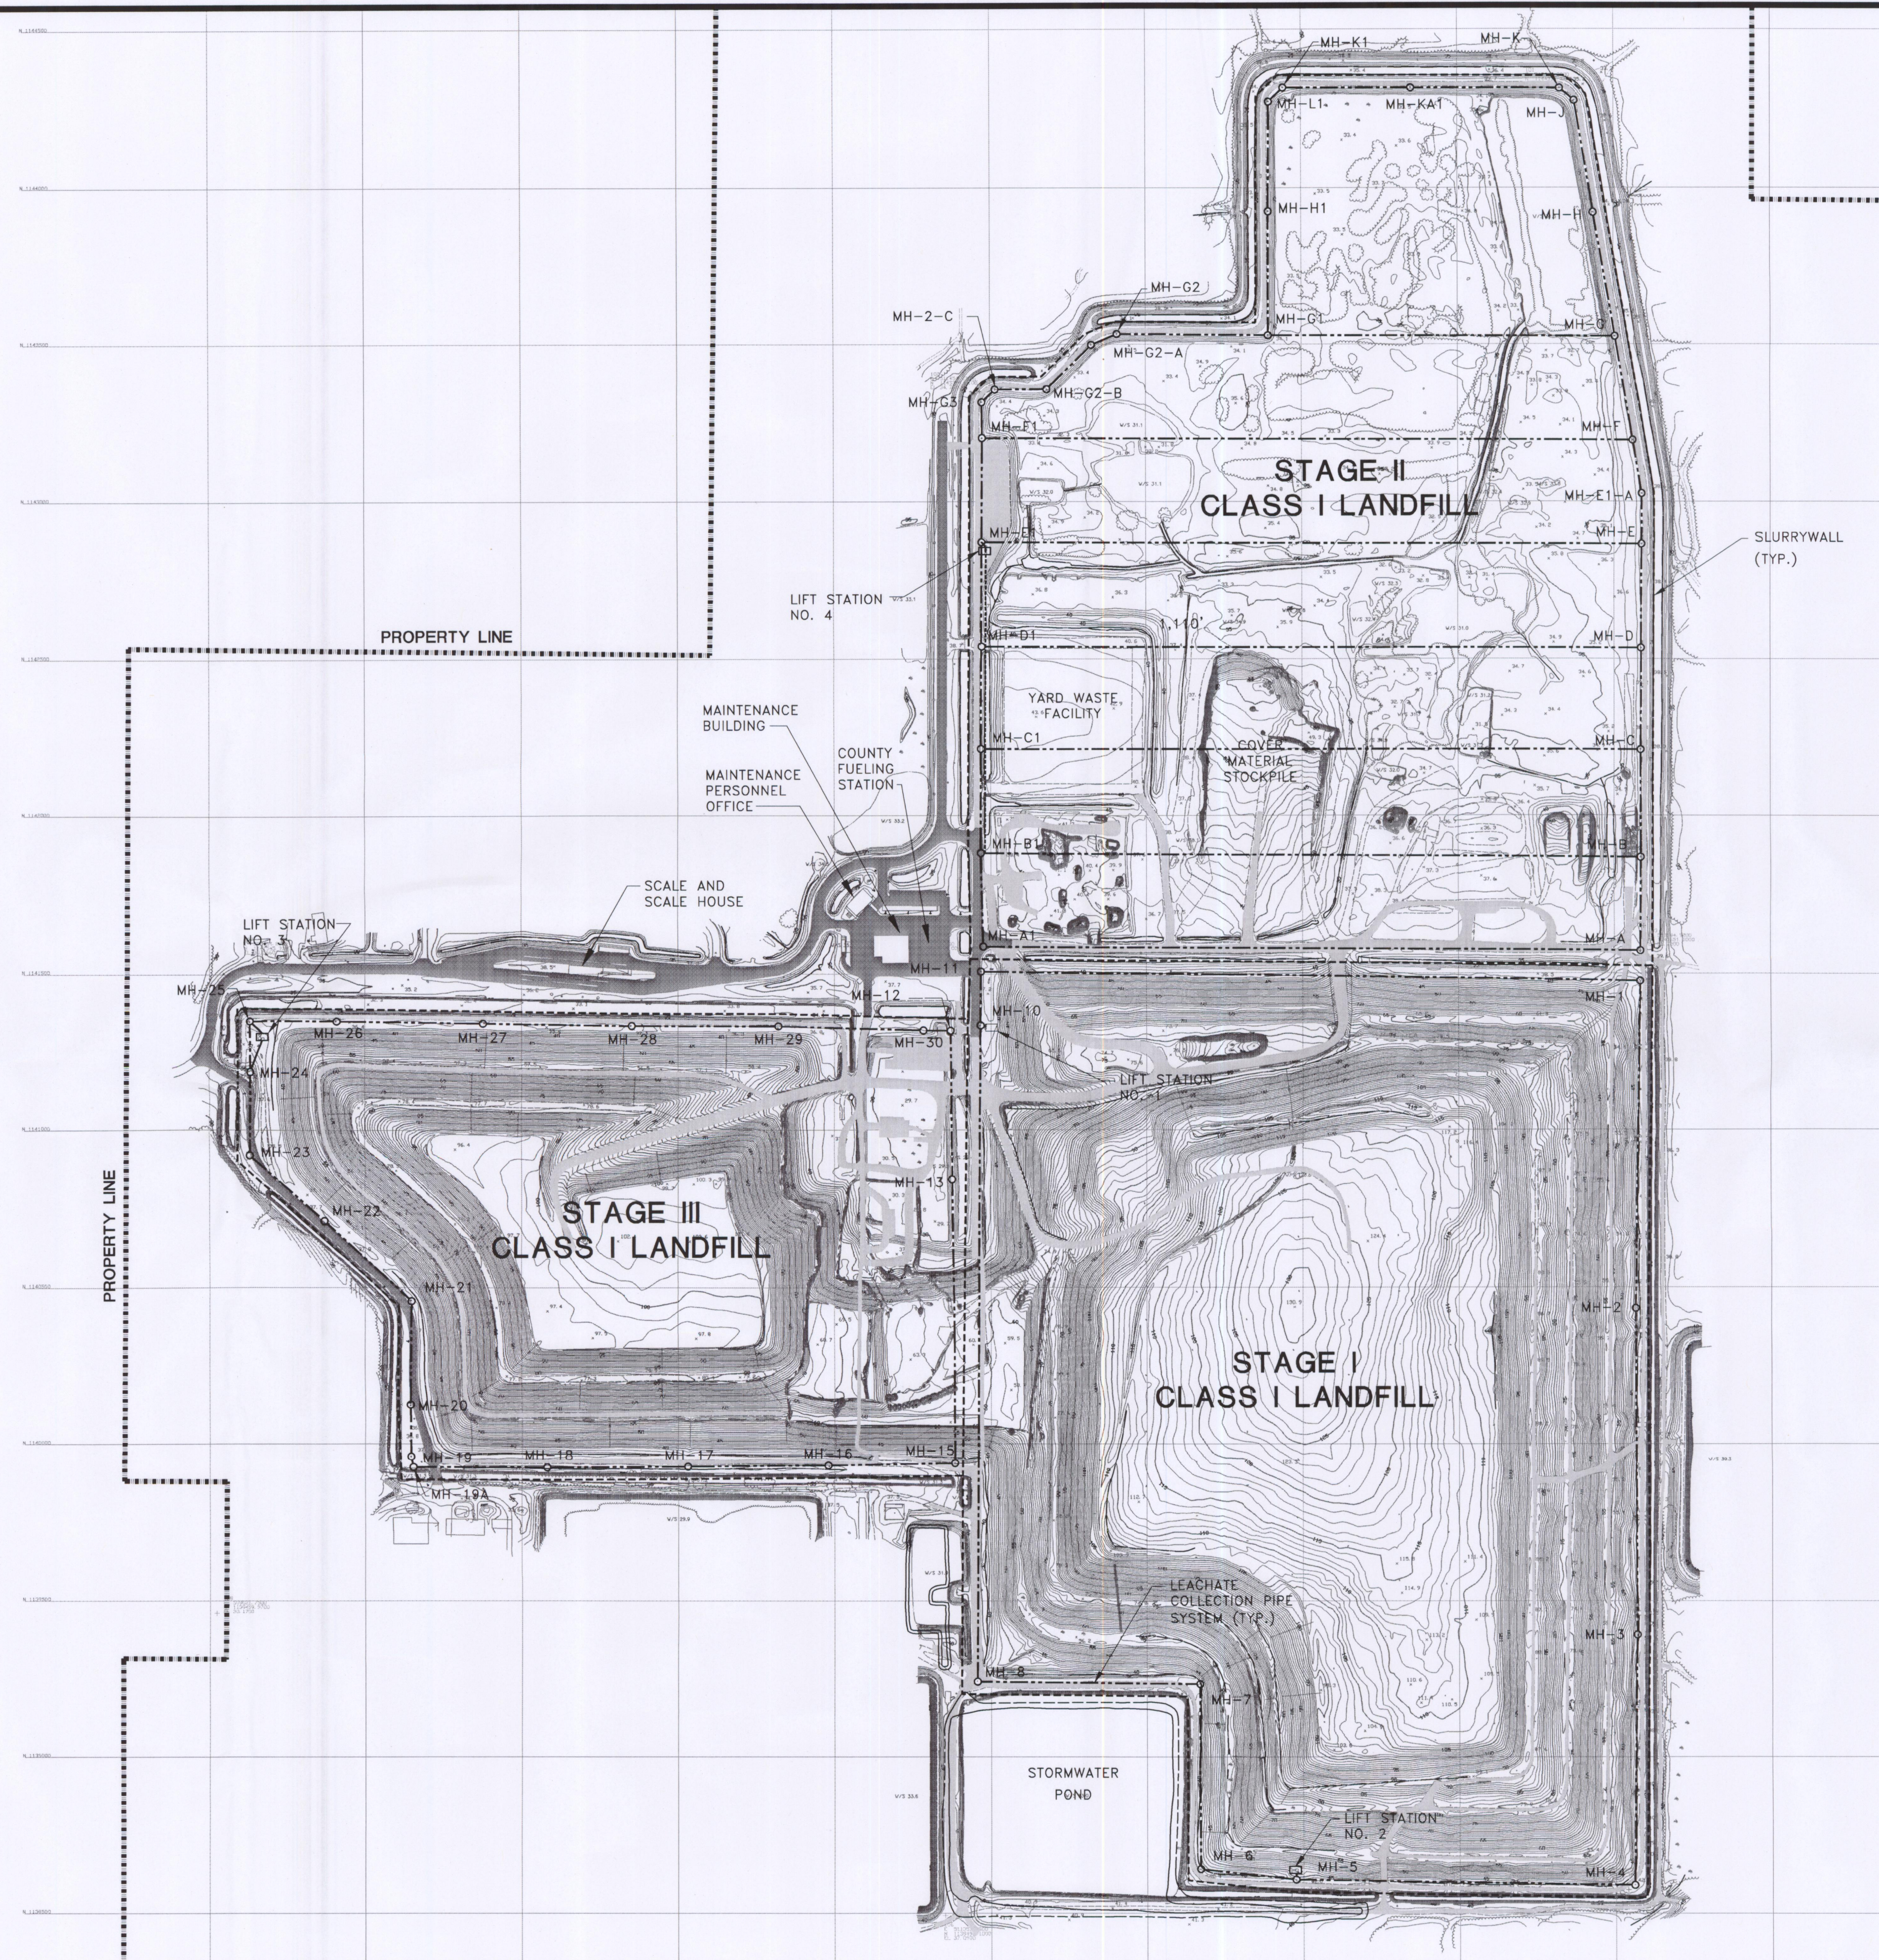

NOTE:

- LEACHATE COLLECTION SYSTEM
- SLURRY WALL
- EXISTING CONTOURS
- o EXISTING MANHOLE
- EXISTING LIFT STATION
- PROPERTY LINE

NOTE:

AERIAL PHOTOGRAMMETRY PROVIDED BY:
I.F. ROOKS & ASSOCIATES, INC.
DATE FLOWN: JANUARY 25, 2010

△ -REPLACE 2009 AERIAL
SURVEY WITH 2010
AERIAL SURVEY

FLORIDA DEPARTMENT OF
ENVIRONMENTAL PROTECTION
MAY 18 2010
SOUTHWEST DISTRICT
TAMPA

C-3

PBS&J

482 South Keller Road
ORLANDO, FL 32810-6101
TEL (407) 647-7275
FAX (407) 647-0624
WWW.PBSJ.COM

POST BUCKLEY, SCHUH & JERNIGAN, Inc.
6150/a PBS&J
5300 West Cypress Street Suite 200
Tampa, FL 33607
FPR Certificate of Authorization No. 24

CLIENT

MANATEE COUNTY
BOARD OF COUNTY COMMISSIONERS

PROJECT

LENA ROAD LANDFILL
FILL SEQUENCE PLAN

TASK

SITE TOPOGRAPHIC SURVEY
SURVEY DATE: FEBRUARY 4, 2009

ORIGINAL NOV. 2009
REVISIONS:
1. APRIL 2010
2.
3.
4.
5.

6.
7.
8.
9.
10.
11.
12.

Name: JOSEPH L. MILLER
Florida P.E. No.: 39177
Address: 482 S. Keller Road
Orlando, FL 32810-6101
Signature: [Signature]
Date: 5/11/2010

JOB NO. 100008517
DRAWN: RGC
DESIGN: RGC/JLM
CHECKED: JLM
Q.C.: DED
SHEET / #