



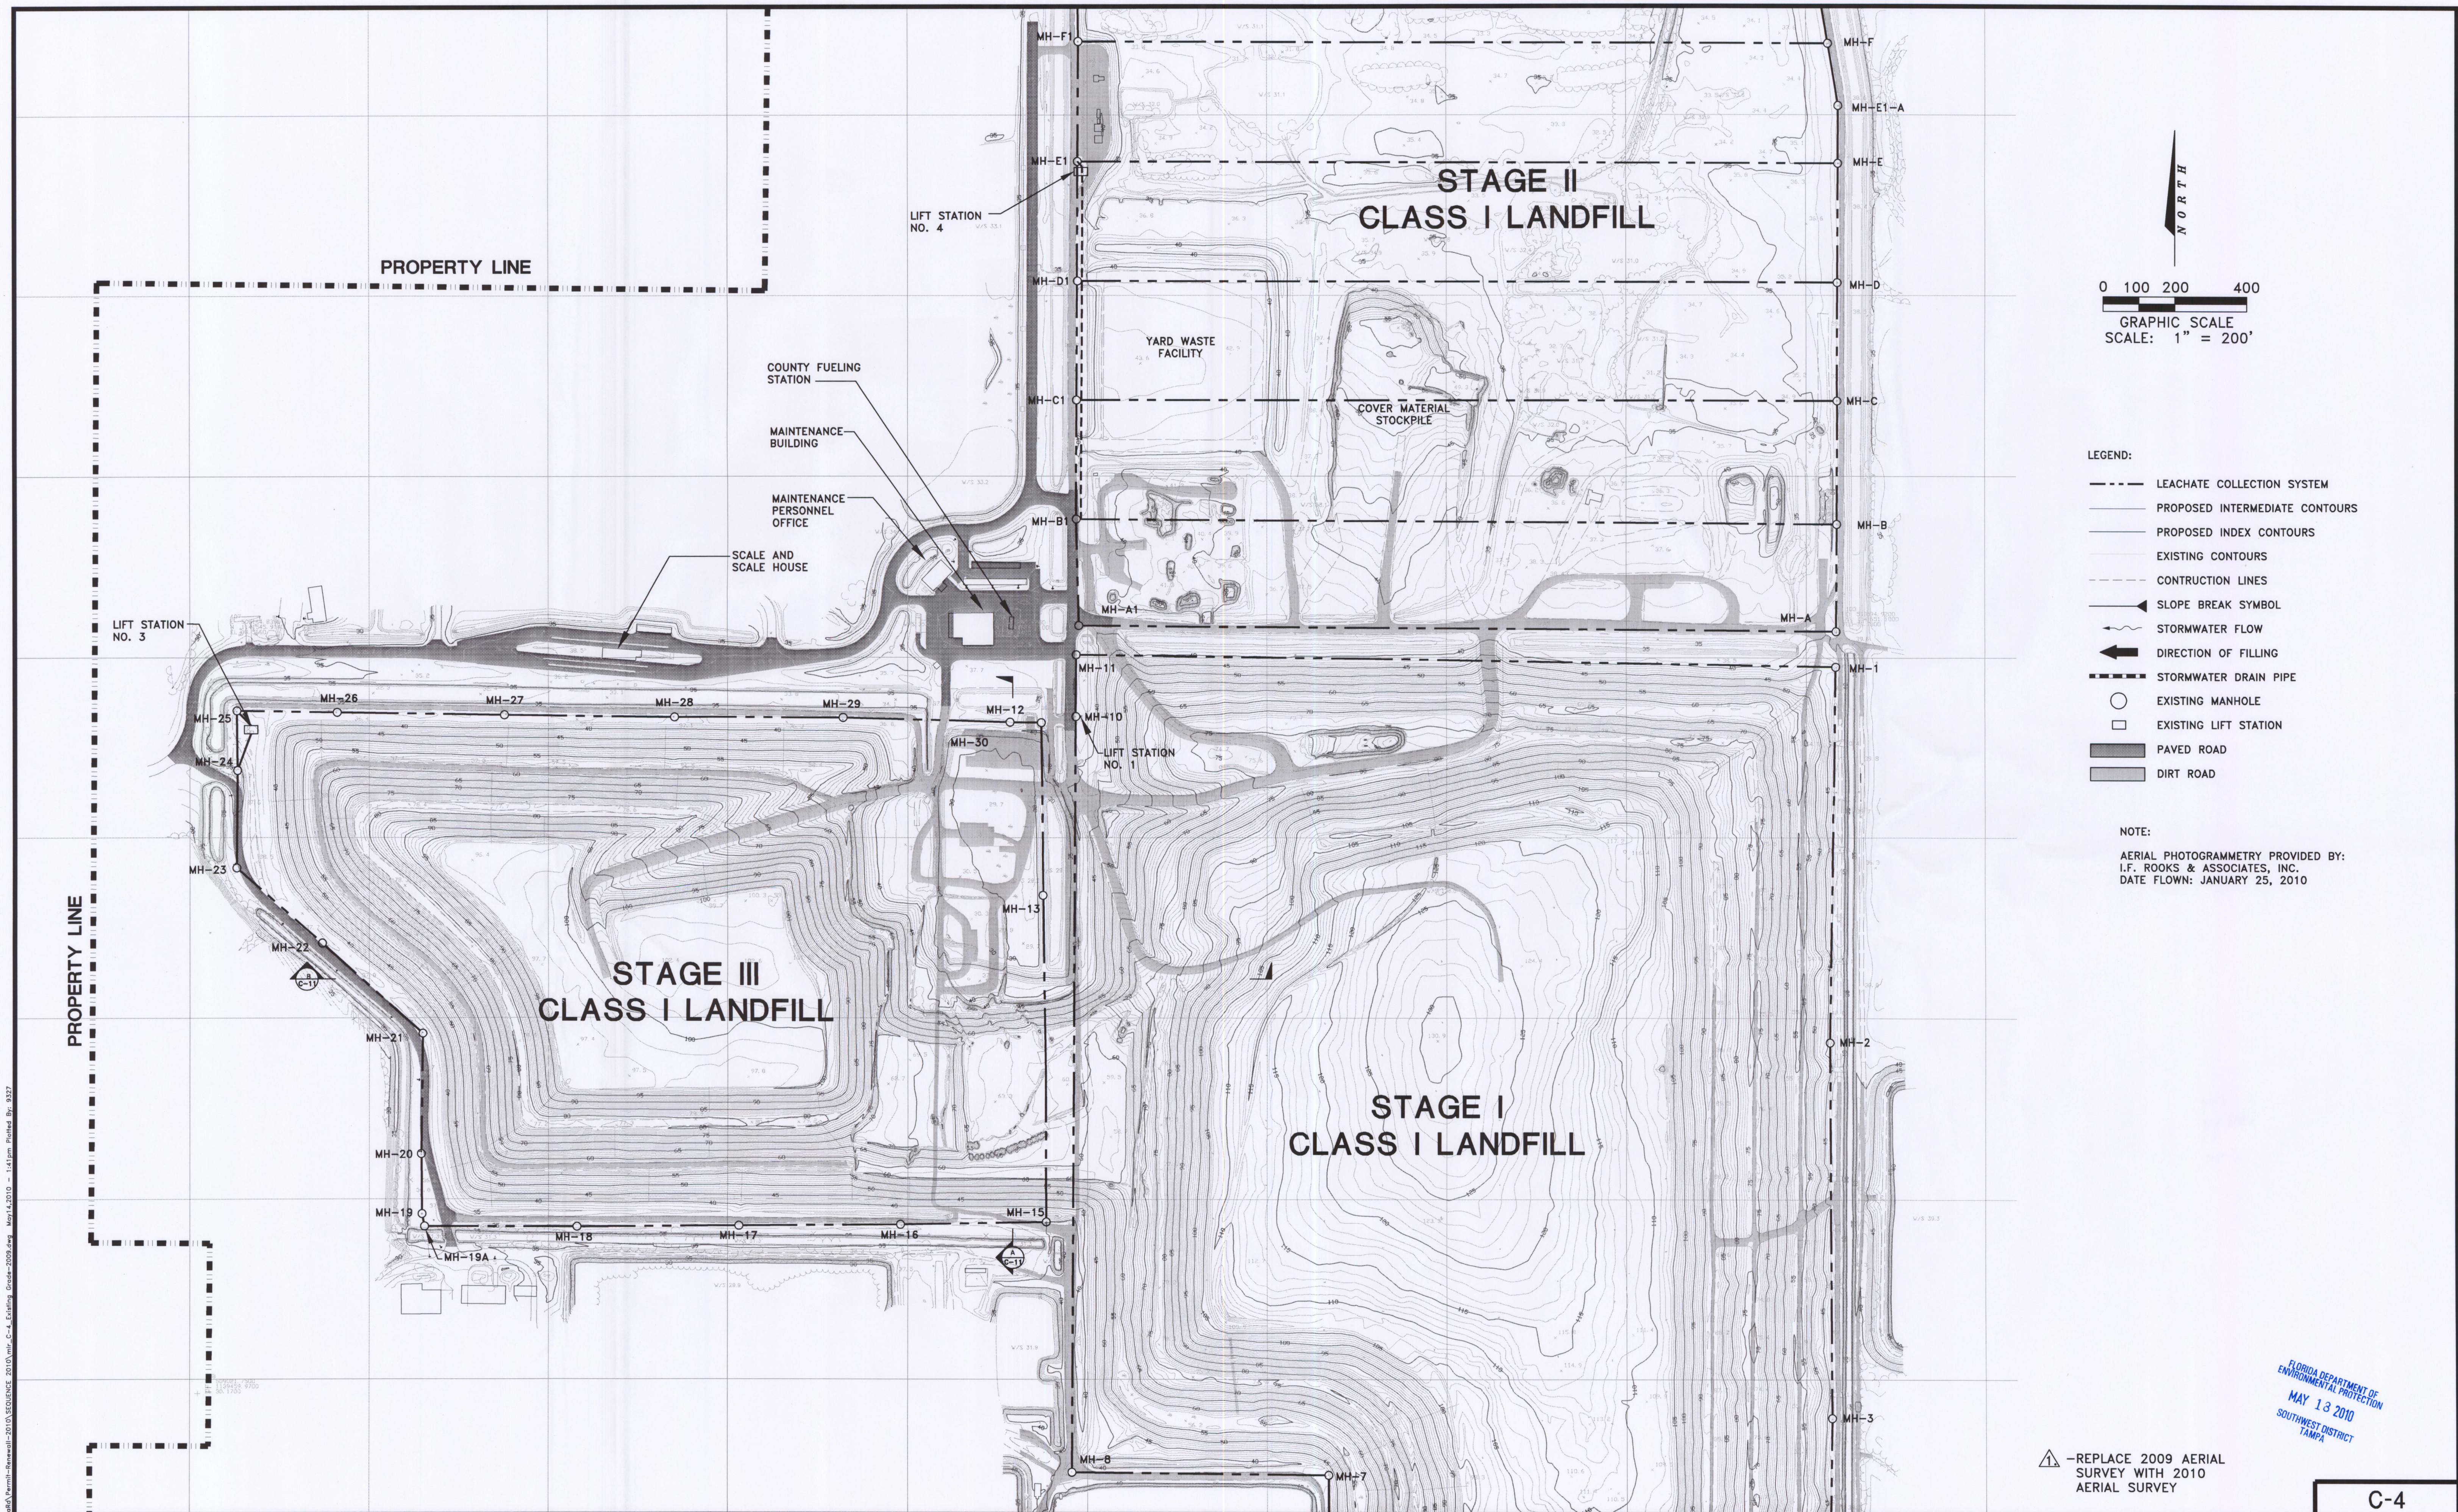

U:\GIS\5-LEACHATE\WATERMAN\Manatee\LENA\Permit-Review\2010\SEQUENCE 2010\seq C-4_Existing Grade-2009.dwg May 4, 2010 1:41pm Plotted By: 8327

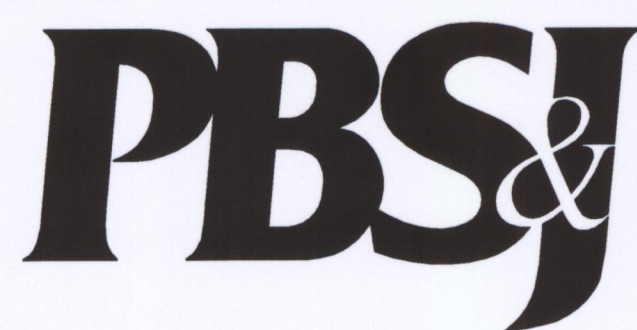

482 South Keller Road
ORLANDO, FL 32810-6101
TEL (407) 647-7275
FAX (407) 647-0624
WWW.PBSJ.COM
POST BUCKLEY, SCHUH & JERNIGAN, Inc.
6750 G. P.B.S. & J.
5300 West Cypress Street Suite 200
Tampa, FL 33607
FBR Certificate of Authorization No. 24

CLIENT
**MANATEE COUNTY
BOARD OF COUNTY COMMISSIONERS**

PROJECT
**LENA ROAD LANDFILL
FILL SEQUENCE PLAN**

TASK
**EXISTING GRADE
AS OF JANUARY 25, 2010**

ORIGINAL NOV. 2009
REVISIONS:
1. APRIL 2010
2.
3.
4.
5.

6.
7.
8.
9.
10.
11.
12.

Name: JEFFREY L. MILLER
Florida P.E. No. 39177
Address: 1950
462 S. Keller Road
Orlando, FL 32810-6101
Signature: [Signature]
Date: 5/13/2010

JOB NO. 100008517
DRAWN RGC
DESIGN RGC/JLM
CHECKED JLM
O.C. DED
SHEET / #

REPLACE 2009 AERIAL
SURVEY WITH 2010
AERIAL SURVEY

C-4

FLORIDA DEPARTMENT OF
ENVIRONMENTAL PROTECTION
MAY 13 2010
SOUTHWEST DISTRICT
TAMPA