
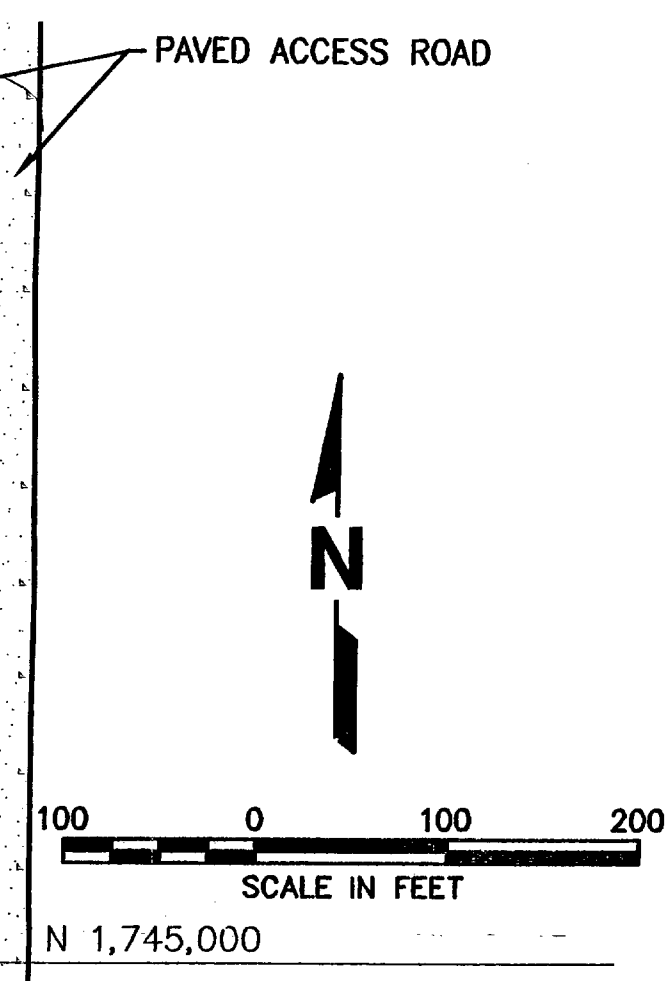


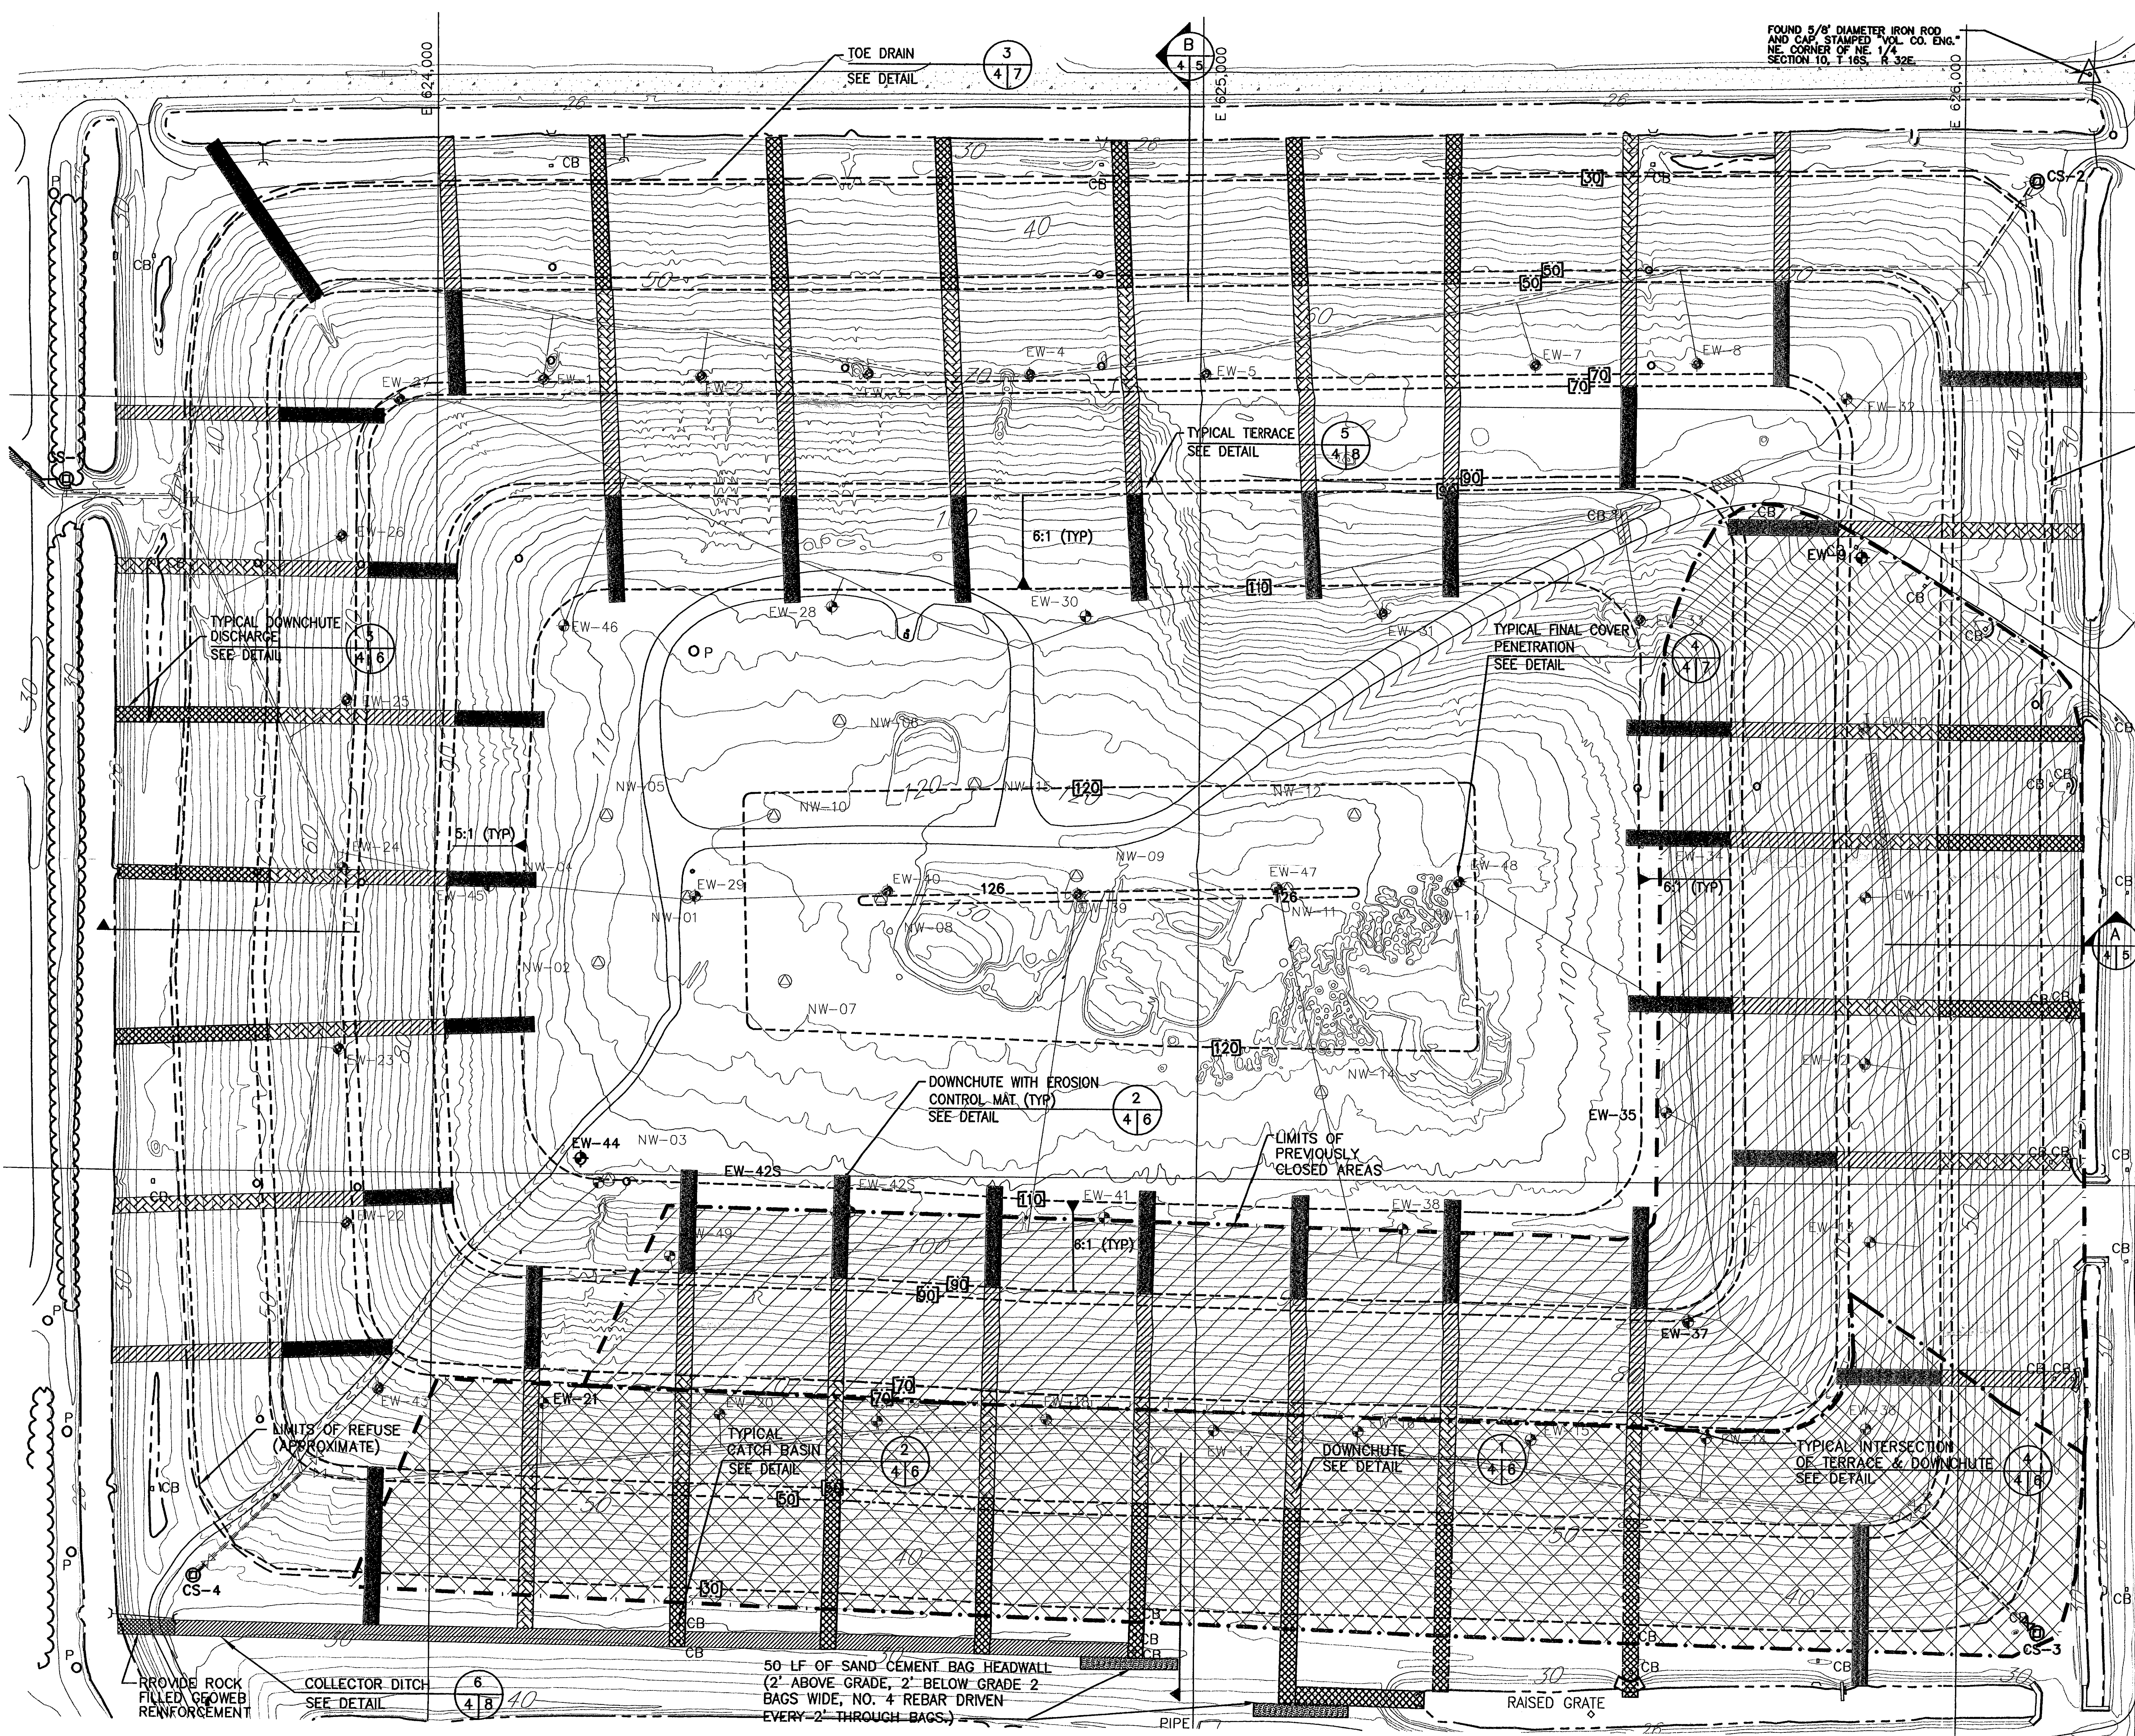

LIMITS OF REFUSE

LEGEND

- 28.8 EXISTING SPOT ELEVATION
- EXISTING EXTRACTION WELL
- 10 EXISTING CONTOUR (10 FOOT INTERVALS)
- EXISTING CONTOUR (2 FOOT INTERVALS)
- 50 FINAL CONTOUR (10 FOOT INTERVALS)
- CB CATCH BASIN
- PREVIOUSLY CLOSED WITH GEOSYNTHETIC CLAY LINER (GCL) - INFORMATION SUBMITTED BY OTHERS TO FDEP
- PREVIOUSLY CLOSED WITH COMPACTED CLAY LINER (CCL) - INFORMATION SUBMITTED BY OTHERS TO FDEP

DOWCHUTE LEGEND

- REACH # 1
- REACH # 2
- REACH # 3
- REACH # 4

NOTES:
1) DOWCHUTE LOCATIONS TO BE FIELD ADJUSTED.
2) DRAWING COMPILED FROM AERIAL TOPOGRAPHIC INFORMATION BY 3DI DATED JULY 18,1998.

REV.	DATE	DESCRIPTION	CK. BY
1			
2			
3			
4			
5			
6			

DRAWING TITLE

PROPOSED FINAL GRADES

PROJECT TITLE

TOMOKA FARMS ROAD LANDFILL SOUTH CELL CLOSURE PERMIT APPLICATION

CLIENT

VOLUSIA COUNTY SOLID WASTE SERVICES DAYTONA BEACH, FLORIDA

SCS ENGINEERS
STEARNS, CONRAD AND SCHMIDT
CONSULTING ENGINEERS
3012 U.S. HWY. 301 NORTH SUITE 700, TAMPA, FL 33619
PH (813) 821-0880 FAX NO. (813) 823-6757

REV.	DATE	DESCRIPTION	CK. BY
1			
2			
3			
4			
5			
6			

CADD FILE:

Closure/SITE100-CL

DATE:

SEPTEMBER, 2000

SCALE:

1" = 100'

DRAWING NO.

4 of 8

NOTES:

BEARINGS ARE BASED ON THE NORTH LINE OF THE NE 1/4 OF SECTION 9-16-32 AS BEING N.89.34°0"E.


ELEVATIONS ARE BASED ON U.S.C.&G.S. INFORMATION PROVIDED BY VOLUSIA COUNTY ENGINEERING.

SPOT ELEVATIONS SHOWN HEREON ARE BASED ON FIELD OBSERVATION.

(GR) INDICATES EXISTING GROUND SHOTS BEFORE THE SAND COVER (DATED FEB. 21, 2000)

(D-H) INDICATES DENSITY HOLE GROUND SHOTS BEFORE THE SAND COVER (DATED FEB. 21, 2000)

REUSED - ADDED (2) DOWN CHUTES (SOUTHWEST CORNER) - 8/10/93 - *jed*
 REUSED - ADDED DOWN CHUTES (NORTH & WEST) STORM PANES & PART AT SW CORNER - 11/16/92 - *jed*
 REUSED - ADDED DOWN CHUTES SHOWN AS (S3) - 11/01/92 - *jed*
 REUSED - ADDED GROUND SHOTS AT DENSITY HOLES D-53 thru D-65, D-70 thru D-73, D-81 thru D-86, D-94, D-95, D-98 thru D-100, AND W-1 - 07/23/92 - *jed*
 REUSED - ADDED DENSITY HOLES D-70 thru D-100 - 02/21/92 - *jed*
 REUSED - ADDED DENSITY HOLES W-1 thru W-23 - 07/11/91 - *jed*
 REUSED - ADDED DENSITY HOLES D-53 thru D-65 - 02/09/91 - *jed*
 REUSED - ADDED DENSITY HOLES D-66, D-67, D-68, D-69, D-50, D-51, D-52, AND (S) UNKNOWN(D-?) - 01/02/91 - *jed*
 REUSED - ADDED DENSITY HOLES D-122A & D-123A - 5/06/90 - *jed*
 REUSED - ADDED DENSITY HOLES D-25 to D-38 - 3/24/90 - *jed*
 REUSED - ADDED DENSITY HOLES D-122A & D-123A - 5/06/90 - *jed*

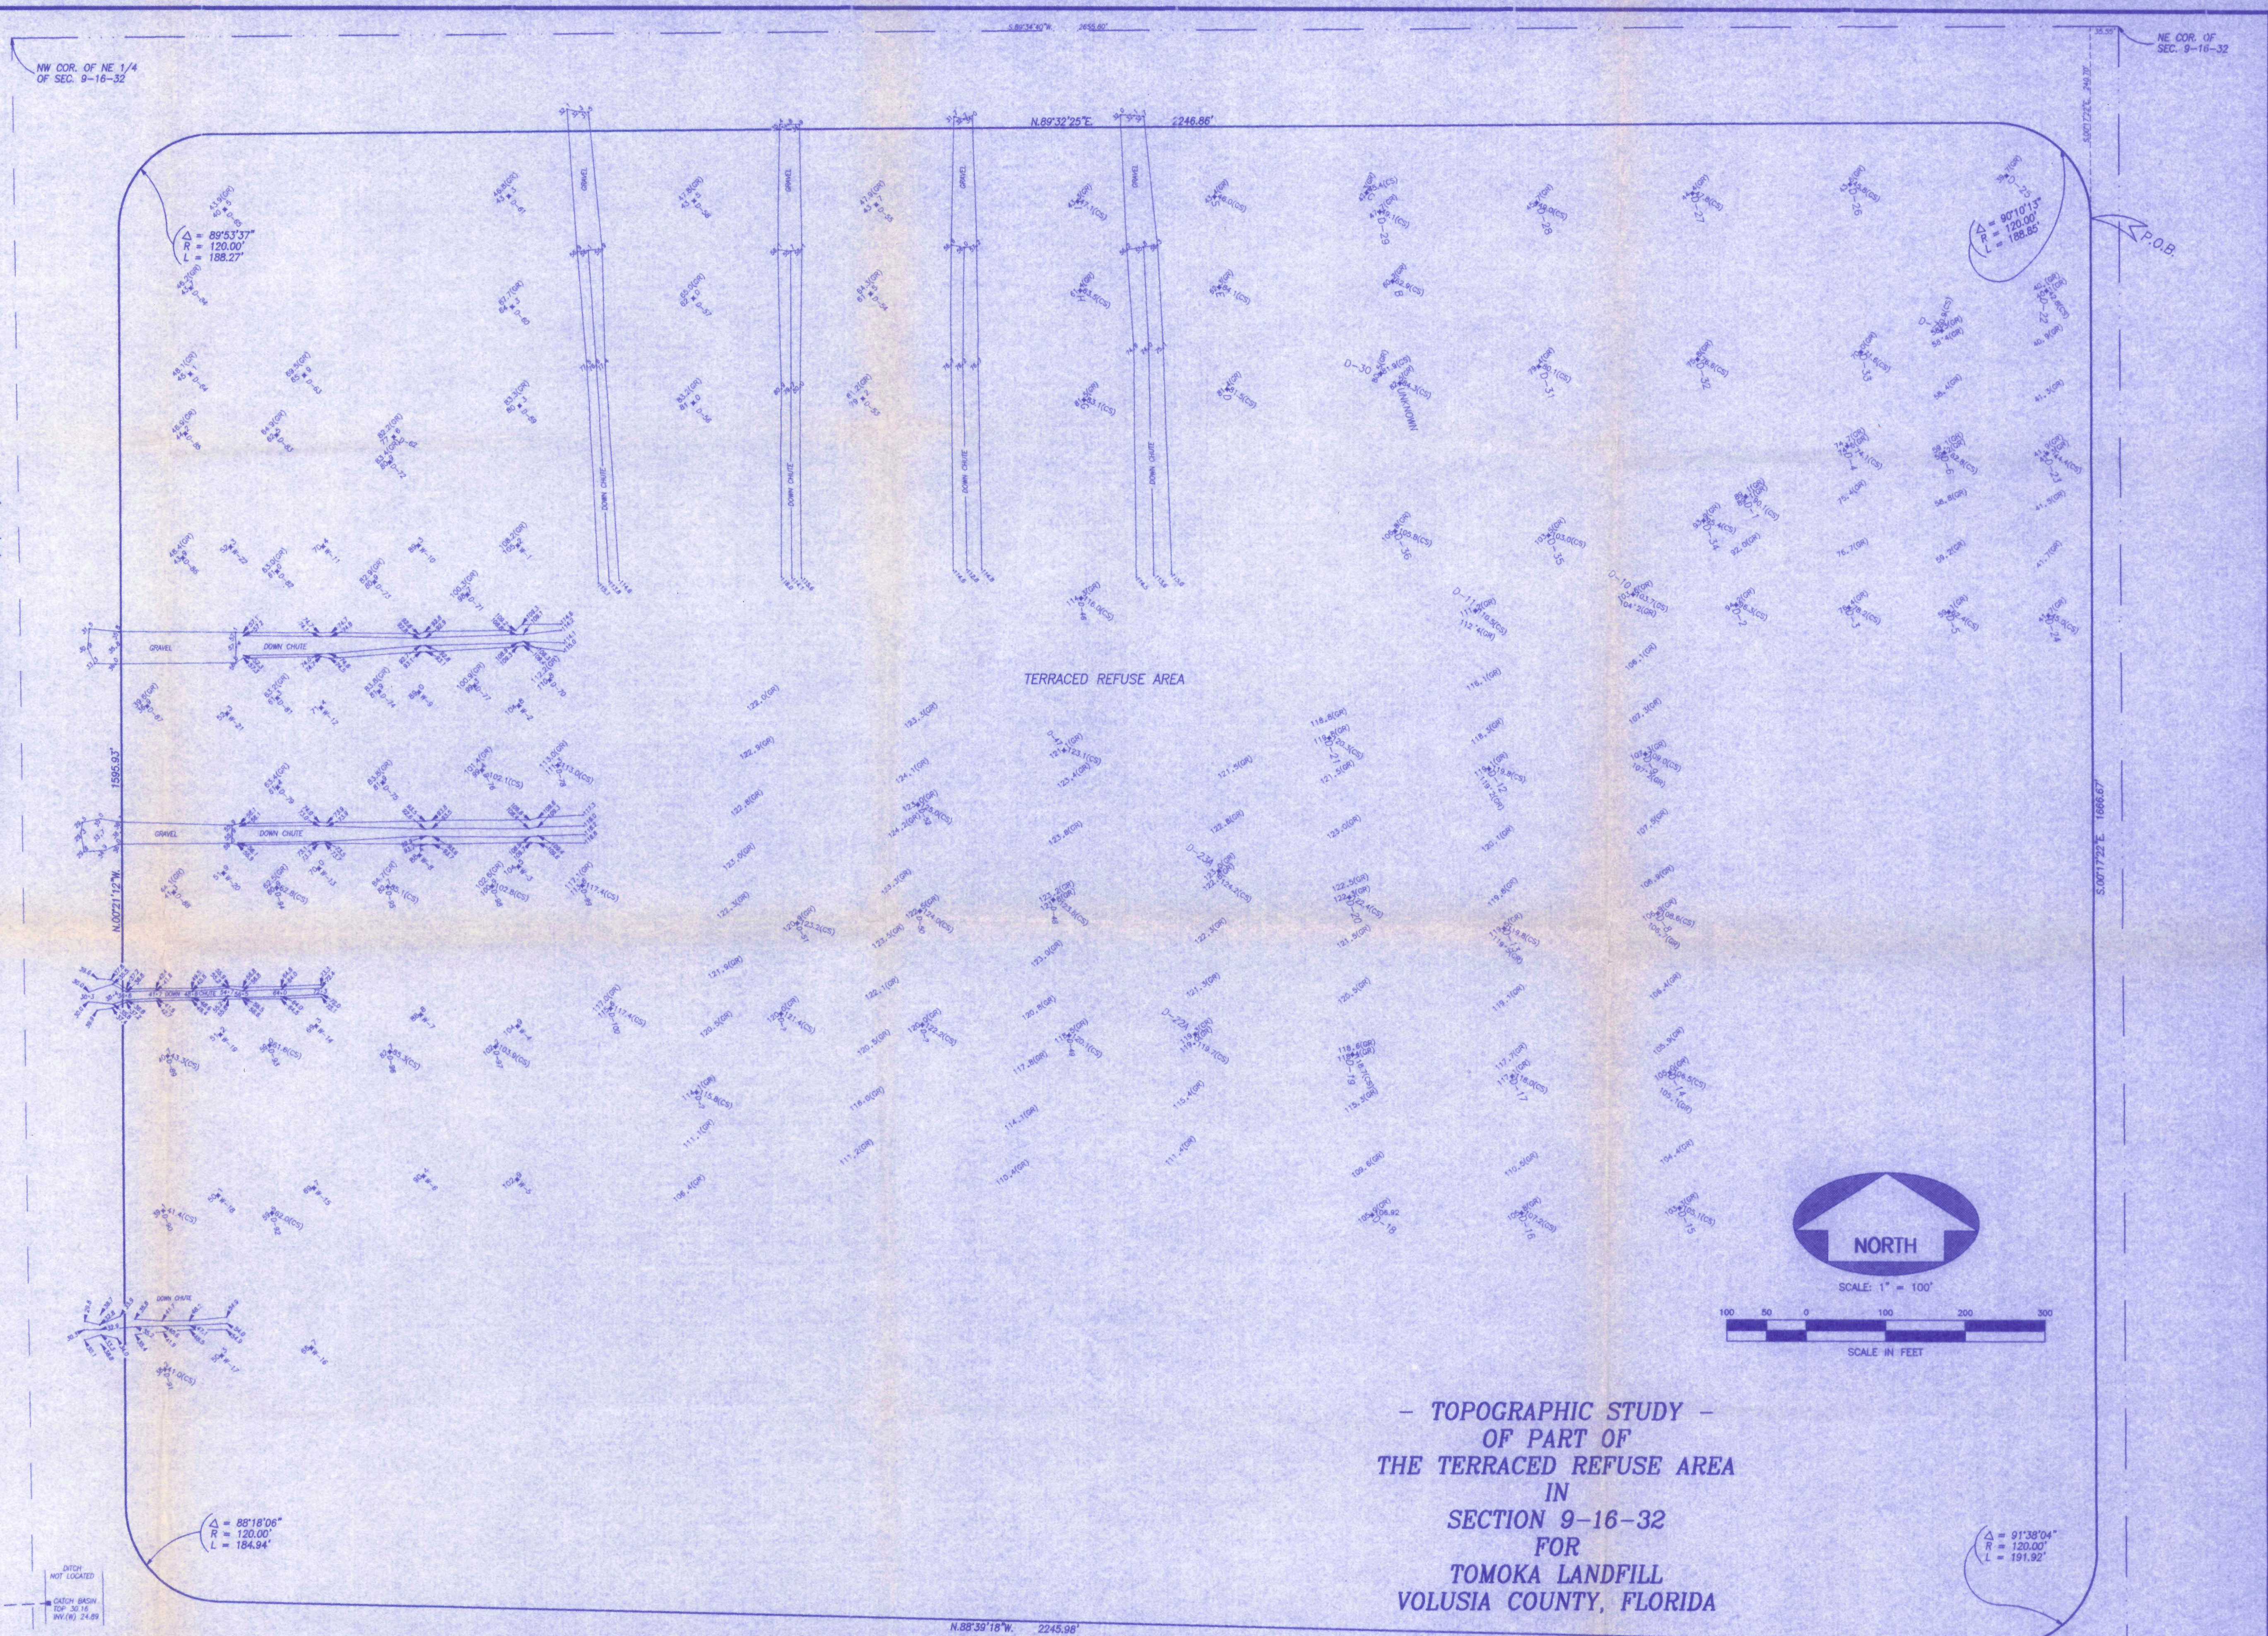

- TOPOGRAPHIC STUDY -
 OF PART OF
 THE TERRACED REFUSE AREA
 IN
 SECTION 9-16-32
 FOR
 TOMOKA LANDFILL
 VOLUSIA COUNTY, FLORIDA

[illegible]

NOTE:
is certified to and prepared
exclusive benefit of the entities
shown hereon, valid on the m
hereon, and shall not be rel
entity or individual whomsoev
which has been prepared without
or title search unless
hereon.
Additional restrictions and/or othe
not shown on this Survey /
is found in the Public Records
contained within the Title

M-583

