AS-BUILT SURVEY

LEGEND:

NO.	NUMBER
ELEV.	ELEVATION
x 73.35	ASBUILT SPOT ELEVATION - SUBGRADE
LB	LICENCE BUSINESS
— — —(95)— —	ASBUILT SUBGRADE CONTOUR (5 FOOT INTERVAL)
	ASBUILT SUBGRADE CONTOUR (1 FOOT INTERVAL)
—— ——	TOE OF SLOPE
—— ——	TOP OF SLOPE
◑	EXISTING LINER MARKER
—— - ——	ASBUILT LINER TIE-IN

GRAPHIC SCALE

0 40 60 80 120

1 inch = 40 ft.

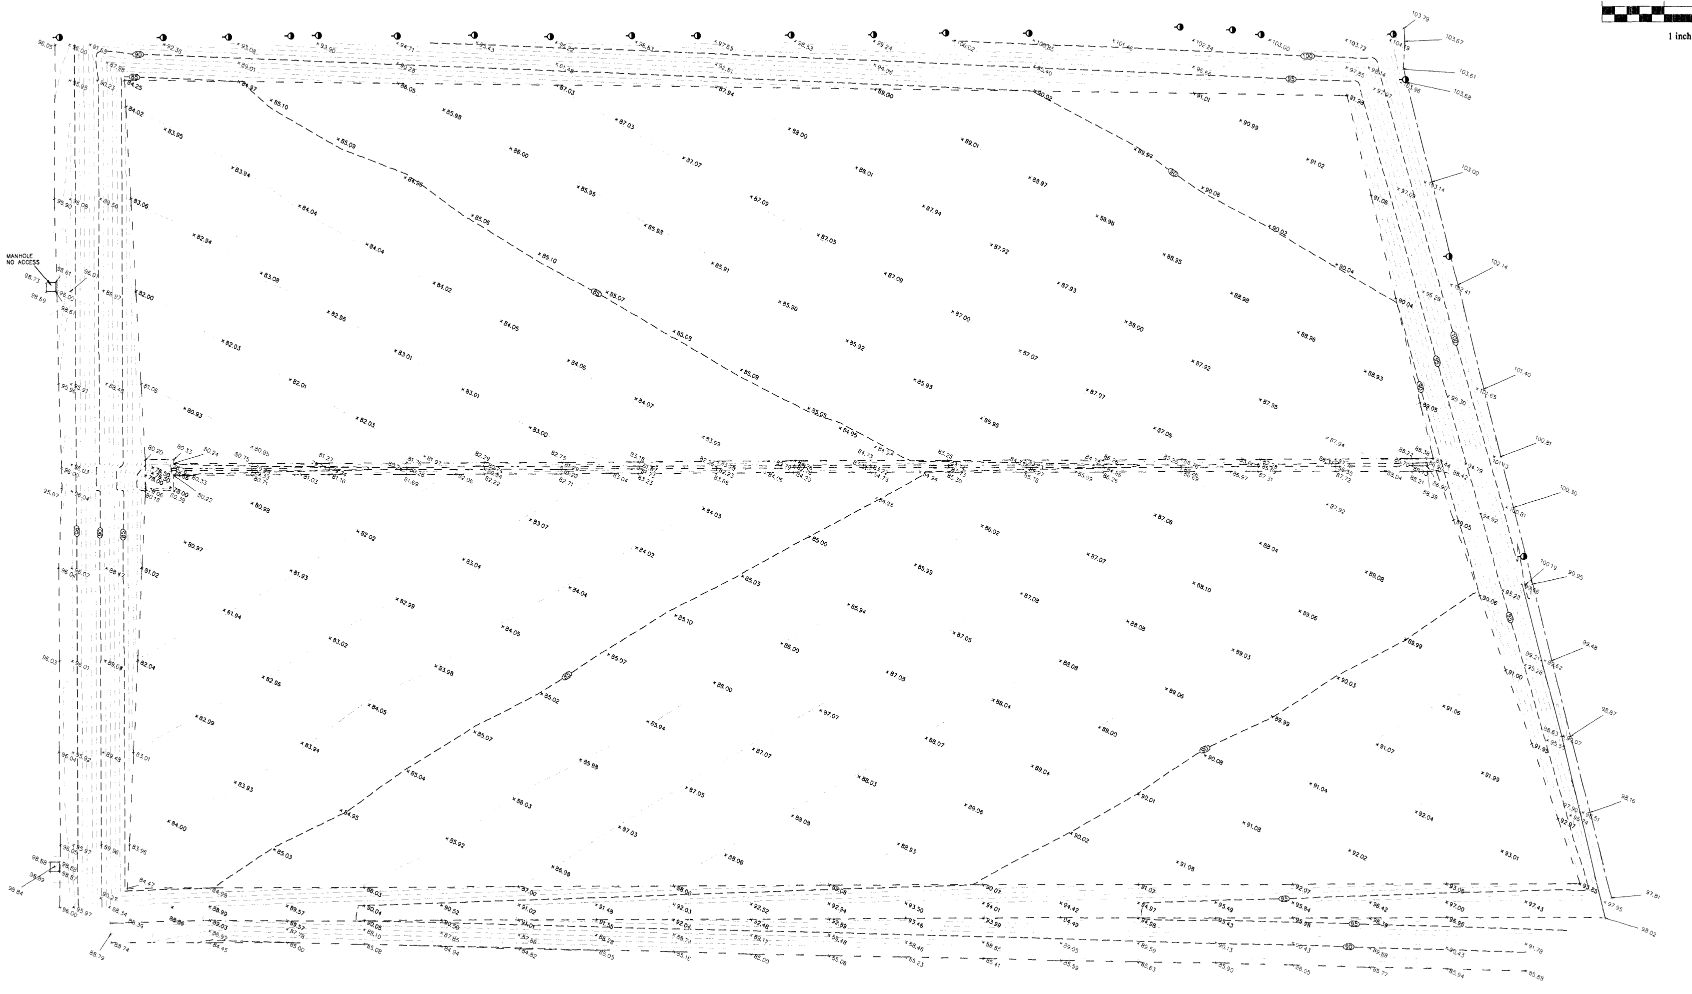

RECEIVED
NOV 01 2010
DEP Central Dist.

NO.	DATE	REVISION
1	10/22/10	REVISED TO SHOW SUBGRADE POINT DATA

THIS SURVEY IS NOT VALID WITHOUT THE SIGNATURE AND ORIGINAL RAISED SEAL OF A FLORIDA LICENSED SURVEYOR AND MAPPER.

FILE NAME: 113-JED-Holipaw-subbase

Drawn By: DLP
Party Chief: DR
Field Book:
Page:

PEAVEY
& ASSOCIATES SURVEYING & MAPPING PA
FLORIDA BUSINESS NUMBER 7779
690 ALICE PLACE
BARTOW, FL 33830
PHONE: 863-738-4960

CLIENT:

ERC GENERAL CONTRACTOR
890 Carter Road Suite 170
Winter Garden, Fl 34787

ASBUILT SURVEY - TOP OF LINER SUBBASE
CELL 7 CONSTRUCTION
J.E.D. SOLID WASTE MANGEMENT FACILITY
1501 OMNI WAY ST. CLOUD, FL

DEBORAH L. PEAVEY, P.S.M.
FLORIDA REGISTRATION NUMBER 6345
FLORIDA BUSINESS NUMBER 7779
7/3/2010
SURVEY DATE

SCALE	DRAWING NO.
1"=40'	173
PROJECT NO.	SHEET
113	1 OF 3

N

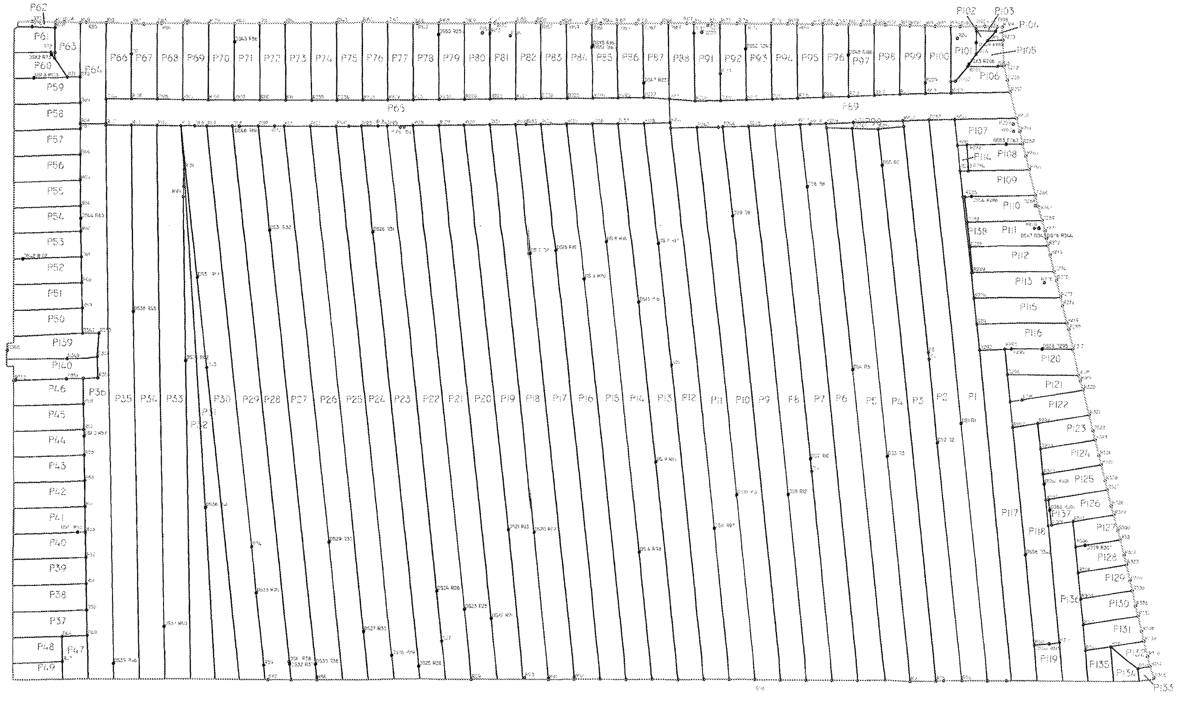

1.0000

PLOT SCALE: 1" = 50'
PROJECT NO.: 03103981

LEGEND		
P PANEL NUMBER	——	CAP
R REPAIR NUMBER	○	PATCH
DT DESTRUCTIVE TEST NUMBER	○	DESTRUCTIVE TEST
	▬	EXTRUSION WELD

Liner As-Built Survey provided by Comanco Environmental Corporation

26 October

STATE OF FLORIDA PROFESSIONAL ENGINEER

EPS

EPS is about the business of the environment.℠

Environmental Planning Specialists, Inc.
900 Ashwood Parkway, Suite 350
Atlanta, GA 30338
Phone: (404) 315-9113
Fax: (404) 315-8509

DES		
DRN		
CHK		
REV		
APP		
PROJ MGR	KW	08/10
OPER		

DATE: August 2010

J.E.D Solid Waste
Management Facility
Osceola County, Florida

Cell 7 Construction
Primary Geomembrane Panel
As-Built Drawing

FIGURE
1

 

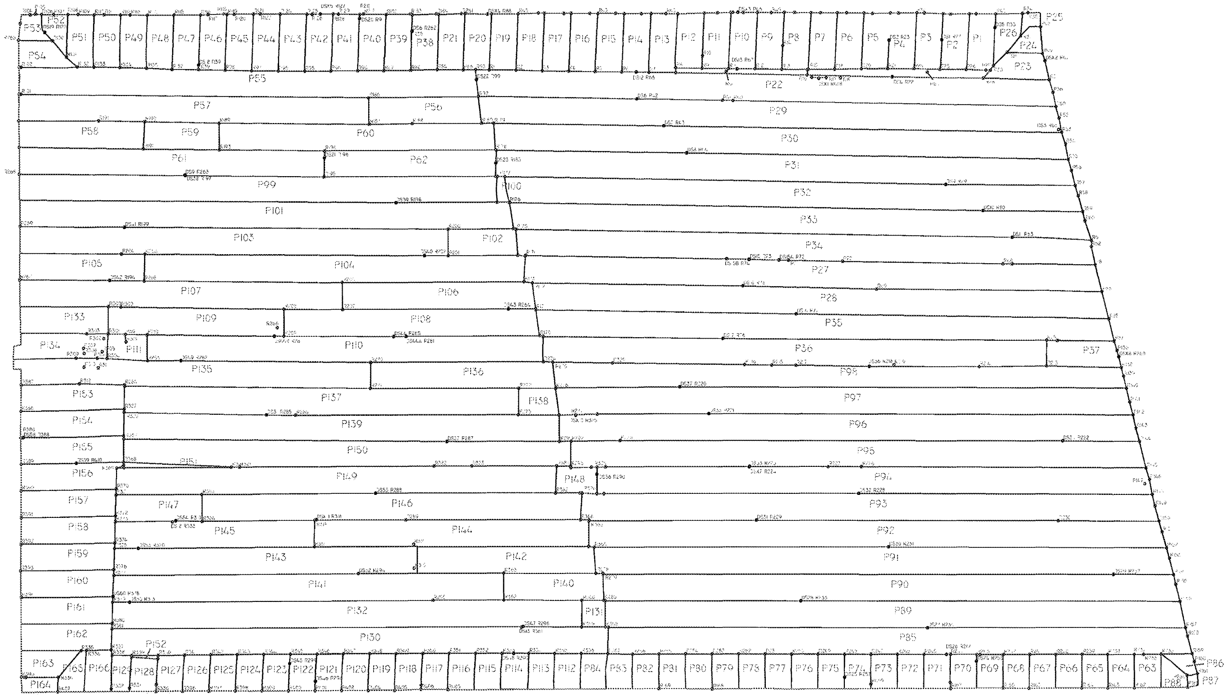

LEGEND

P	PANEL NUMBER	—	CAP
R	REPAIR NUMBER	○	PATCH
DT	DESTRUCTIVE TEST NUMBER	○	DESTRUCTIVE TEST
		—	EXTRUSION WELD

Liner As-Built Survey provided by Comanco Environmental Corporation

STATE OF FLORIDA PROFESSIONAL ENGINEER
26 October 2010

EPS

EPS is about the business of the environment.℠

Environmental Planning Specialists, Inc.
900 Ashwood Parkway, Suite 350
Atlanta, GA 30338
Phone: (404) 315-9113
Fax: (404) 315-8509

DES		
DRN		
CHK		
REV		
APP		
PROJ MGR	KW	08/2010
OPER		

DATE: August 2010

J.E.D. Solid Waste
Management Facility
Osceola County, Florida

Cell 7 Construction
Secondary Geomembrane Panel
As-Built Drawing

FIGURE
1