

From: [Angela Kurth](#)
To: [Barnhart, Laura](#); [PRP Inspector](#)
Cc: markv@shortys.com
Subject: RE: Field Activity Notification / Fletchers Happy Dolphin Bar & Grill / Fletchers Happy Dolphin Bar & Grill / PO No: C23487
Date: Tuesday, April 2, 2024 12:49:52 PM
Attachments: [PSB LOCATION MAP.pdf](#)
Importance: High

Caution: This is an external email and may be malicious. Please take care when clicking links or opening attachments.

Field Activity Notification
Fletchers Happy Dolphin Bar & Grill
5717 18th Street East
Ellenton, Manatee County, Florida 34222
FDEP Facility ID: 418945410
Discharge Date (Program/Score): 06/02/1998 (PLRIP/10)
PO No: C23487/ PRP Reference No.: 742-052B

Hello - Please accept this email as notification of scheduled field activities. CES will be onsite the following dates to perform the field activities as authorized under the referenced PO. A Site Map with the proposed soil boring location is attached.

DPT Install & Groundwater Sampling – May 1-2, 2024. The work on each day will be completed early in the morning.

Property Owners: If the business location is tenant occupied, please inform them of the upcoming field work. During the scheduled field date(s), **it will be necessary to move any equipment, cars/trucks or any obstructions at the locations of the proposed soil borings and/or monitoring wells and have all gates unlocked for access.**

In addition, please forward any as-builts or site maps you have depicting the locations of petroleum storage system layout and/or any underground utilities.

Tenants: The FDEP has an executed access agreement with the Property Owner for the above referenced parcel. Field work will be completed per the referenced PO and under the terms of the signed and executed access agreement.



Thank you –

Angela

Angela Kurth
Project Manager / Environmental Scientist
CES / CEC JV PRP Contract Manager
700 Desoto Avenue, Brooksville, Florida 34601
(352) 796-3374 office | **(904) 993-3113** mobile
akurth@creativeenvironmental.com email
www.creativeenvironmental.com website

- LEGEND**
- TW-1 - TEMPORARY MONITORING WELL LOCATION
 - ⊕ - MONITORING WELL LOCATION
 - ◆ - SOIL BORING LOCATION (03 & 07/20)
 - ◆ - SOIL BORING LOCATION (CES 11/23)

X = proposed soil boring location
⊗ = contingent soil boring location

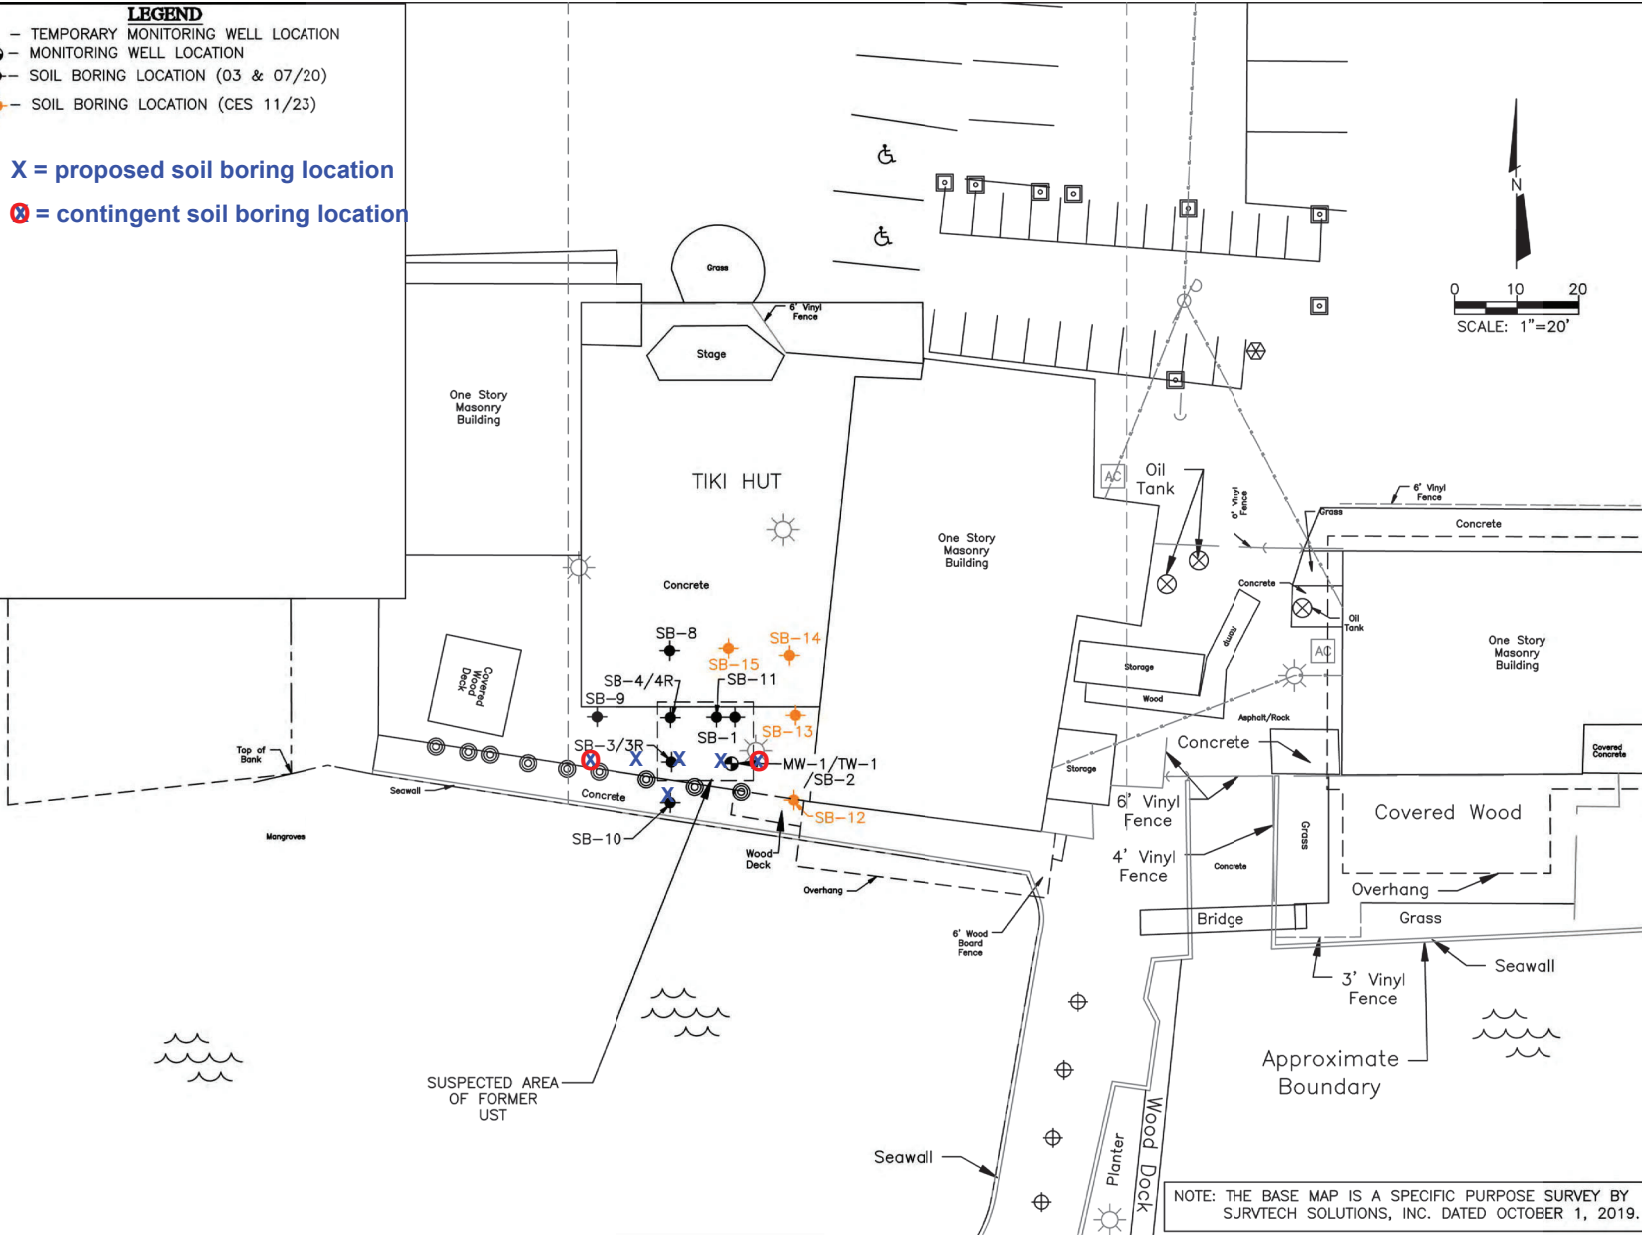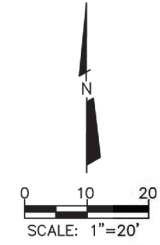

NOTE: THE BASE MAP IS A SPECIFIC PURPOSE SURVEY BY SJRVTECH SOLUTIONS, INC. DATED OCTOBER 1, 2019.

5	SITE MAP
FIGURE NO.	FIGURE TITLE

FACILITY NAME	FLETCHERS HAPPY DOLPHIN PUB & GRILL
FACILITY ADDRESS	5717 18th STREET EAST ELLENTON, MANATEE COUNTY, FL
FACILITY ID NO.	418945410
DATE PREPARED	12-21-23

