


DETAIL OF BLOCK WALL NOT TO SCALE

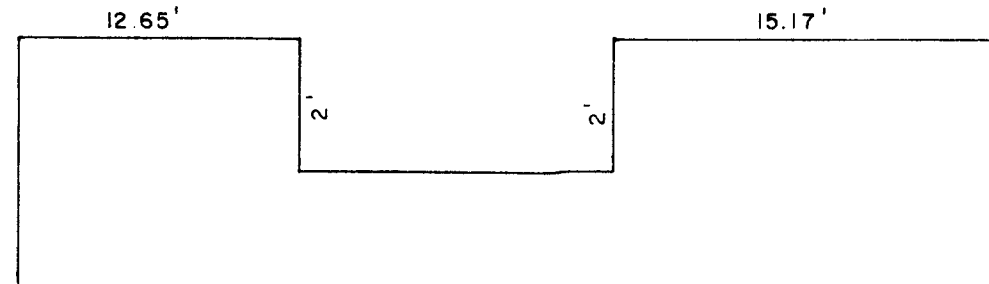

30

SCALE 1" = 30'

LEGAL DESCRIPTION AS FURNISHED

THE WEST 400.00 FEET OF THE SOUTH 1/4 OF LOT 30 OF SECTION 1, MANHATTAN SUBDIVISION, AS RECORDED IN PLAT BOOK 2, PAGE 13, PUBLIC RECORDS OF LAKE COUNTY, FLORIDA, EXCEPT THE SOUTH 50.00 FEET FOR ROAD RIGHT-OF-WAY.

LEGEND

- = SET IRON ROD WITH R.L.S. CAP # 3473
- R.L.S. = REGISTERED LAND SURVEYOR
- = POINT OF ELEVATION
- = CONCRETE
- (P) = PLAT CALL
- (M) = FIELD MEASUREMENT


31

NOTES:

BEARINGS SHOWN HEREON ARE BASED ON THE SOUTH LINE OF SECTION 1, PLAT OF MANHATTAN, AS BEING S 89°27'37" W (ASSUMED).


ELEVATIONS SHOWN HEREON ARE BASED ON N.G.V.D.

29

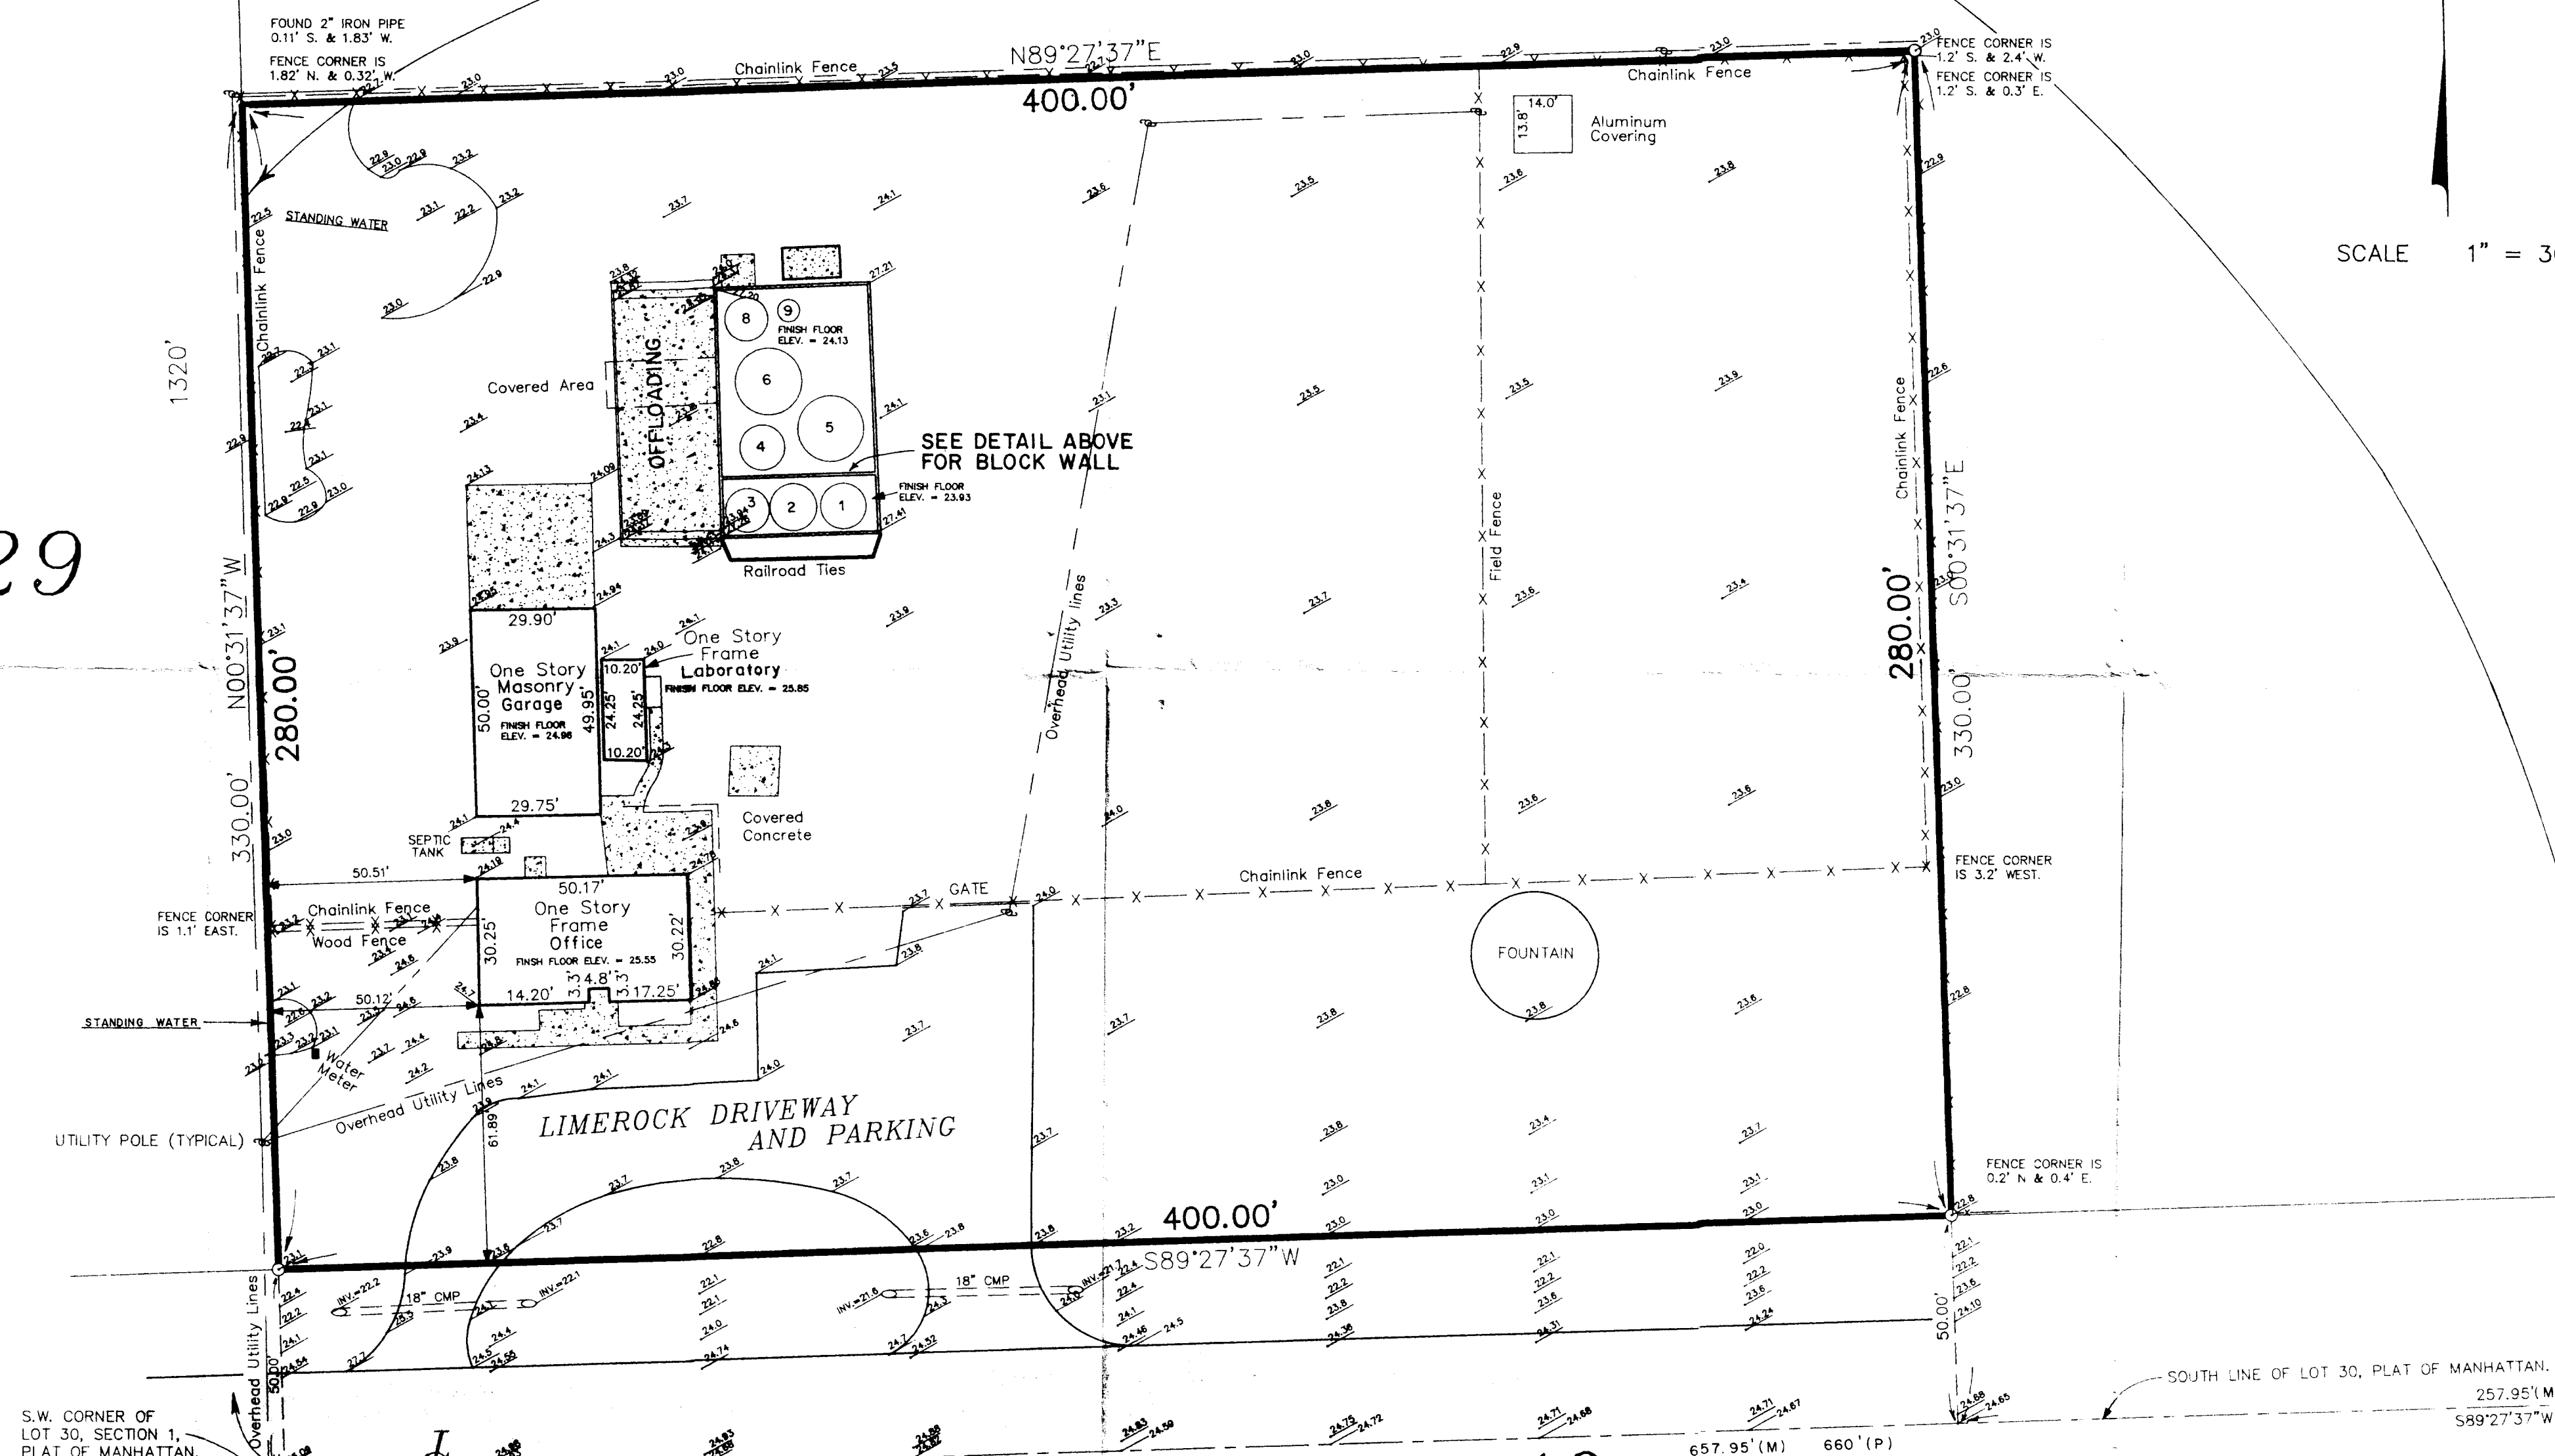

STATE ROAD NO. 40

Unless it bears the signature and the original raised seal of a Florida licensed surveyor and mapper, this map/report is for informational purposes only and is not valid. Additions or deletions to survey maps or reports by other than the signing party or parties is prohibited without written consent of the signing party or parties.

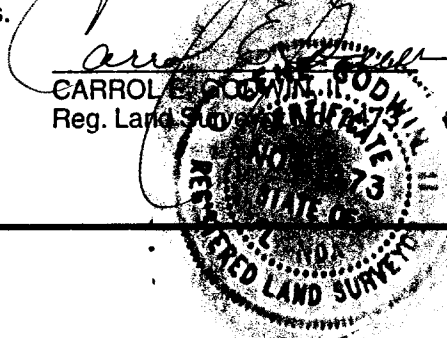

GODWIN & ASSOCIATES, INC.

PROFESSIONAL LAND SURVEYING

115 E. INDIANA AVE. DELAND, FL (904)734-6629

BOUNDARY AND TOPOGRAPHIC SURVEY FOR:	SCALE: 1" = 30'	DATE: 8-8-97
NORTH FLORIDA OIL	DRAWN BY: L.L.	CHECKED BY:
	WORK ORDER	
	7-97-184	44-77