

Russell, Merlin

From: Curtis, Jeff <Jeff.Curtis@safety-kleen.com>
Sent: Monday, February 17, 2014 10:24 AM
To: Russell, Merlin; White, John
Subject: "SK Sanford Figure 8-1"
Attachments: FIG 8-1_rev3.pdf

Merlin,

Attached is the final revision for figure 8-1 as we discussed on Friday.

Thanks,




Jeff Curtis EHS Manager | Safety-Kleen | A Clean Harbors Company | Boynton Beach, FL | jeff.curtis@safety-kleen.com
561.738.3026 (o) | 561.523.4719 (c) | 561.731.1696 (f) | safety-kleen.com




Safety Starts With Me! Live it 3-6-5

FIGURE 8-1 CONTAINER STORAGE AREAS SAFETY-KLEEN SYSTEMS, INC. SANFORD, FLORIDA

 LEGEND

-  FENCE
-  GRATING
-  STAIRS

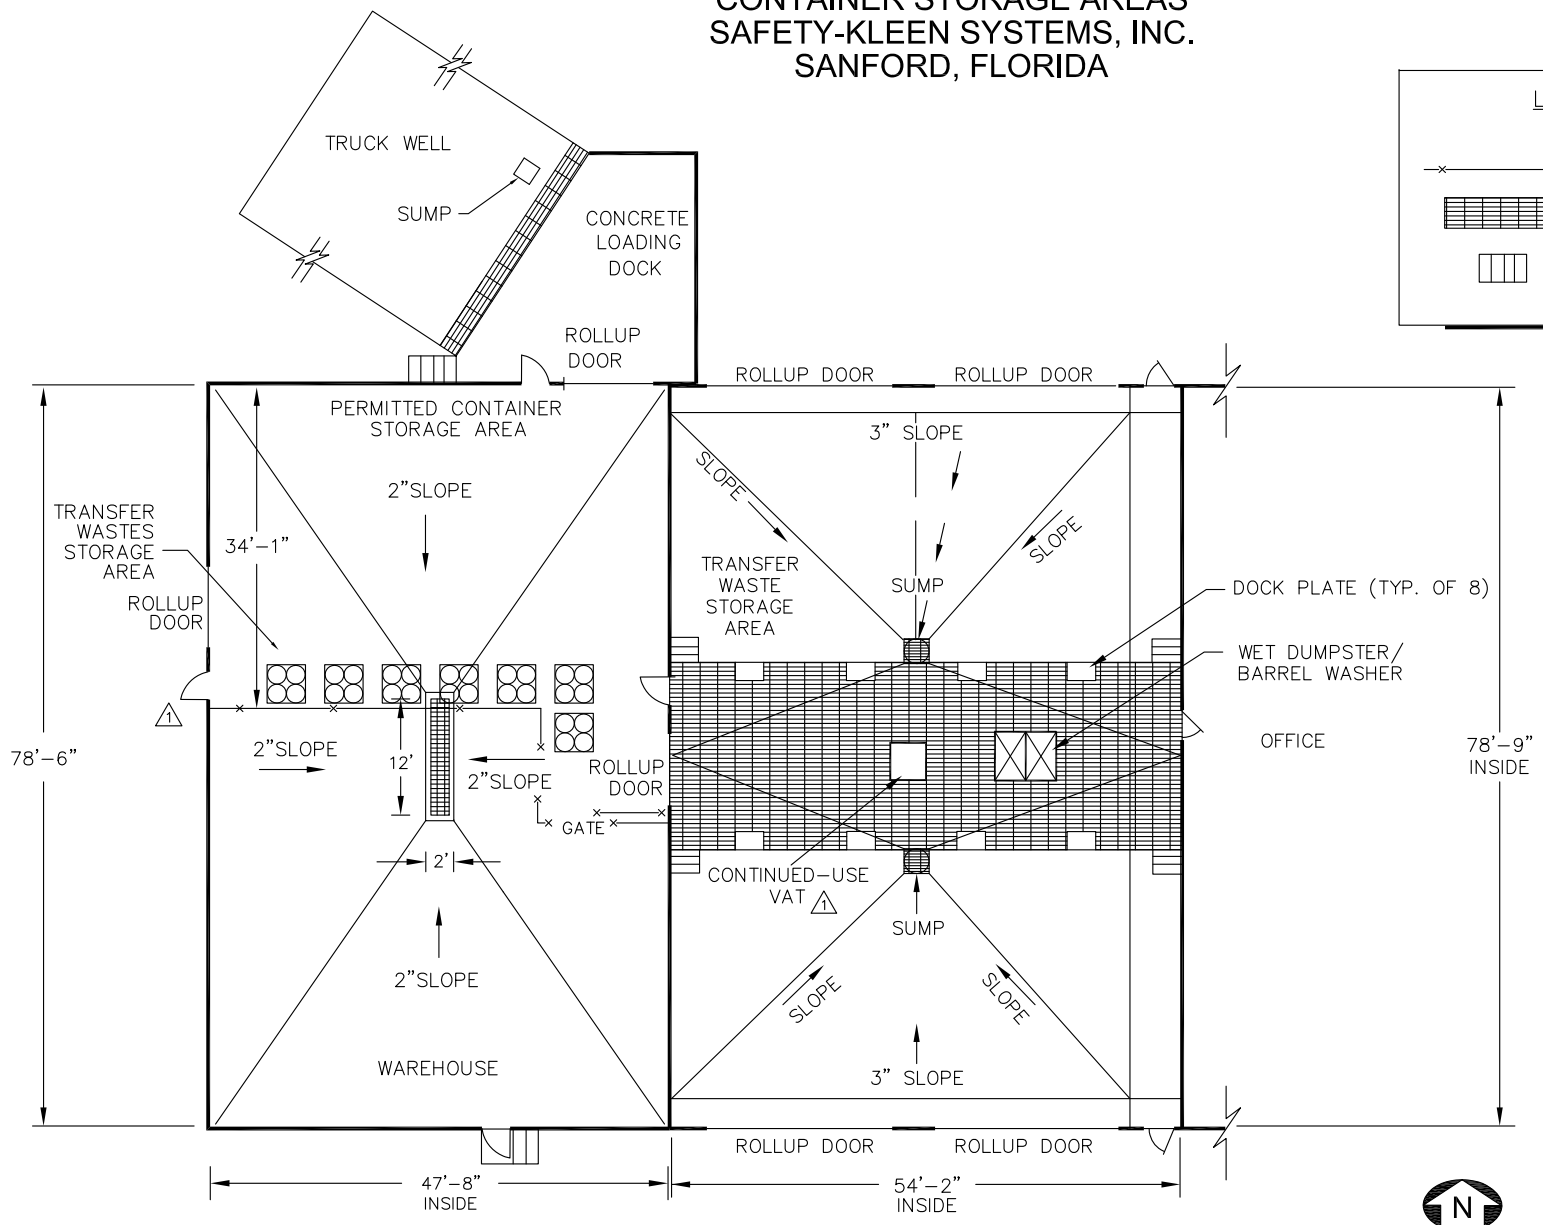

N

0 20
APPROXIMATE SCALE
(FEET)

