



RECEIVED
APR 16 1993
Hazardous Waste
PERMITTING

Hand Delivered

April 14, 1993

Ms. Mary McGehee
Hazardous Waste Permitting
Florida Department of Environmental
Regulation - Central District
3319 Maguire Blvd., Suite 232
Orlando, FL 32803-3767

Subject: Supplement to April 8, 1993 Submittal
Response to First Notice of Deficiency
Sanford Facility, Seminole County
EPA ID # FLD 984 171 165

Dear Ms. McGehee:

As mentioned under item 11 of our April 8, 1993 letter, this letter is to respond to item 11. of your March 3, 1993 Notice of Deficiency.

Enclosed with this letter are four copies of a revised Figure II.B.1-1. The revision now shows a designated area for storing transfer wastes up to 10 days. The revision also includes a note which describes our intent to double stack transfer waste drums in the designated area only when there is no more floor space in the designated area to place transfer wastes. We do not foresee this situation from occurring too often; however, we would like to have the flexibility to double stack when this situation occurs. The volume of all transfer waste containers stored will, of course, be included when comparing the total containerized hazardous waste volume with the permitted container storage limit.


Thank you for your assistance in this matter. If I can be of any assistance, please call me at (813)682-8094.

Sincerely,

Victor L. San Agustin, P.E.
Regional Environmental Manager
Tampa Region

cc: Satish Kastury, BSHW
Allan Farmer, USEPA IV

Figure II.B.1-1
 Container Storage Area
 Safety-Kleen Corp. Facility
 Sanford, Florida

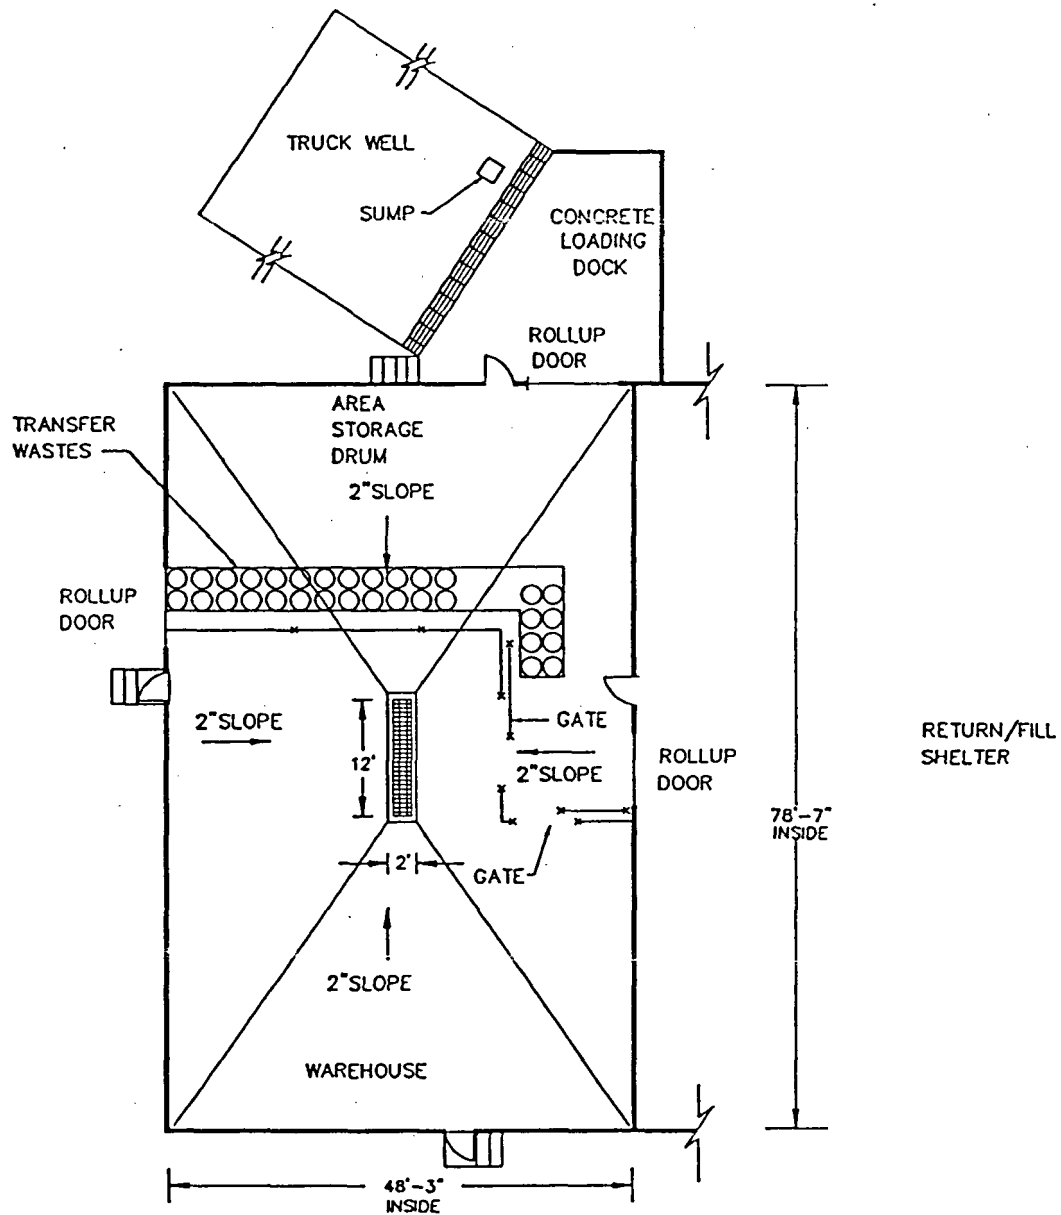

LEGEND	
	FENCE
	GRATING
	STAIRS

Note: Transfer waste drums may be double stacked in the designated area only when there is no more floor space available in the designated area.



REVISION 1 - 02-15-93

