

SURVEYOR'S NOTES

- NOTICE: THERE MAY BE ADDITIONAL RESTRICTIONS AND/OR OTHER MATTERS THAT ARE NOT SHOWN ON THIS PLAT OF SURVEY/SKETCH OF DESCRIPTION THAT MAY BE FOUND IN THE PUBLIC RECORDS OF THIS COUNTY. THIS SURVEY/SKETCH OF DESCRIPTION PREPARED WITHOUT BENEFIT OF AN ABSTRACT.
- DIMENSIONS ARE SHOWN IN FEET AND DECIMALS THEREOF.
- BEARING STRUCTURE BASED ON STATE PLANE GRID WITH THE BEARING ON THE LINE VCL20 TO VCL21 BEING S89°22'38"E.
- UNDERGROUND FOUNDATIONS, IF ANY, NOT LOCATED.
- ELEVATIONS REFER TO N.G.V.D. OF 1929, PER SITE BENCHMARK VCL 20 HAVING AN ELEVATION OF 30.64 FEET.
- NOT VALID WITHOUT THE SIGNATURE AND THE ORIGINAL RAISED SEAL OF A FLORIDA LICENSED SURVEYOR AND MAPPER.
- UNLESS OTHERWISE SHOWN, RECORD DISTANCES AND DIRECTIONS AND FIELD MEASURED DISTANCES AND DIRECTIONS ARE THE SAME.

RECEIVED
JUN 01 2011
DEP Central Dist.

UTILITY STATEMENT:

THE INACCESSIBLE UNDERGROUND UTILITIES SHOWN ON THIS SURVEY HAVE BEEN LOCATED FROM ABOVE GROUND FIELD UTILITY LOCATIONS PROVIDED BY SUNSHINE NETWORK, TICKET # _____ ON OR ABOUT 8-30-99 AND/OR EXISTING AS-BUILTS DRAWINGS PROVIDED BY THE CLIENT. SLIGER AND ASSOCIATES, INC. (S&A) MAKES NO GUARANTEES THAT THE UNDERGROUND UTILITIES SHOWN COMPRISE ALL SUCH UTILITIES IN THE AREA, EITHER IN-SERVICE OR ABANDONED. LIKEWISE S&A DOES NOT WARRANT THAT THE UNDERGROUND UTILITIES SHOWN ARE IN THE EXACT LOCATION INDICATED. ONLY THAT S&A HAS LOCATED THE UTILITIES AS ACCURATE AS POSSIBLE FROM SAID FIELD LOCATIONS AND/OR AS-BUILTS PROVIDED BY OTHERS. S&A HAS NOT PHYSICALLY LOCATED THE ACTUAL INACCESSIBLE UNDERGROUND UTILITIES, EXCEPT AS SPECIFICALLY NOTED AND DEPICTED ON THIS DRAWING.

SYMBOL	DESCRIPTION	SYMBOL	DESCRIPTION

LEGEND


ADDITIONAL ABBREVIATIONS-TREE LEGEND


CP	CAMPBERRY TREE	SB	SUGARBERRY TREE
MP	MAPLE TREE	CD	CEDAR TREE
SY	SYCAMORE TREE	EM	ELM TREE
OK	OAK TREE	CIT	CITRUS TREE
SG	SWEET GUM TREE	PN	PINE TREE
HK	HICKORY TREE	PM	PALM TREE
CB	CHINABERRY TREE	HY	HOLLY

TREE TYPE

○ OK24" 8" TREE SIZE (INCHES) DIAMETER AT BREAST HEIGHT

○ TREE SYMBOL

○ MULTIPLE TRUNKS

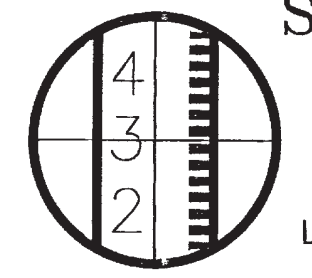

SLIGER & ASSOCIATES, INC.
PROFESSIONAL LAND SURVEYORS
3921 NOVA ROAD
PORT ORANGE, FL 32127
(386) 761-5385
LICENSED BUSINESS CERTIFICATION NUMBER 3019
www.sligerassociates.com
Copyright © 2011 Sliger & Associates, Inc.

TOMOKA FARMS ROAD SOLID WASTE VOLUSIA COUNTY, FLORIDA

FOR: VOLUSIA COUNTY PUBLIC WORKS

JOB NO. 11-0263

FOR: VOLUSIA COUNTY PUBLIC WORKS

SCALE: 1"=20'

TYPE OF SURVEY	SURVEY DATE	JOB NUMBER	PARTY CHIEF	DRAWN BY	CHECKED BY
AS-BUILT SURVEY	04-08-2011	11-0263	CVK	DH	JZ
TOPOGRAPHIC SURVEY					
FOUNDATION LOCATION					
FINAL IMPROVEMENTS					
RECERTIFICATION					

PLAT PREPARED FOR THE FOLLOWING: (ONLY THE LAST DATE IS CERTIFIED ON SEALED COPY)

TYPE OF SURVEY	CERTIFIED TO	SURVEY DATE	JOB NUMBER
AS-BUILT	VOLUSIA COUNTY PUBLIC WORKS	APRIL 8, 2011	11-0263
	HDR ONE COMPANY		
	NOT CERTIFIED TO ANY ENTITIES AND/OR INDIVIDUALS OTHER THAN THOSE LISTED ABOVE.		

AS-BUILT SURVEY OF TOE DRAIN AND LINER

I HEREBY CERTIFY THAT THIS PLAT MEETS THE MINIMUM TECHNICAL STANDARDS SET FORTH BY THE FLORIDA BOARD OF PROFESSIONAL SURVEYORS AND MAPPERS IN CHAPTER 11, § 11.05, FLORIDA ADMINISTRATIVE CODE, PURSUANT TO SECTION 4727, FLORIDA STATUTES.

SLIGER & ASSOCIATES, INC.
J.E. ZAPERT, P.L.S. NO. 4046
STEVEN W. KROGER, P.L.S. NO. 4722
C.O. VAN KLEECK, P.L.S. NO. 6149
MICHAEL S. MURPHY, P.L.S. NO. 6208