
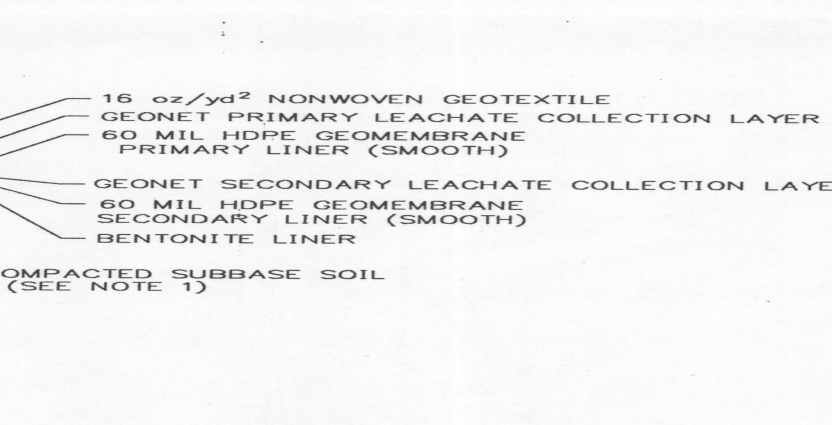
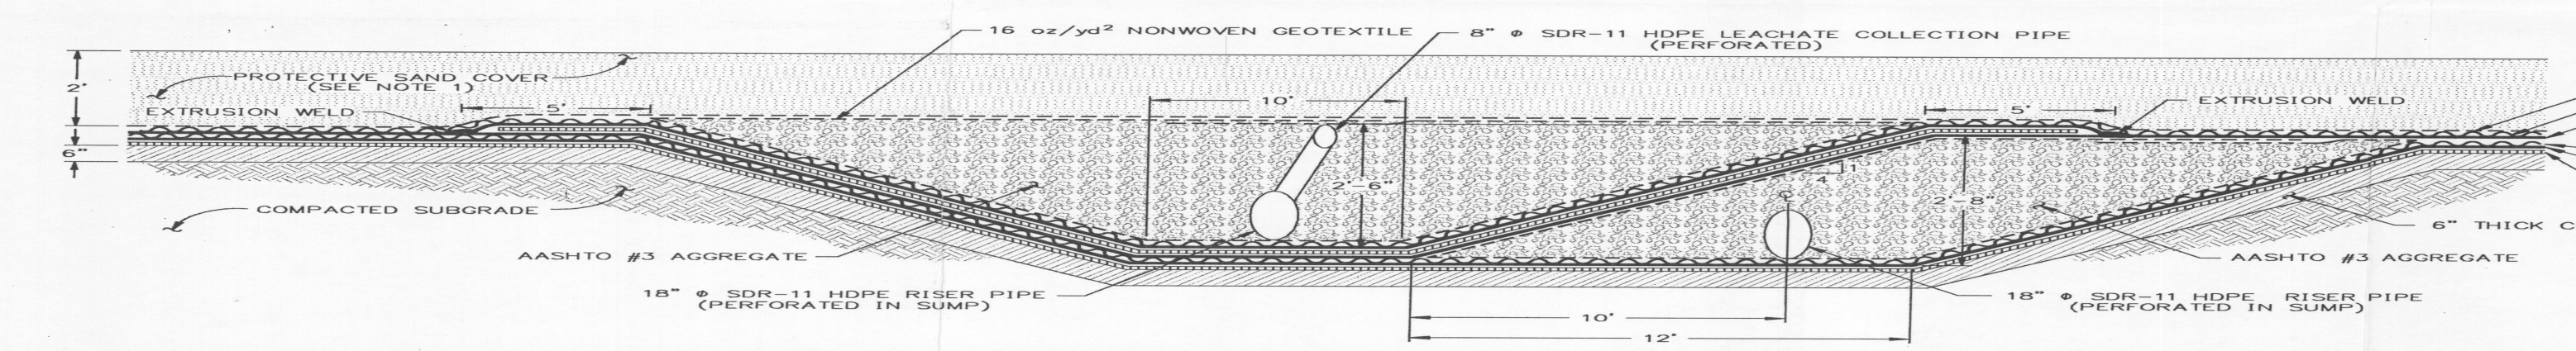
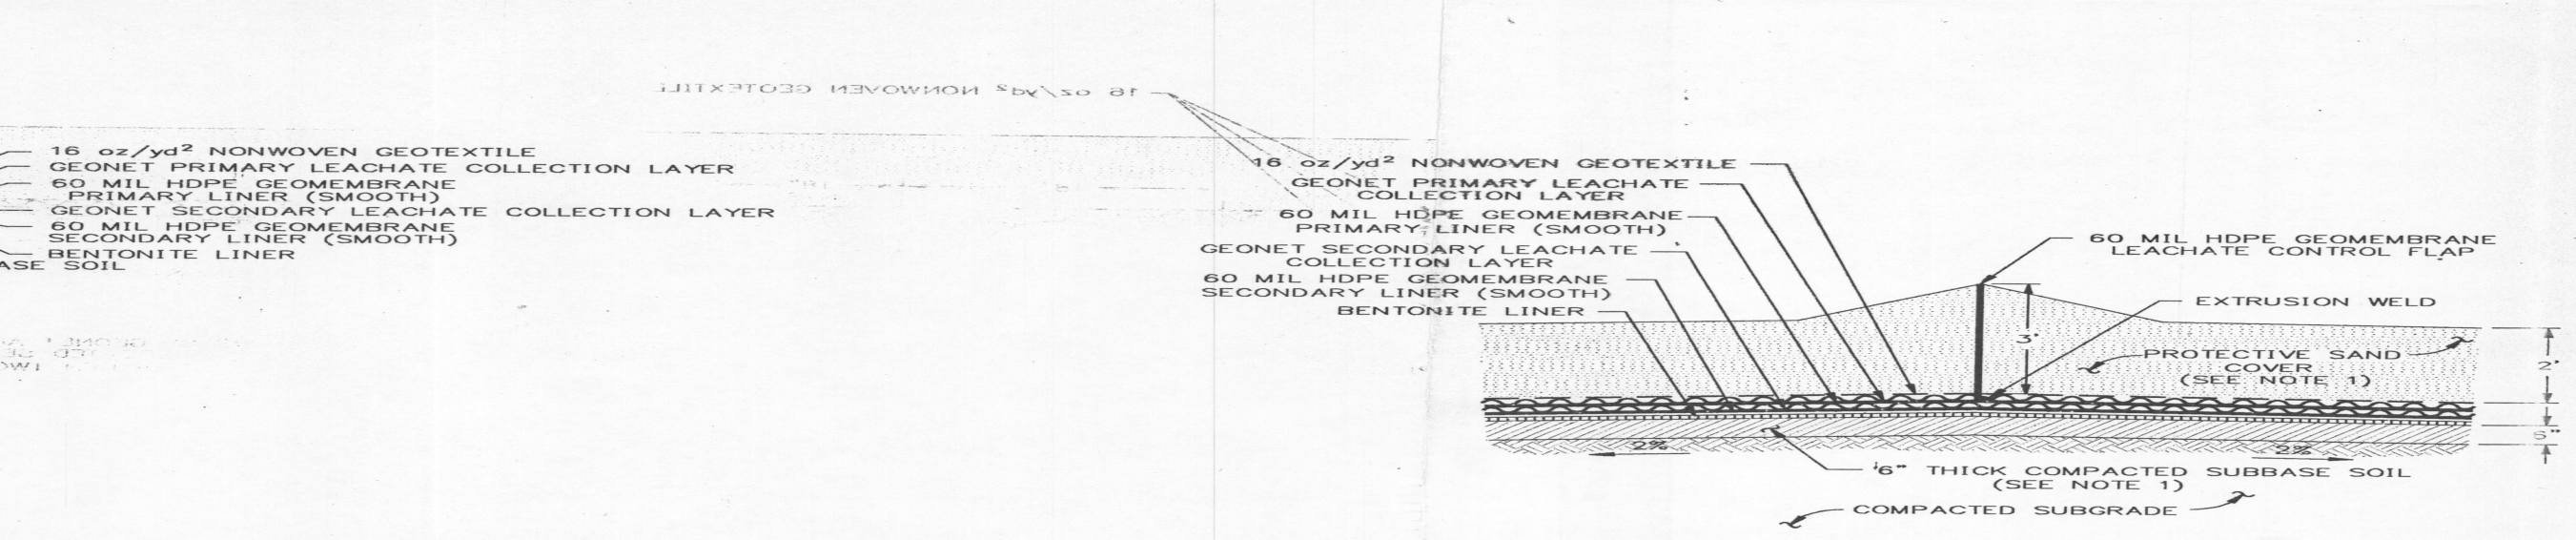
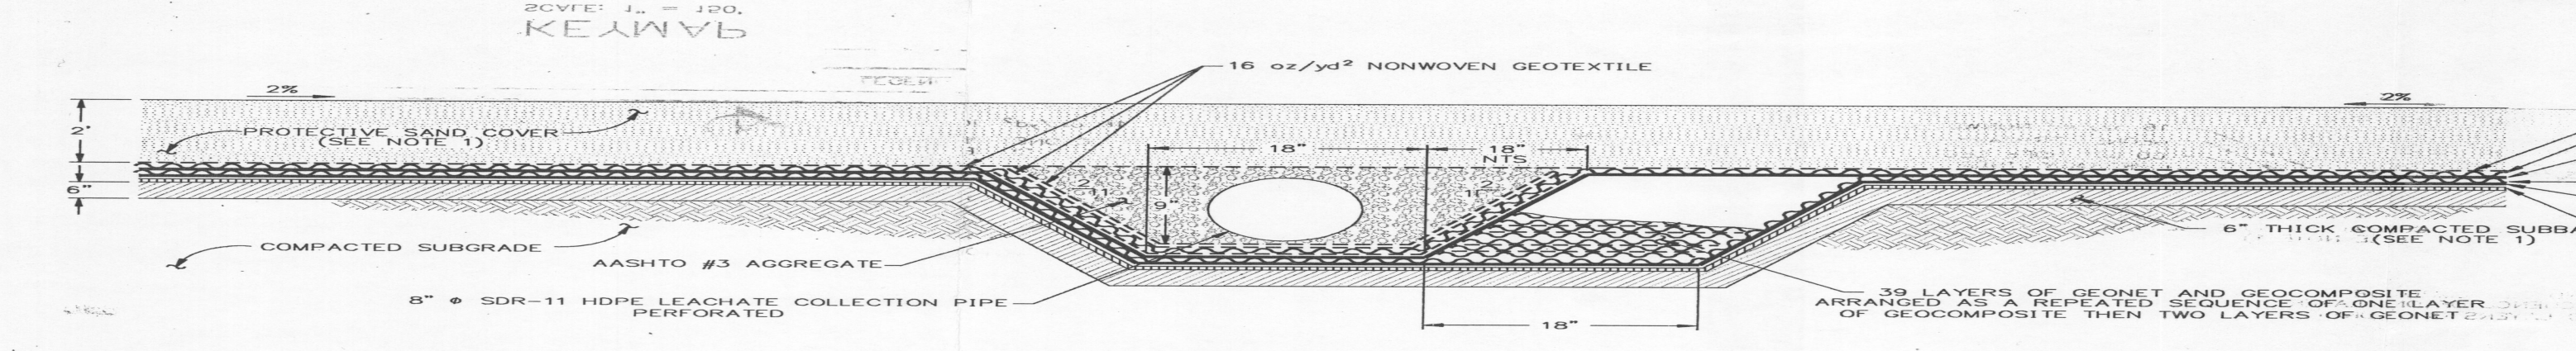
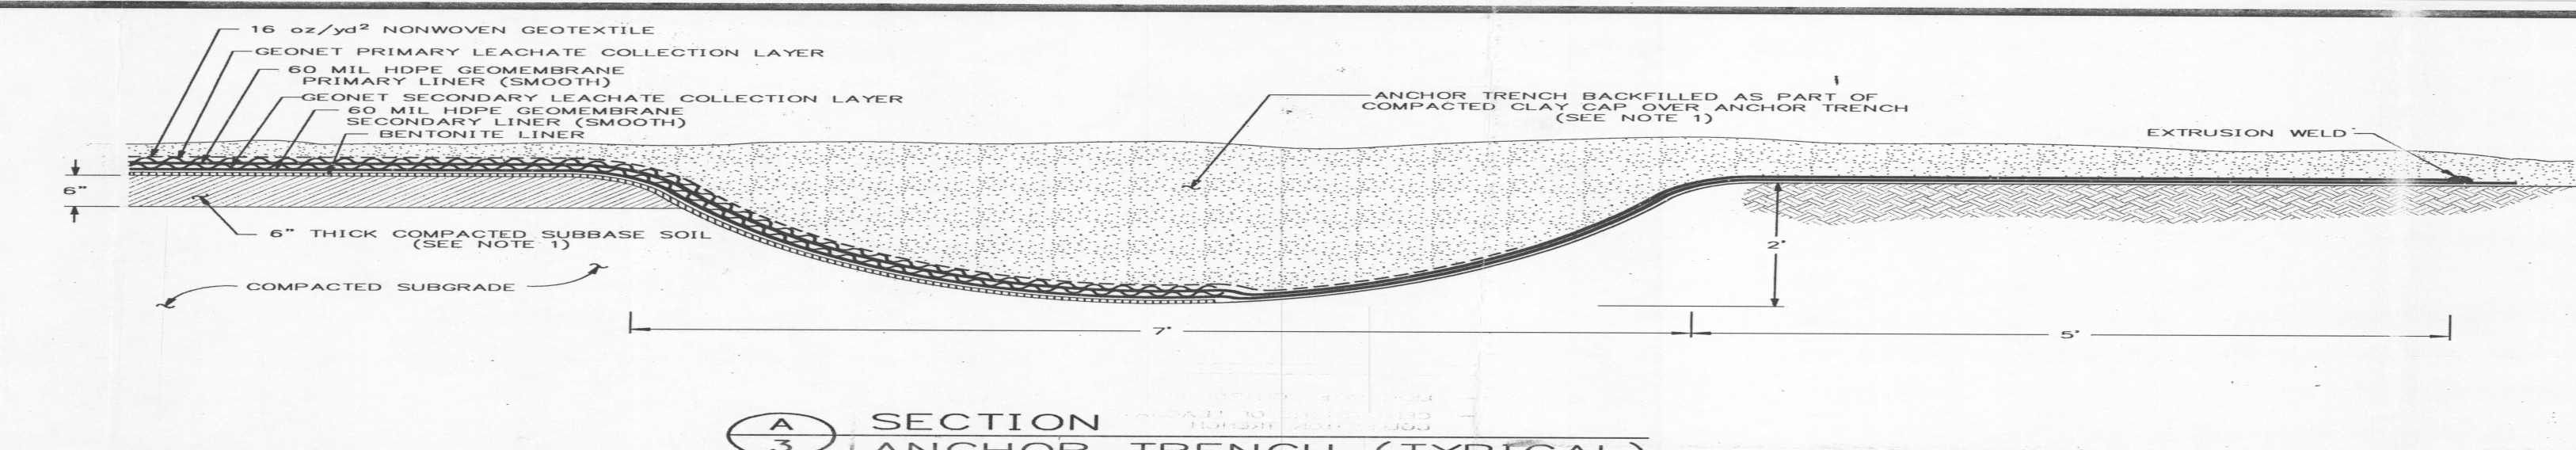


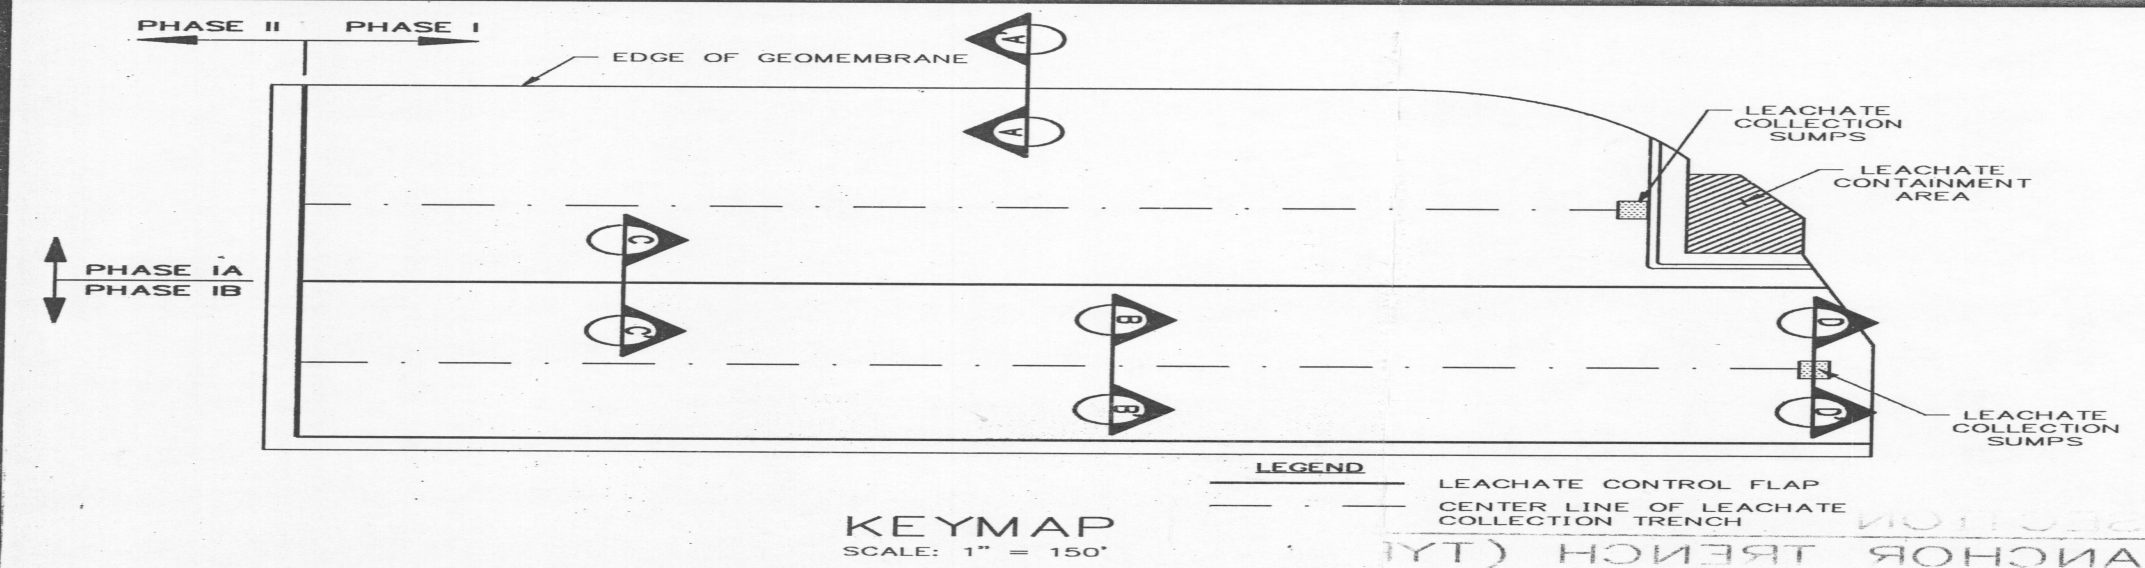

NOTE:
1. GSA MONITORING FOR THE CONSTRUCTION OF THE 6 IN. (150-MM) THICK COMPACTED SUBBASE SOIL, MATERIAL PROPERTIES OF THE 2-IN. (50-MM) THICK PROTECTIVE SAND COVER, BACKFILLING OF THE ANCHOR TRENCH, AND CONSTRUCTION OF THE COMPACTED CLAY CAP OVER THE ANCHOR TRENCH WAS PROVIDED BY LAW ENVIRONMENTAL OF JACKSONVILLE, FLORIDA.

REV.	DATE	DESCRIPTION	DRN BY	APP BY
1	5-9-92	PROJECT NO. 1000-0-1 SCALE: AS SHOWN		
2	5-5-92	PROJECT: TRAIL RIDGE LANDFILL		
3	5-5-92	PHASE I AND II		
4	5-5-92	SHEET TITLE: DETAILS		
5	5-5-92			

Trail Ridge Landfill, Inc.

SHEET 3 OF 3
DRAWING NO. 3