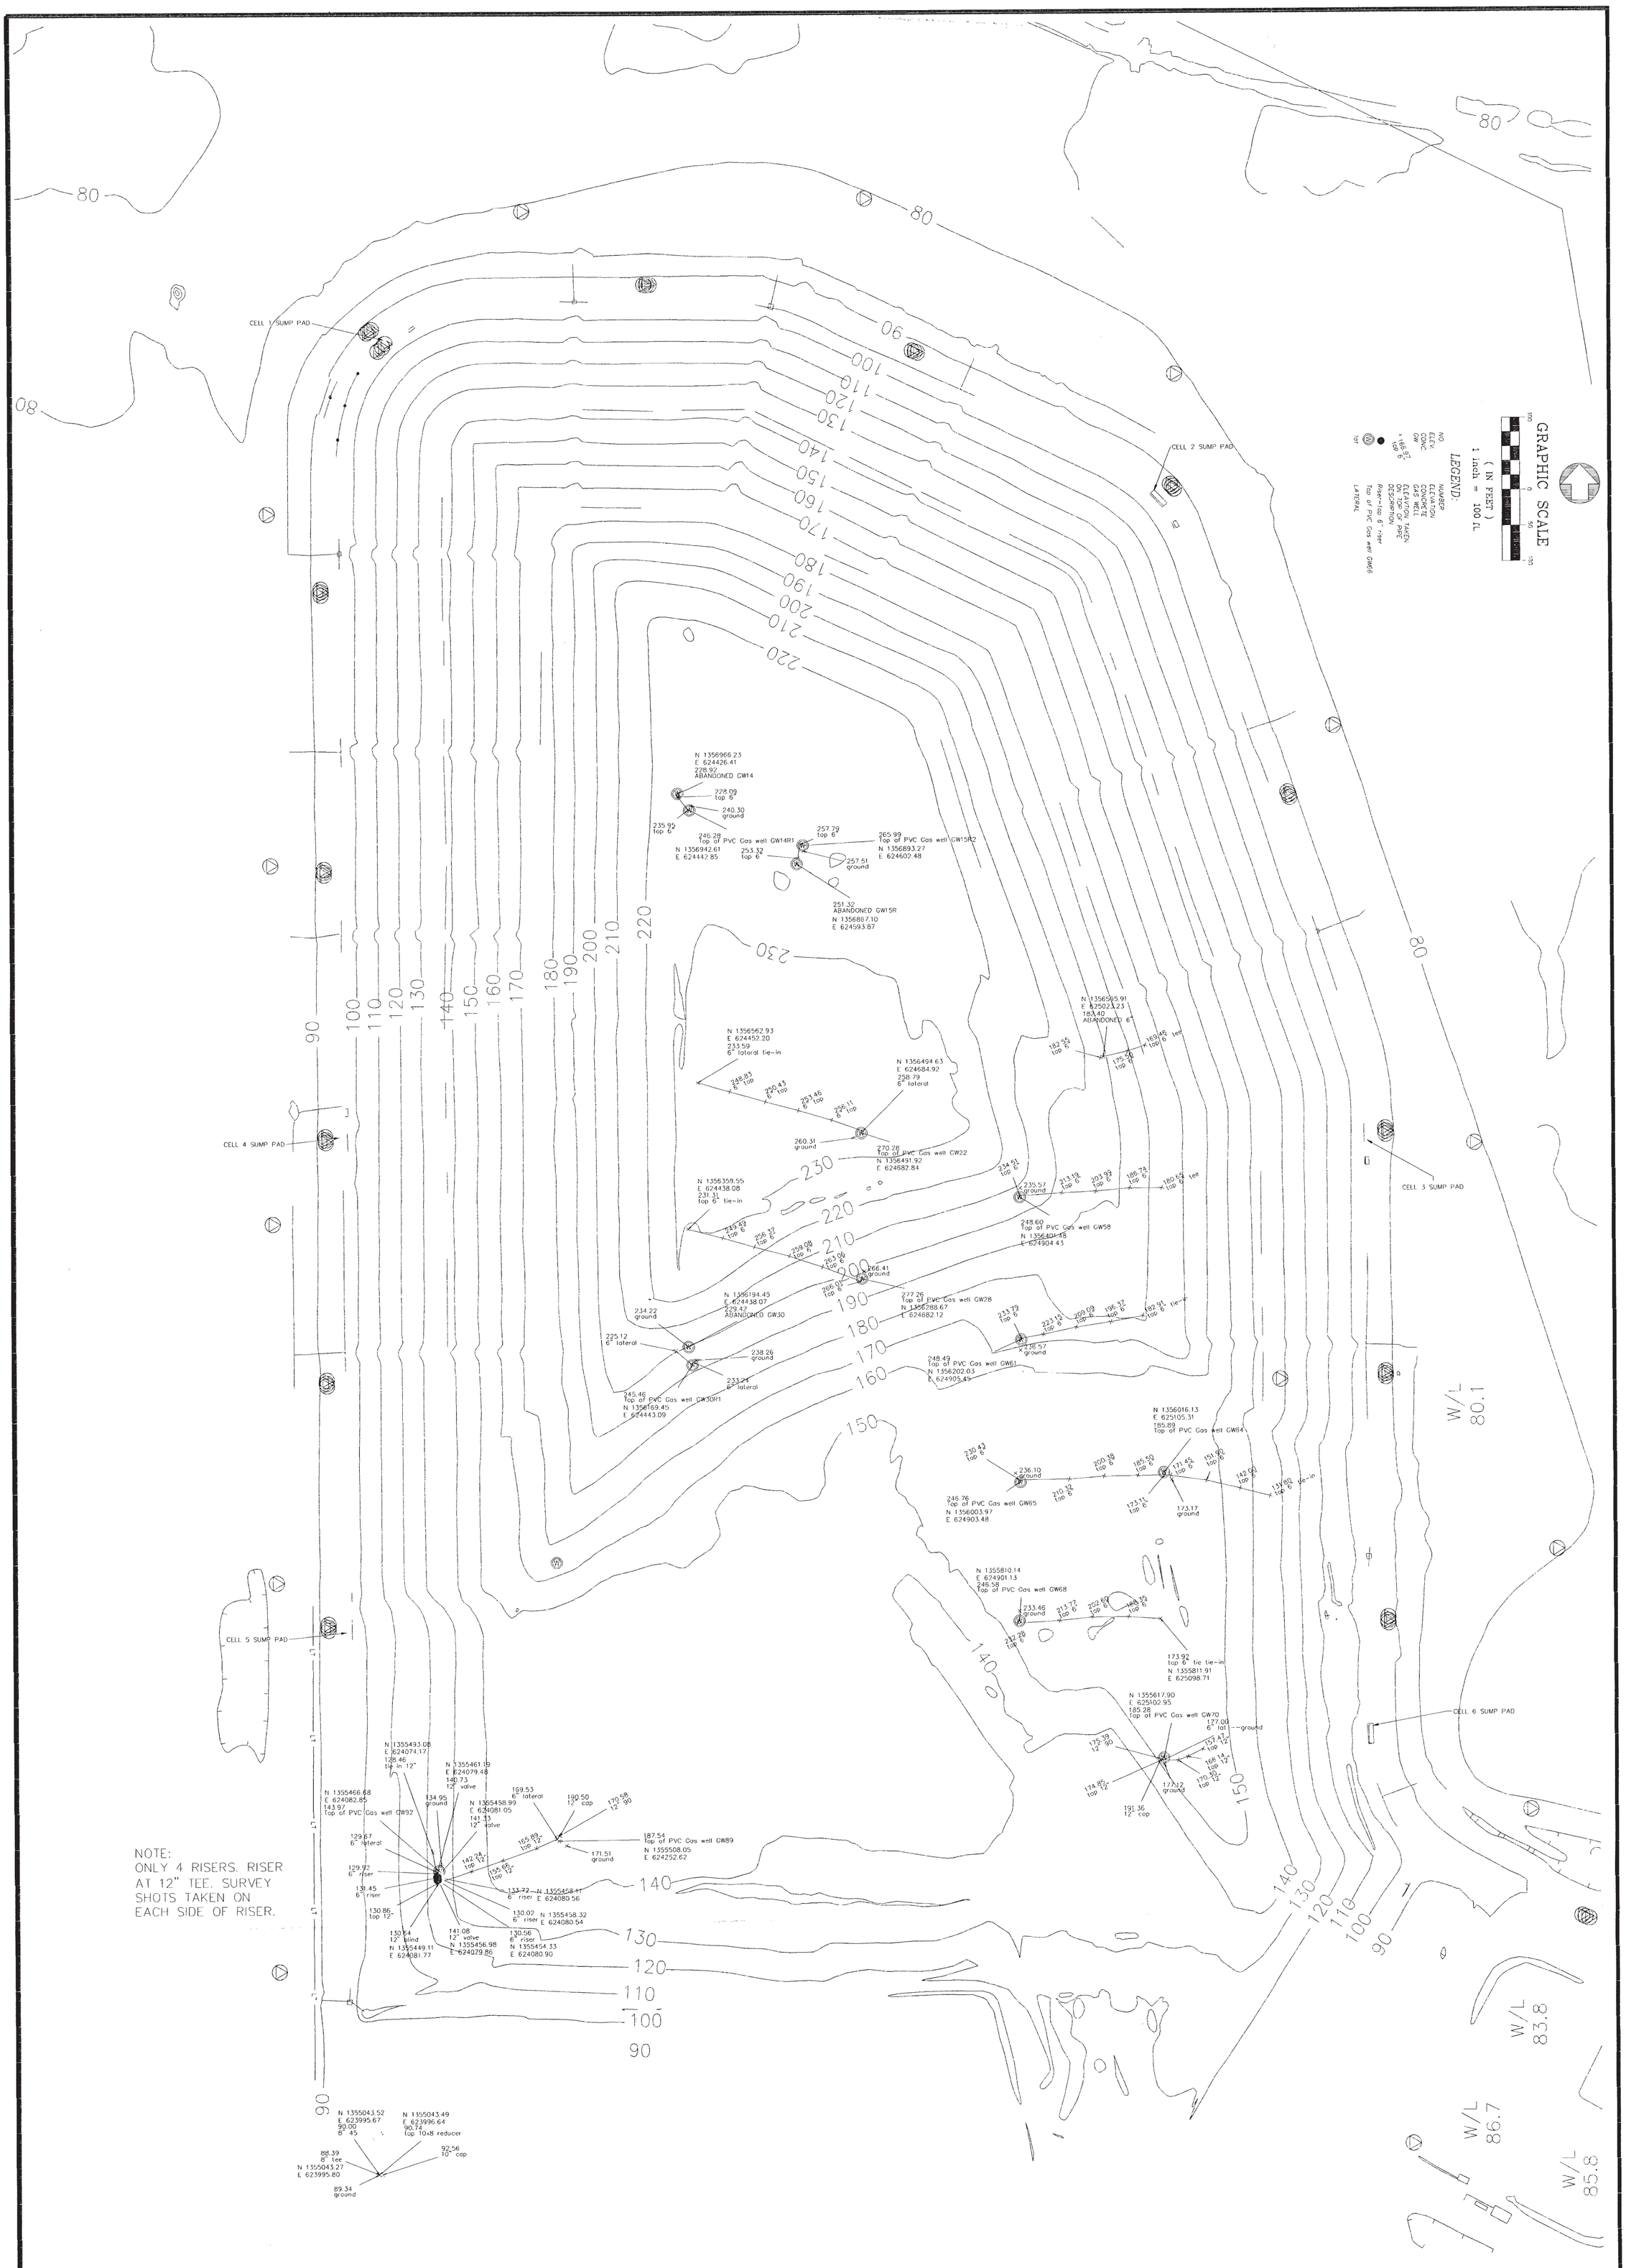

SURVEYOR's NOTES:

1.) North and coordinate basis is the East Zone of the Florida State Plane Coordinate System, and are based on NGS Control Station Numbers AJ7660(J496) and verified Pickett & Associates Targets 1 and 2 from Topographic Survey dated 12/13/01 as provided. The published values used for this survey are NAD 83 2007 adjustment. The Mapping data shown hereon is based on Pickett & Associates Survey as provided by client.

2.) Vertical information depicted on this report are GPS derived elevations based on the National Geodetic Vertical Datum of 1929 (NGVD29) utilizing site control as provided PK13 with an elevation of 92.92 and OC1406 with an elevation of 80.91.

ASBUILT SURVEY - GCCS
PH1&2 CELLS 3 THROUGH 7
J.E.D. SOLID WASTE MANGEMENT FACILITY
1501 OMNI WAY ST. CLOUD, FL

CLIENT:

Omni Waste of Osceola County, LLC
Waste Services, Inc.
1501 Omni Way
St. Cloud, Fl 34773

PEAVEY & ASSOCIATES
SURVEYING AND MAPPING, PA
690 ALICE PLACE
BARTOW, FLORIDA 33830
PHONE: (863) 738-4960
FAX: (863) 533-6972

Drawn By: DLP
Party Chief: DR
Field Book:
Page:

THIS SURVEY IS NOT VALID WITHOUT THE SIGNATURE AND ORIGINAL RAISED SEAL OF A FLORIDA LICENSED SURVEYOR AND MAPPER.

FILE NAME: 617-jed-gaspipe-12-14-2011

NO.	DATE	REVISION

PROJECT NO. 617 SHEET 1 OF 1