


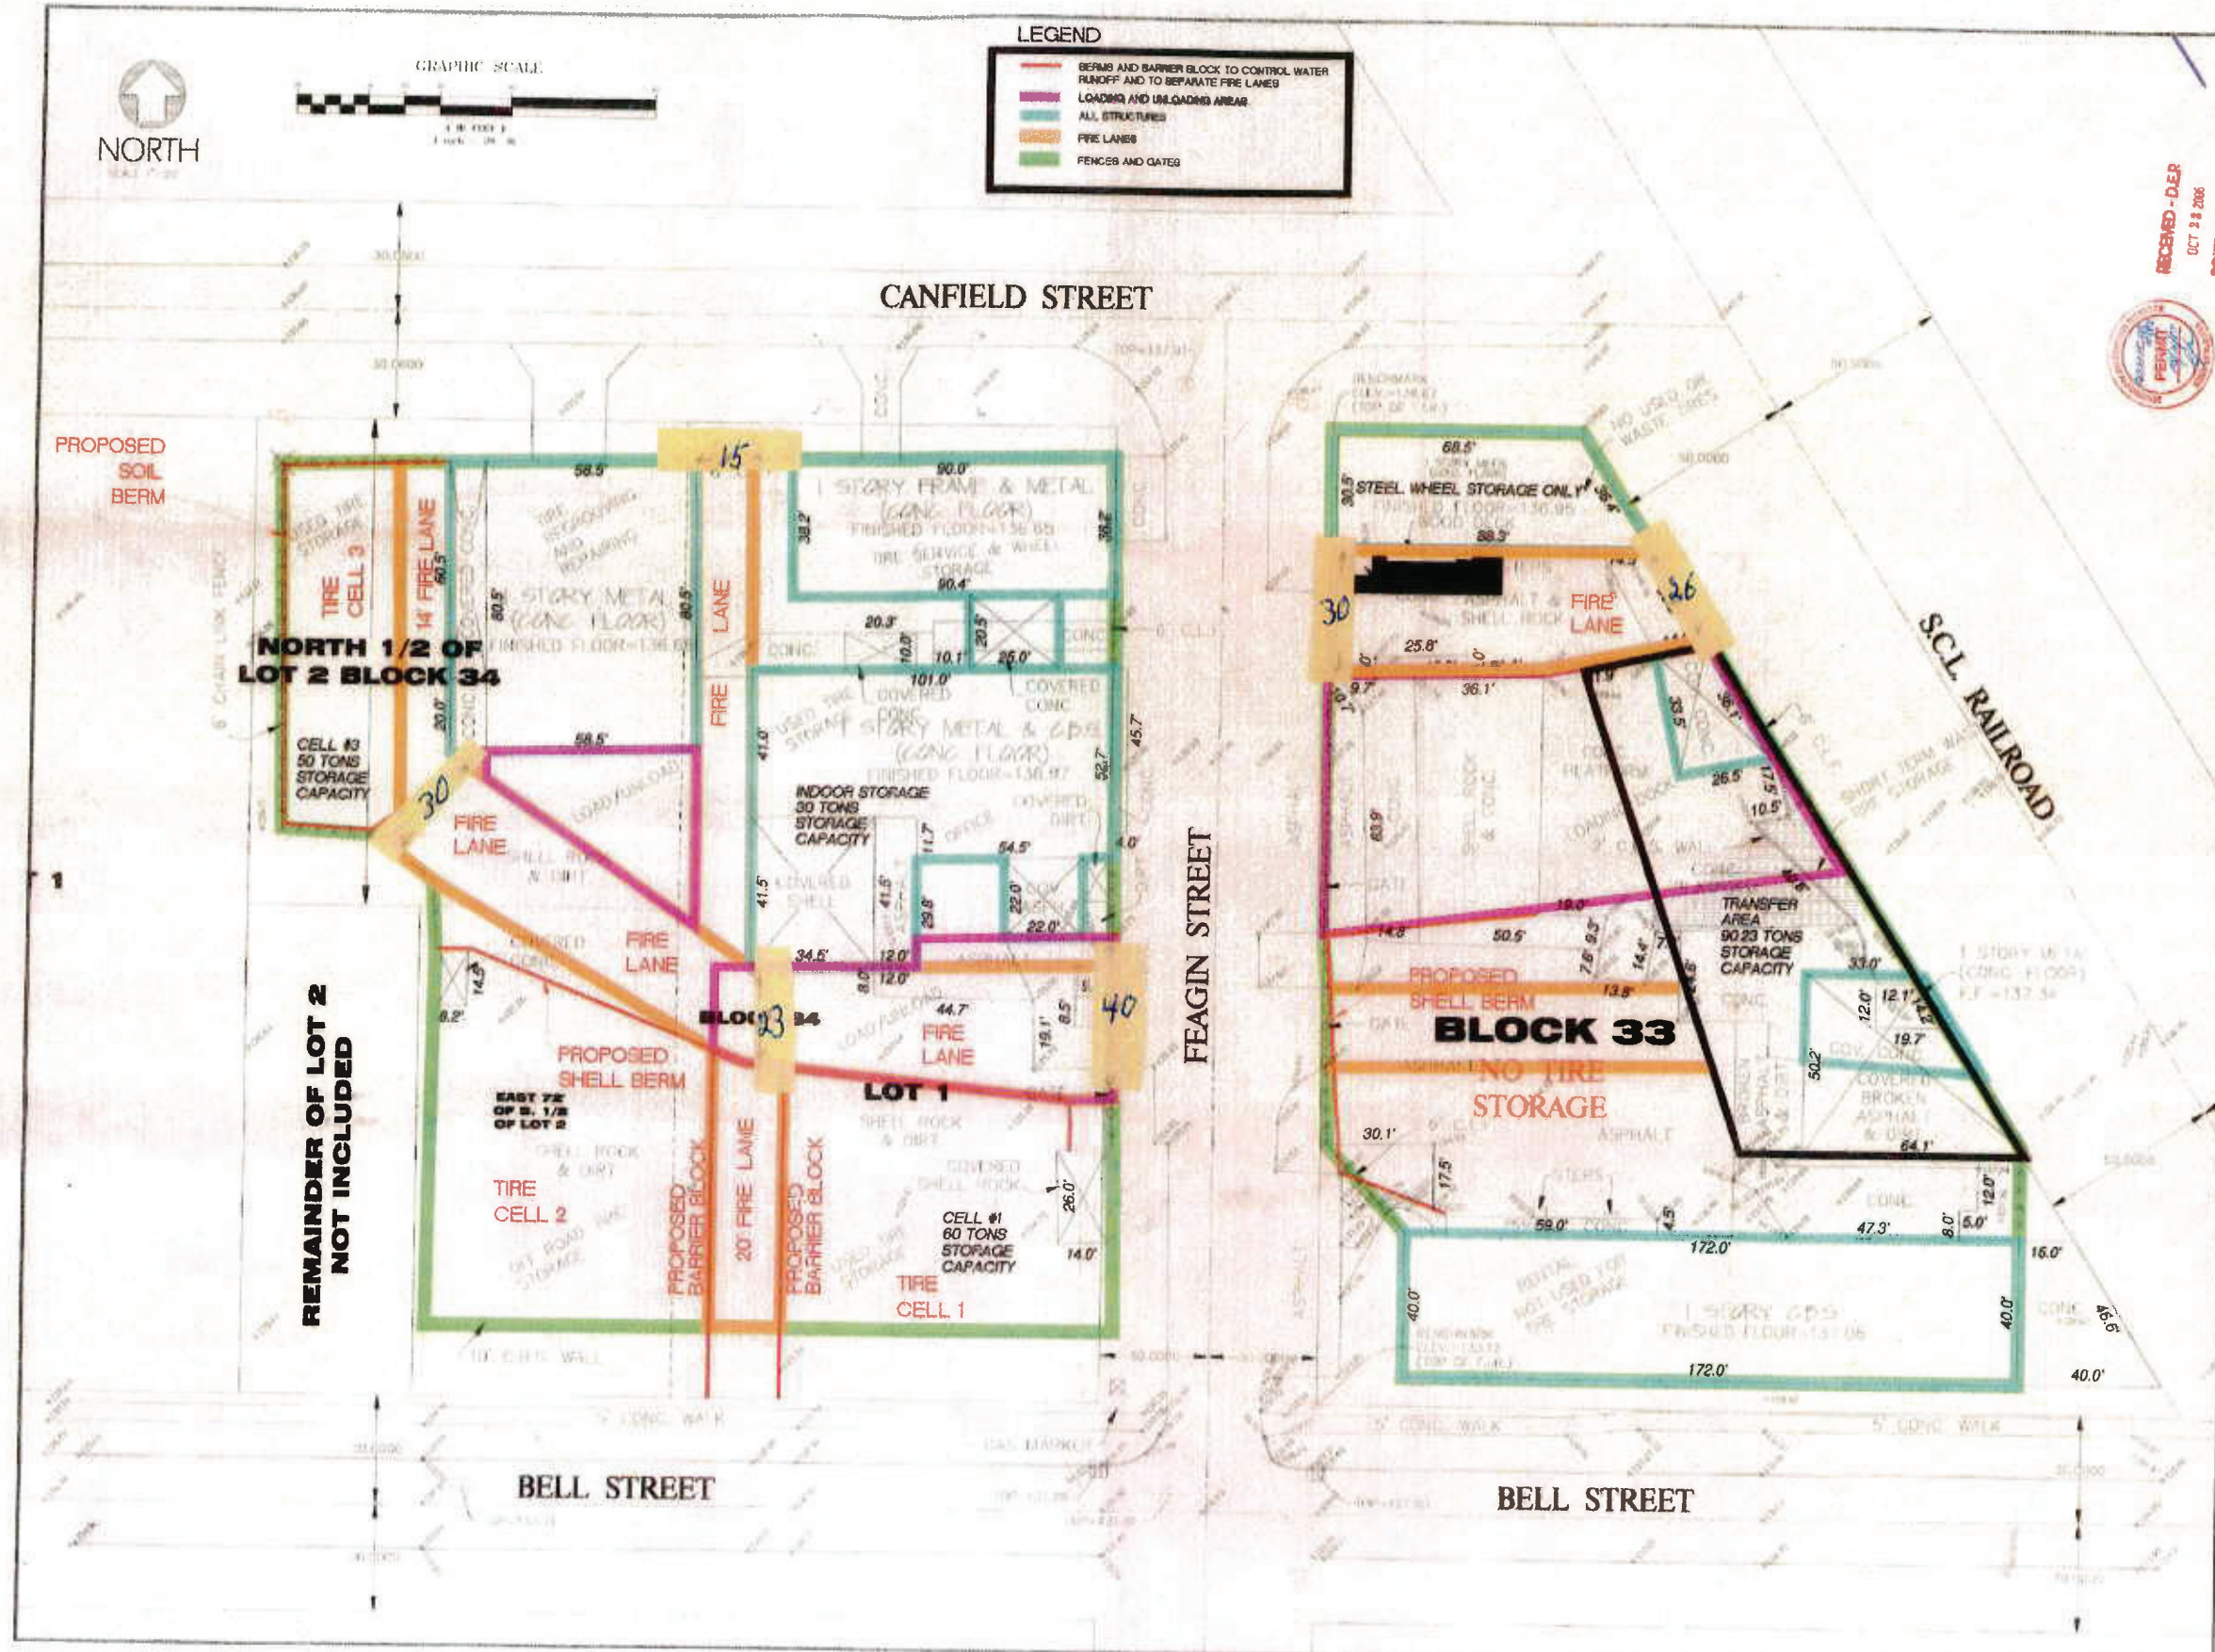

- LEGEND**
- BERMS AND BARRIER BLOCK TO CONTROL WATER RUNOFF AND TO SEPARATE FIRE LANES
 - LOADING AND UNLOADING AREAS
 - ALL STRUCTURES
 - FIRE LANES
 - FENCES AND GATES



BECK'S TIRE SERVICE - FLORIDA TIRE TERMINAL - ATTACHMENT IIIA.2.a - FACILITY PLAN

STATE OF FLORIDA BOARD OF PROFESSIONAL ENGINEERS
BUSINESS CERTIFICATE OF AUTHORIZATION NUMBER 10644
PROFESSIONAL ENGINEER ROGER D. POLSTON P.E. NUMBER 33871-0568
PROFESSIONAL ENGINEER MARTIN LUTHER MOLES P.E. NUMBER 40020

POLSTON ENGINEERING, INC.
2025 KENILWORTH BLVD., P.O. BOX 508
SEBRING, FLORIDA 33871-0508
888-385-6564

SCALE: 1" = 20'
DATE: 03/15/2008
DRAWN BY: [Signature]
CHECKED BY: [Signature]
APPROVED BY: [Signature]

RECEIVED - D.E.R.
OCT 22 2008
SOUTH DISTRICT