

# LEE COUNTY SOLID WASTE ENERGY RECOVERY FACILITY (SWERF)

## SIX NESTS OF MONITORING WELLS

### DEPTHS

MW-1S	14.3'	}	GRADIENT (BACKGROUND)
MW-1D	93'		

MW-2S	12.0'	5S	12.1'
2D		5D	94'
3S	13.1'	6S	12.2'
3D	92'	6D	96'
4S	13.4'		
4D	96'		

JULY 1993 - BACKGROUND GW SAMPLING CONDUCTED

DECEMBER 1994 - SWERF OPENED

AS OF APRIL 1996 - 3 ANNUAL + 11 QUARTERLY SAMPLING  
EVENTS CONDUCTED

ANNUAL EVENTS: MW-1, MW-3, MW-5, MW-6  
+ QUARTERLY

MW-1, MW-2, MW-4


(ALTERNATING)

Frank,

\* Should we look at this [beginning]  
down gradient vs up gradient?

Last modification was 1996.  
Current version of Chapter 6-701  
is 5/27/01. Change parameters  
or keep the same?

Leachate from ash is  
"extra salty." Ash leachate  
here should be comparable to  
ash leachate results from  
the landfill. High sodium  
leachate from artesian well or  
ash leachate? DUV

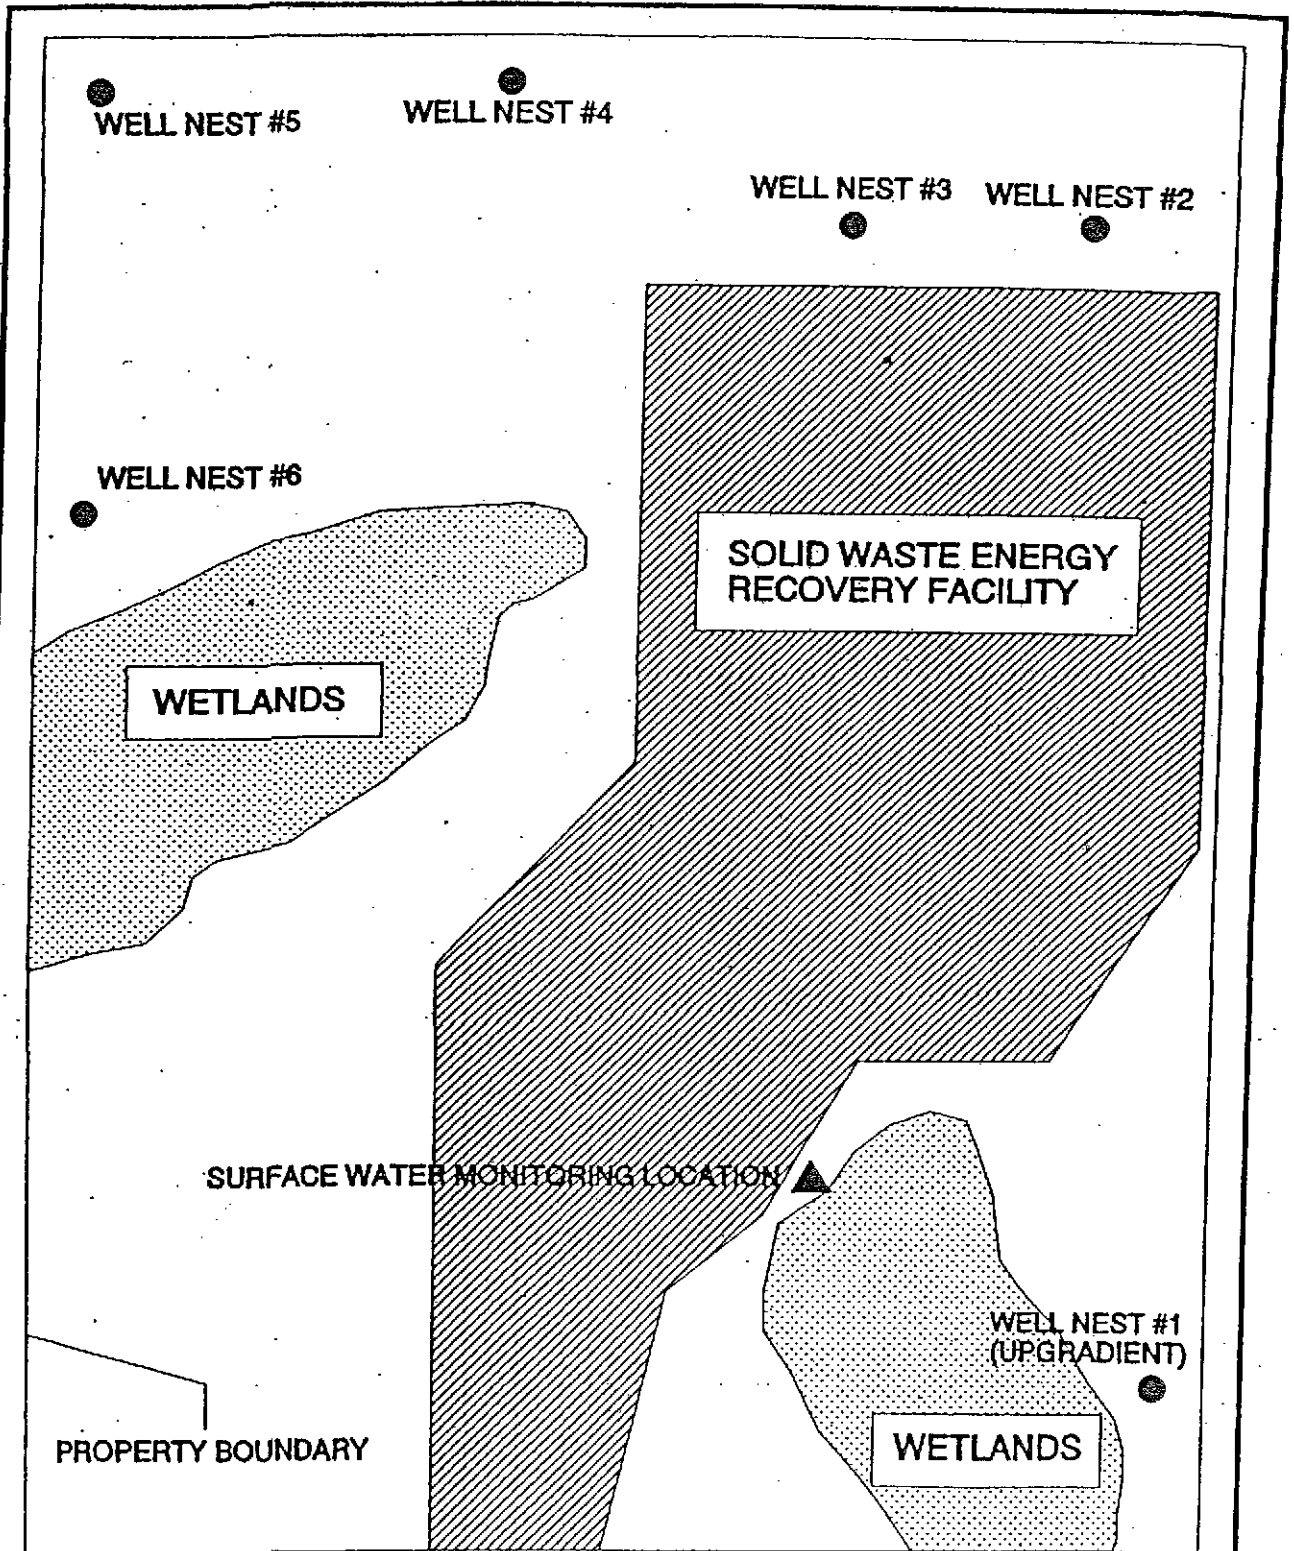

**MALCOLM  
PIRNIE**

LEE COUNTY - FORT MYERS FLORIDA  
 PROPOSED ON-SITE  
 MONITORING LOCATIONS

MALCOLM PIRNIE, INC

FIGURE 13

Lee County Resource Recovery Facility  
 Ground Water Monitoring Well Locations and Elevation Data

Well No.	Northing	Easting	Latitude	Longitude	Elev. Top PVC (ft., NGVD)	Total Depth (ft.)	Casing Dia. (in.)
WTE-1D	8746.32	10502.54	26 deg 37' 42"	81 deg 45' 36"	22.96	93	4
WTE-1S	8742.37	10510.43	26 deg 37' 41"	81 deg 45' 36"	21.91	14.3	2
WTE-2D	10877.66	10431.45	26 deg 38' 03"	81 deg 45' 37"	23.52	93	4
WTE-2S	10885.57	10444.67	26 deg 38' 03"	81 deg 45' 37"	24.18	12	2
WTE-3D	10760.19	9906.72	26 deg 38' 01"	81 deg 45' 42"	23.9	92	4
WTE-3S	10749.55	9907.34	26 deg 38' 01"	81 deg 45' 42"	23.15	13.1	2
WTE-4D	10397.85	9108.26	26 deg 37' 58"	81 deg 45' 51"	23.81	96	4
WTE-4S	10389.31	9113.44	26 deg 37' 58"	81 deg 45' 51"	22.48	13.4	2
WTE-5D	10880.87	8408.35	26 deg 38' 03"	81 deg 45' 59"	24.5	94	4
WTE-5S	10896.92	8399.51	26 deg 38' 03"	81 deg 45' 59"	23.81	12.1	2
WTE-6D	10259.89	8423.76	26 deg 37' 57"	81 deg 45' 59"	22.91	96	4
WTE-6S	10261.19	8435.74	26 deg 37' 57"	81 deg 45' 59"	23.66	12.2	2