

NOTES:

1. THIS PROPERTY CONTAINS AN ACTIVE LANDFILL OPERATION THAT ALTERS THE GROUND CONTOUR ELEVATIONS IN CERTAIN AREAS ON A DAILY BASIS. THE CONTOUR LINES SHOWN HEREON REPRESENT THE PROPERTY CONDITION ON THE DATE OF THE SURVEY.
2. FIELD SURVEY DATE : 12-21-2012.
3. ELEVATIONS AND CONTOURS SHOWN HEREON ARE BASED ON N.G.V.D. DATUM; CITY OF OCALA BM @ N.W. 27th AVENUE AND N.W. 18th STREET; ELEVATION 69.47 (NAVD-88).
4. THE TOP ELEVATION OF THE MONITORING WELLS, AS SHOWN HEREON, REPRESENT THE ELEVATION OF THE TOP OF THE WELL CASING ON THE NORTH EDGE. THE GROUND ELEVATION REPRESENTS THE ELEVATION OF THE GROUND, NEXT TO THE WELL CASING ON THE NORTH SIDE.

SURVEY PREPARED BY:
ROBERT L. ROGERS ENGINEERING CO. INC.
 LIC. BUS. #4074
 1105 S.E. 3rd Ave. OCALA, FLORIDA 34471 (352) 622-9214

LEGEND

	IRON ROD
	RIGHT OF WAY
	UTILITY POLE AND GUY ANCHOR
	OVERHEAD WIRES
	FENCE
	CONCRETE
	GROUND CONTOUR LINE
	TEMPORARY BENCHMARK
	T.B.M. ELEVATION
	LATITUDE
	LONGITUDE

REVISIONS	
PLOTTED:	RMC-3
DRAWN:	RMC-3
DESIGNED:	RMC-3
CHECKED:	RMC-3
SCALE:	1" = 100'


GROUNDWATER CONTOURS

FRIENDS RECYCLING, LLC.
MARION COUNTY, FLORIDA

ENVIRONMENTAL & CIVIL ENGINEERING CONSULTANTS
 PHONE: (352) 694-1799
 FAX: (866) 832-0250

ENVIRO-TECH, INC.
 15290 SE HWY 42, PO BOX 152
 WEIRSDALE, FLORIDA 32195

RECEIVED
 JAN 31 2013
 Dept. Central Files

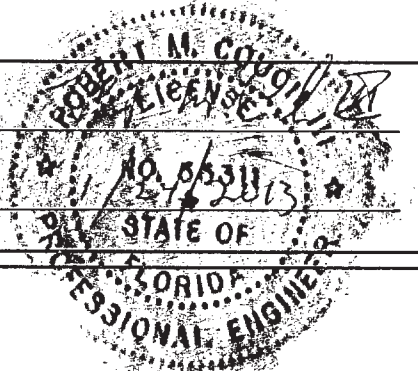

ROBERT M. COUCH III, P.E. :
 FLORIDA REG. No. 55311
 DATE : 10/06/11
 C.O.A. No. 8692

SITE PLAN
 P.N. 2009-
 Sht. 1 of 1