
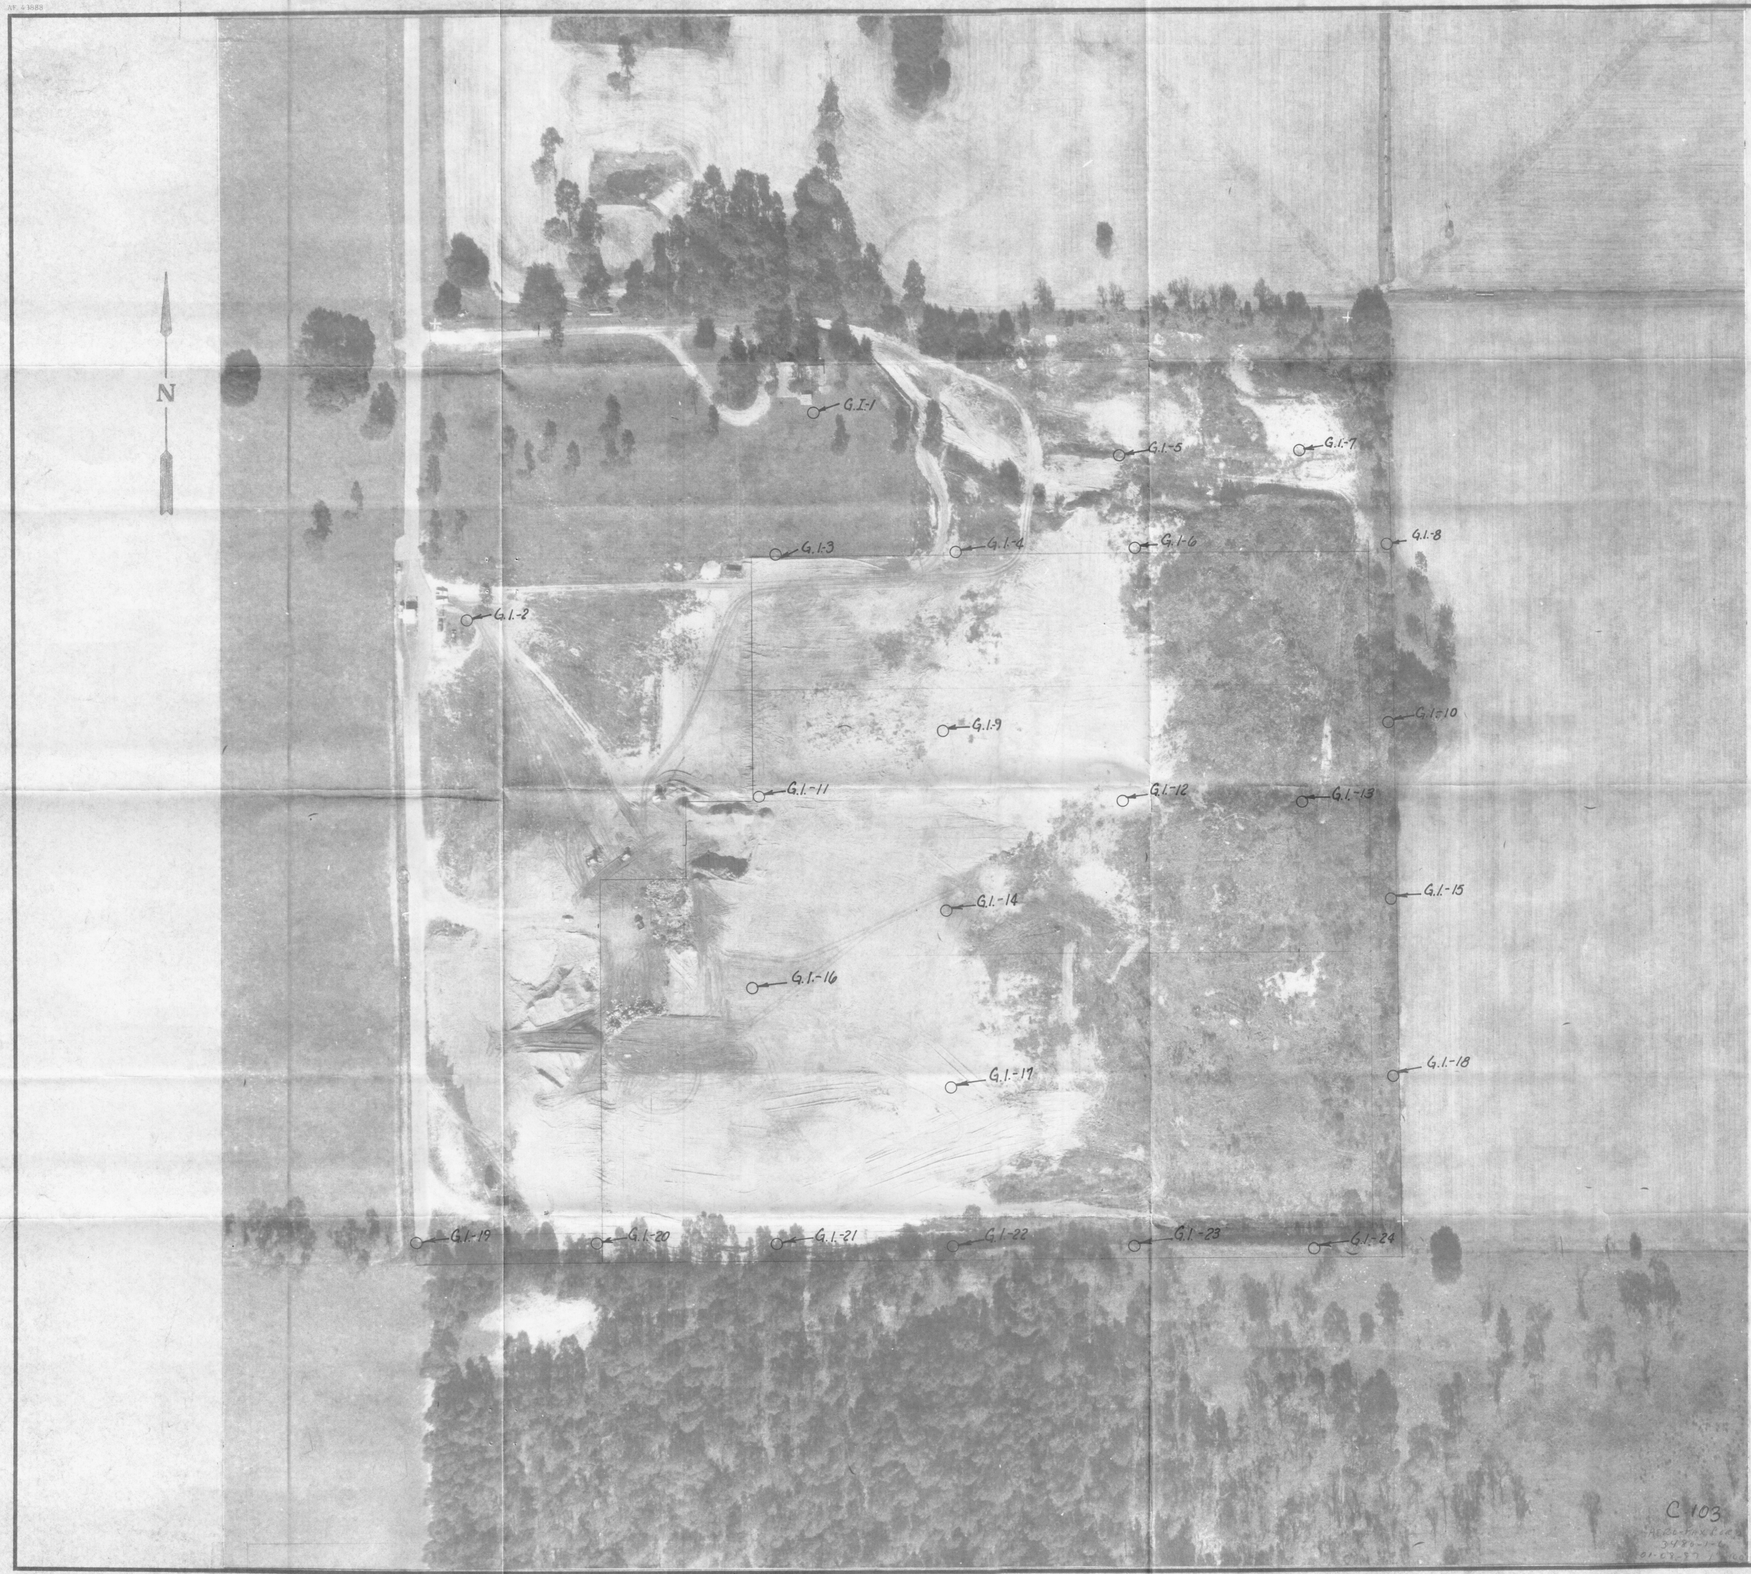


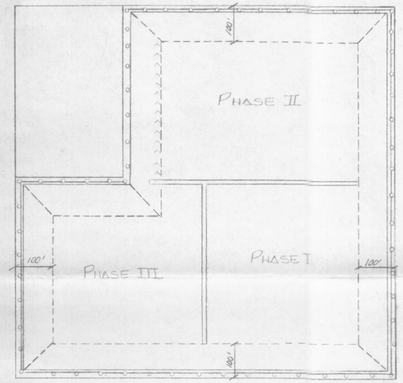

GAS MIGRATION INVESTIGATION - O G.I.-1 LOCATION OF GAS PROBE VENTS

PHOTOGRAPH TAKEN 1-88?

3-31-88 APPROVED BY DER

SPRINGSTEAD ENGINEERING INC.
consulting engineers
Leesburg — Bushnell

AERIAL OF SUMTER CO. LANDFILL

DATE	SCALE	FILE	JOB NO.
3-1987	1"=100'	C-103	C103
DESIGN	DRAWN	CHECKED	SHEET
PB	JAH	PB	1 OF 4

C 103