SPECIFIC PURPOSE SURVEY

DESCRIPTION:

THE SOUTHEAST 1/4 OF THE SOUTHEAST 1/4 OF SECTION 15, TOWNSHIP 20 SOUTH, RANGE 22 EAST, AND THE EAST 50.00 FEET OF THE SOUTHWEST 1/4 OF THE SOUTHEAST 1/4 OF SECTION 15, TOWNSHIP 20 SOUTH, RANGE 22 EAST, SUMTER COUNTY, FLORIDA.

SCALE: 1" = 60'

NOTES:

1. BEARINGS BASED ON THE MONUMENTED SOUTH LINE OF THE SE 1/4 OF THE SE 1/4 BEING S 89°41'49" W.
2. PURPOSE OF THIS SURVEY IS TO SHOW THE RELATIONSHIP BETWEEN THE MONUMENTATION AND THE MONITORING WELLS.
3. TIES SHOWN TO MONITORING WELLS ARE AT RIGHT ANGLES TO MONUMENTED LINES.
4. ELEVATIONS SHOWN HEREON BASED ON NATIONAL GEODETIC VERTICAL DATUM 1929.
5. PRIMARY BENCHMARK: UNITED STATES COAST & GEODETIC SURVEY BENCHMARK Y-56 ELEVATION 61.54'.

LEGEND:

⊗ = MONITORING WELL

RECEIVED
SEP 9 0 1993
Department of Environmental Protection
BY SOUTHWEST DISTRICT

THIS IS TO CERTIFY THAT THE SPECIFIC PURPOSE SURVEY SHOWN HEREON WAS PREPARED UNDER MY DIRECT SUPERVISION AND MEETS THE MINIMUM TECHNICAL STANDARDS AS SET FORTH BY THE FLORIDA BOARD OF PROFESSIONAL LAND SURVEYORS IN CHAPTER 61G17-6 OF THE FLORIDA ADMINISTRATIVE CODE, PURSUANT TO SECTION 472.027, FLORIDA STATUTES. THE SKETCHES SHOWN HEREON ARE A TRUE AND CORRECT REPRESENTATION TO THE BEST OF MY KNOWLEDGE.

9/23/93

PATRICK M. KELLEY, FLORIDA REGISTERED LAND SURVEYOR

NOT VALID WITHOUT ORIGINAL SIGNATURE AND EMBOSSED WITH SURVEYORS SEAL.

SPRINGSTEAD ENGINEERING, INC.
CONSULTING ENGINEERS – PLANNERS – SURVEYORS
727 S. 14TH STREET
LEESBURG, FL 34748-5618
(904) 787-1414

MONITORING WELL LOCATIONS
SUMTER COUNTY LANDFILL
SUMTER COUNTY, FLORIDA
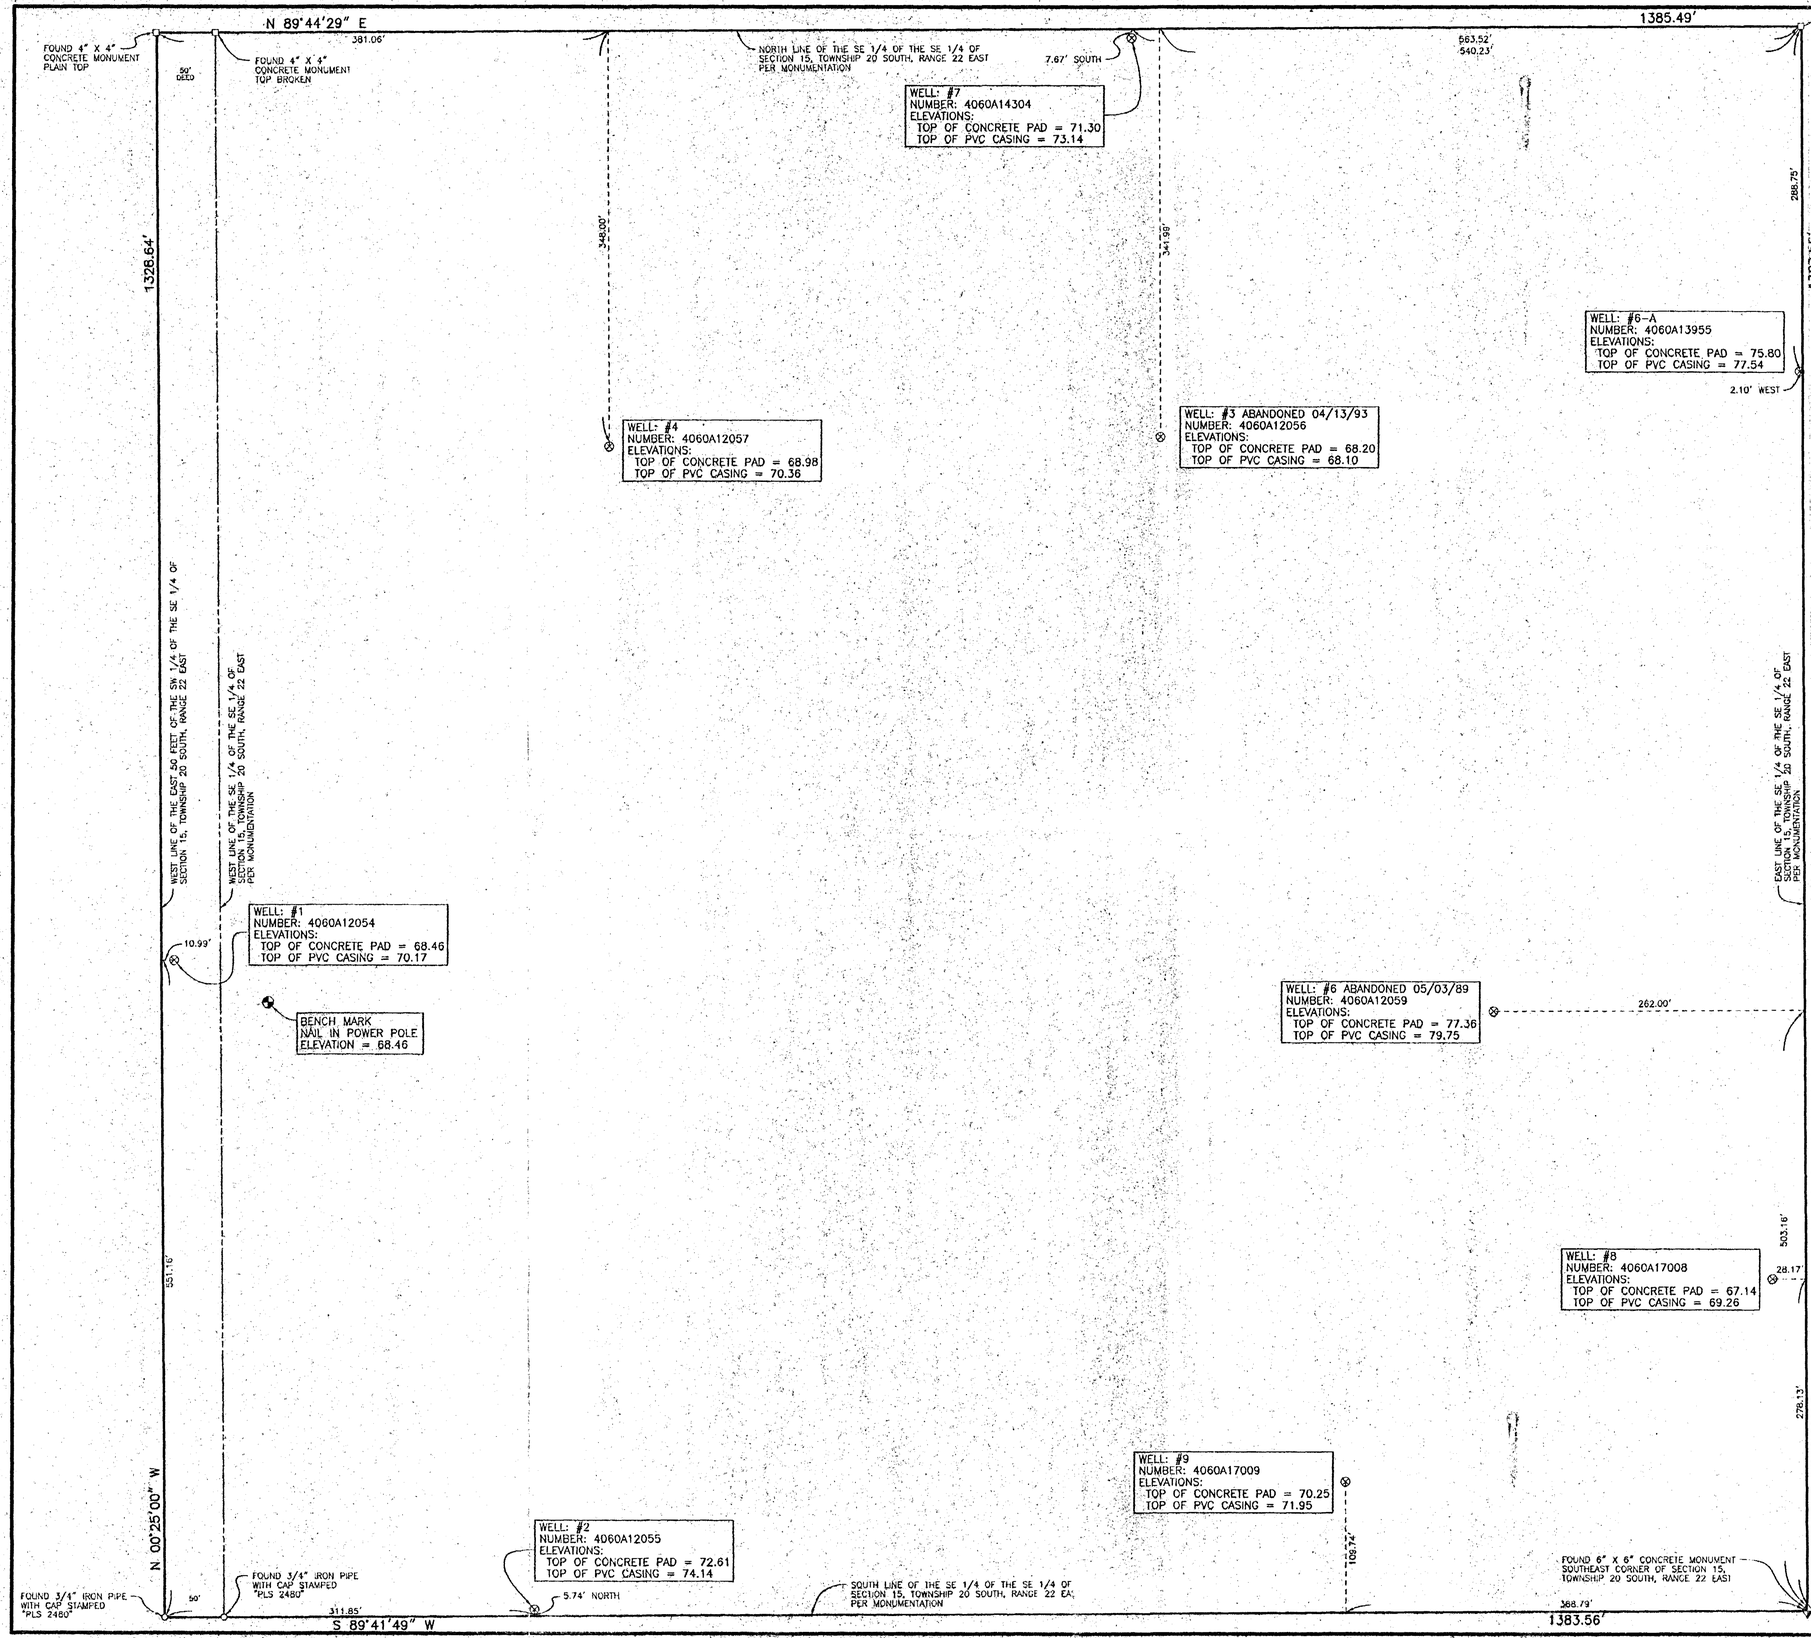
Drawn By: RL	Job No.: 921770.00
Date Drawn: 09/13/93	Sec. 15 Twp. 20E Rge. 22S
Date of Survey: 04/06/93	File No.: D-0214
Checked By: PMK	SHEET: 1 OF: 1