

From: [Rick Potts](#)
To: [Morris, John R.](#)
Cc: "[Cottrell, Scott](#)"; "[Jackson, Jackey](#)"; "[Segrest, Becky](#)"
Subject: Sumter County Closed Landfill Permit Modification
Date: Friday, December 13, 2013 4:30:40 PM
Attachments: [SumterCoLF.ZODSiteMap.Rev1.pdf](#)

John,


Attached please find a revised Fig. 1 showing well locations and the modified ZOD for the landfill. Revisions include:

- Changes to identifiers for the old drainfields to more clearly reflect that they have been excavated and removed, and;
- Correct identification of the new Animal Services and CDA Offices building in the northwest part of the site.

Please use this drawing to replace the previous submittal.

Thanks for all of your assistance,

Richard L. Potts, Jr. P.G.
Principal Hydrogeologist
THE COLINAS GROUP, INC.
Water Resources Consultants
377 Maitland Avenue
Suite 2012
Altamonte Springs, FL 32701
Office: (407) 622-8176
Cell: (407) 620-5779
email: rickpotts@cfl.rr.com

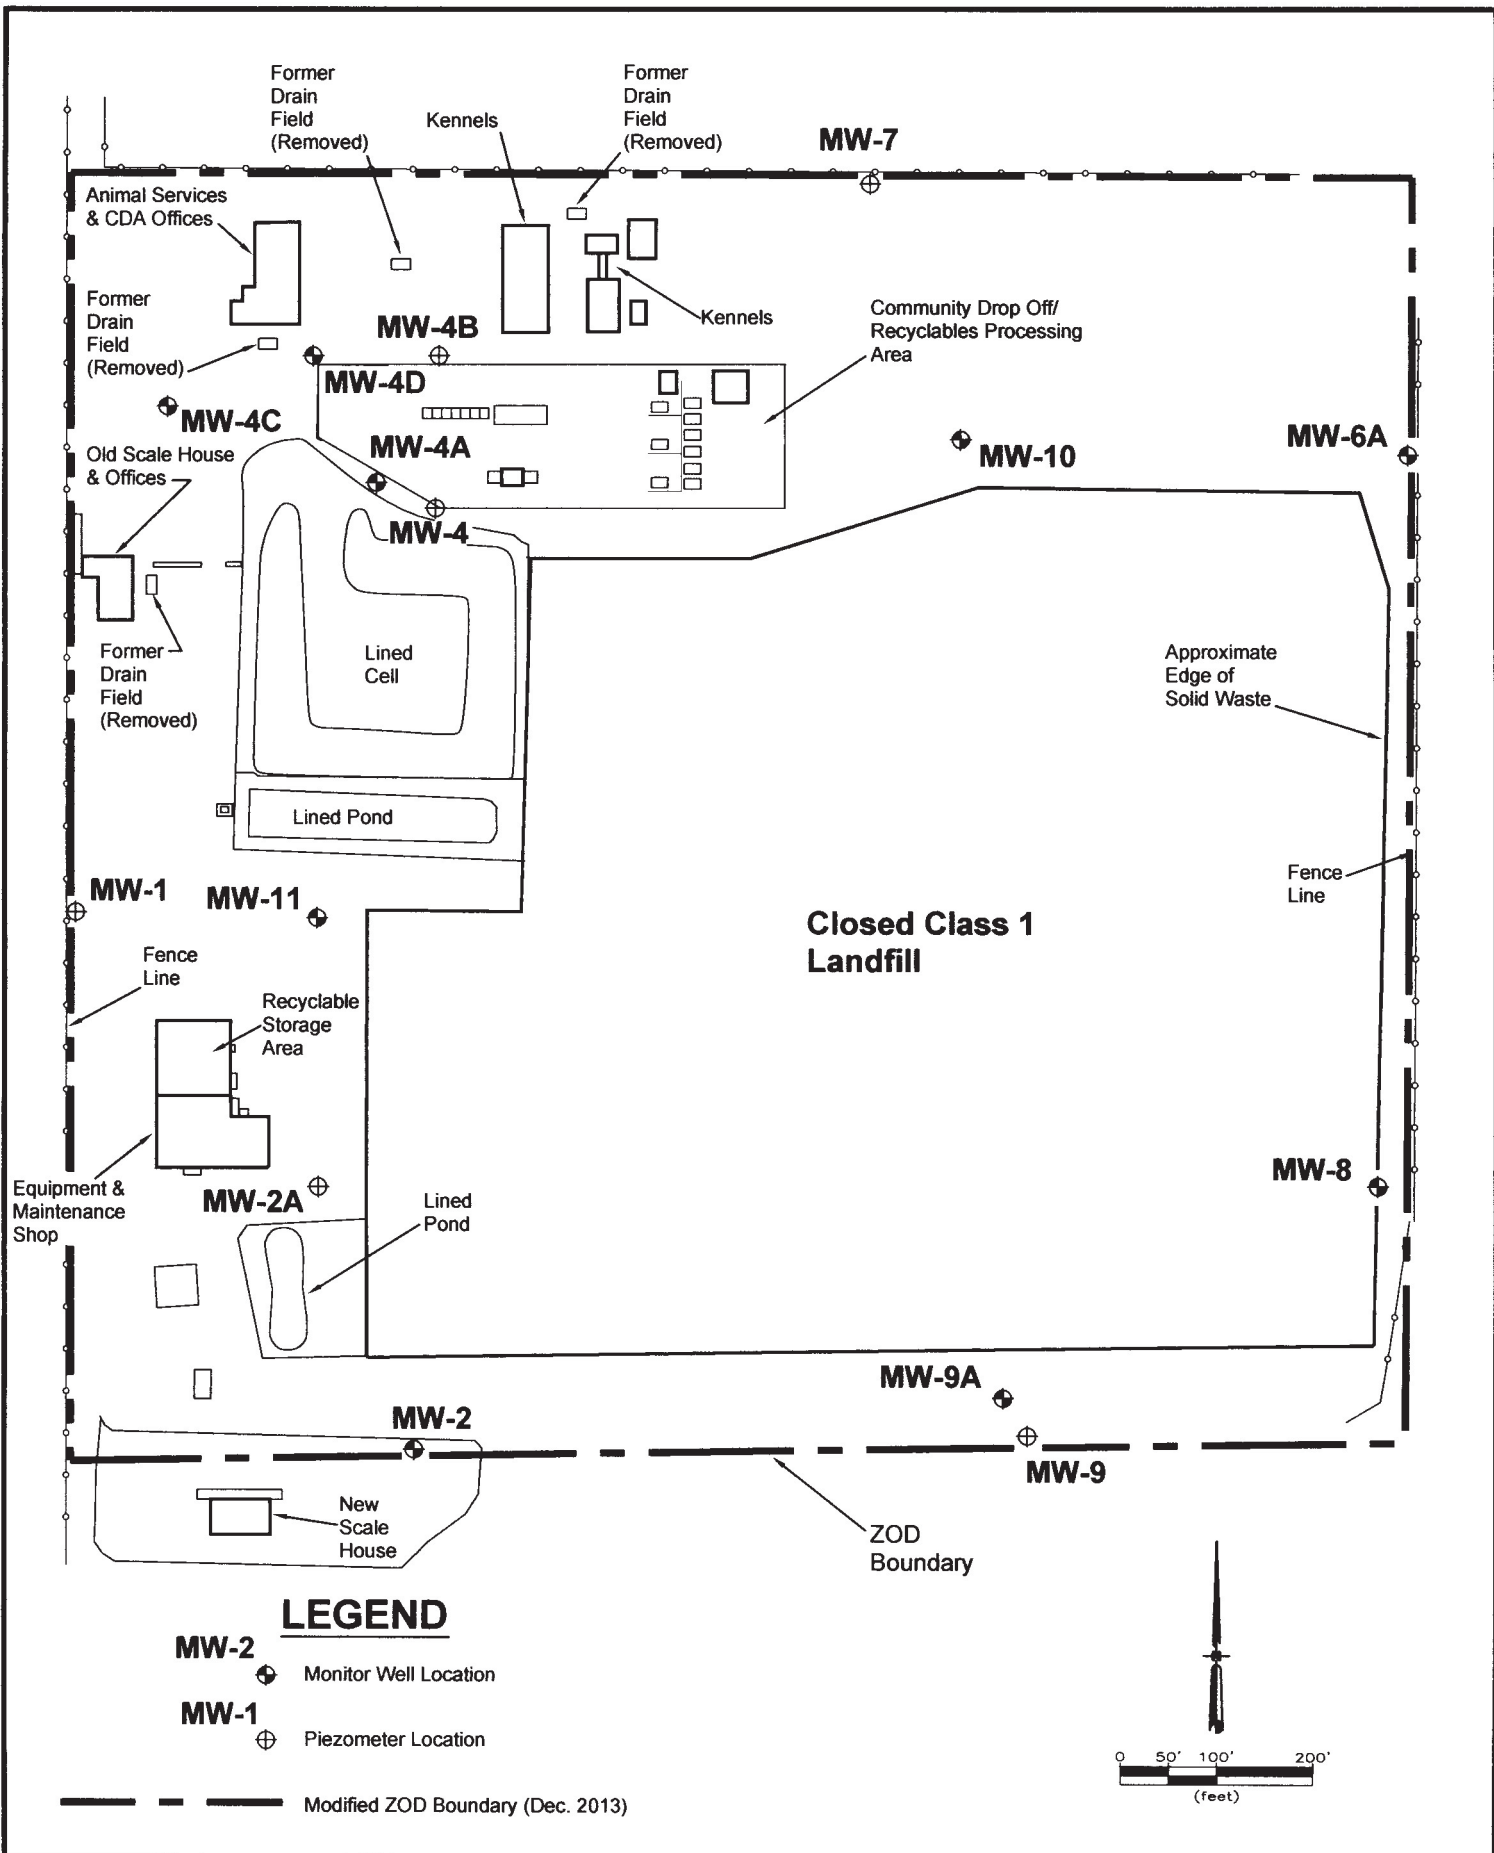

The Colinas Group, Inc.
 377 Maitland Avenue
 Suite 2012
 Altamonte Springs, Florida 32701

PROJ. NO.: P-483
 DATE: DECEMBER 2013
 SCALE: 1" = 200'

**MONITORING WELL LOCATIONS AND
 MODIFIED ZONE OF DISCHARGE BOUNDARY
 SUMTER COUNTY CLOSED LANDFILL**

FIGURE 1