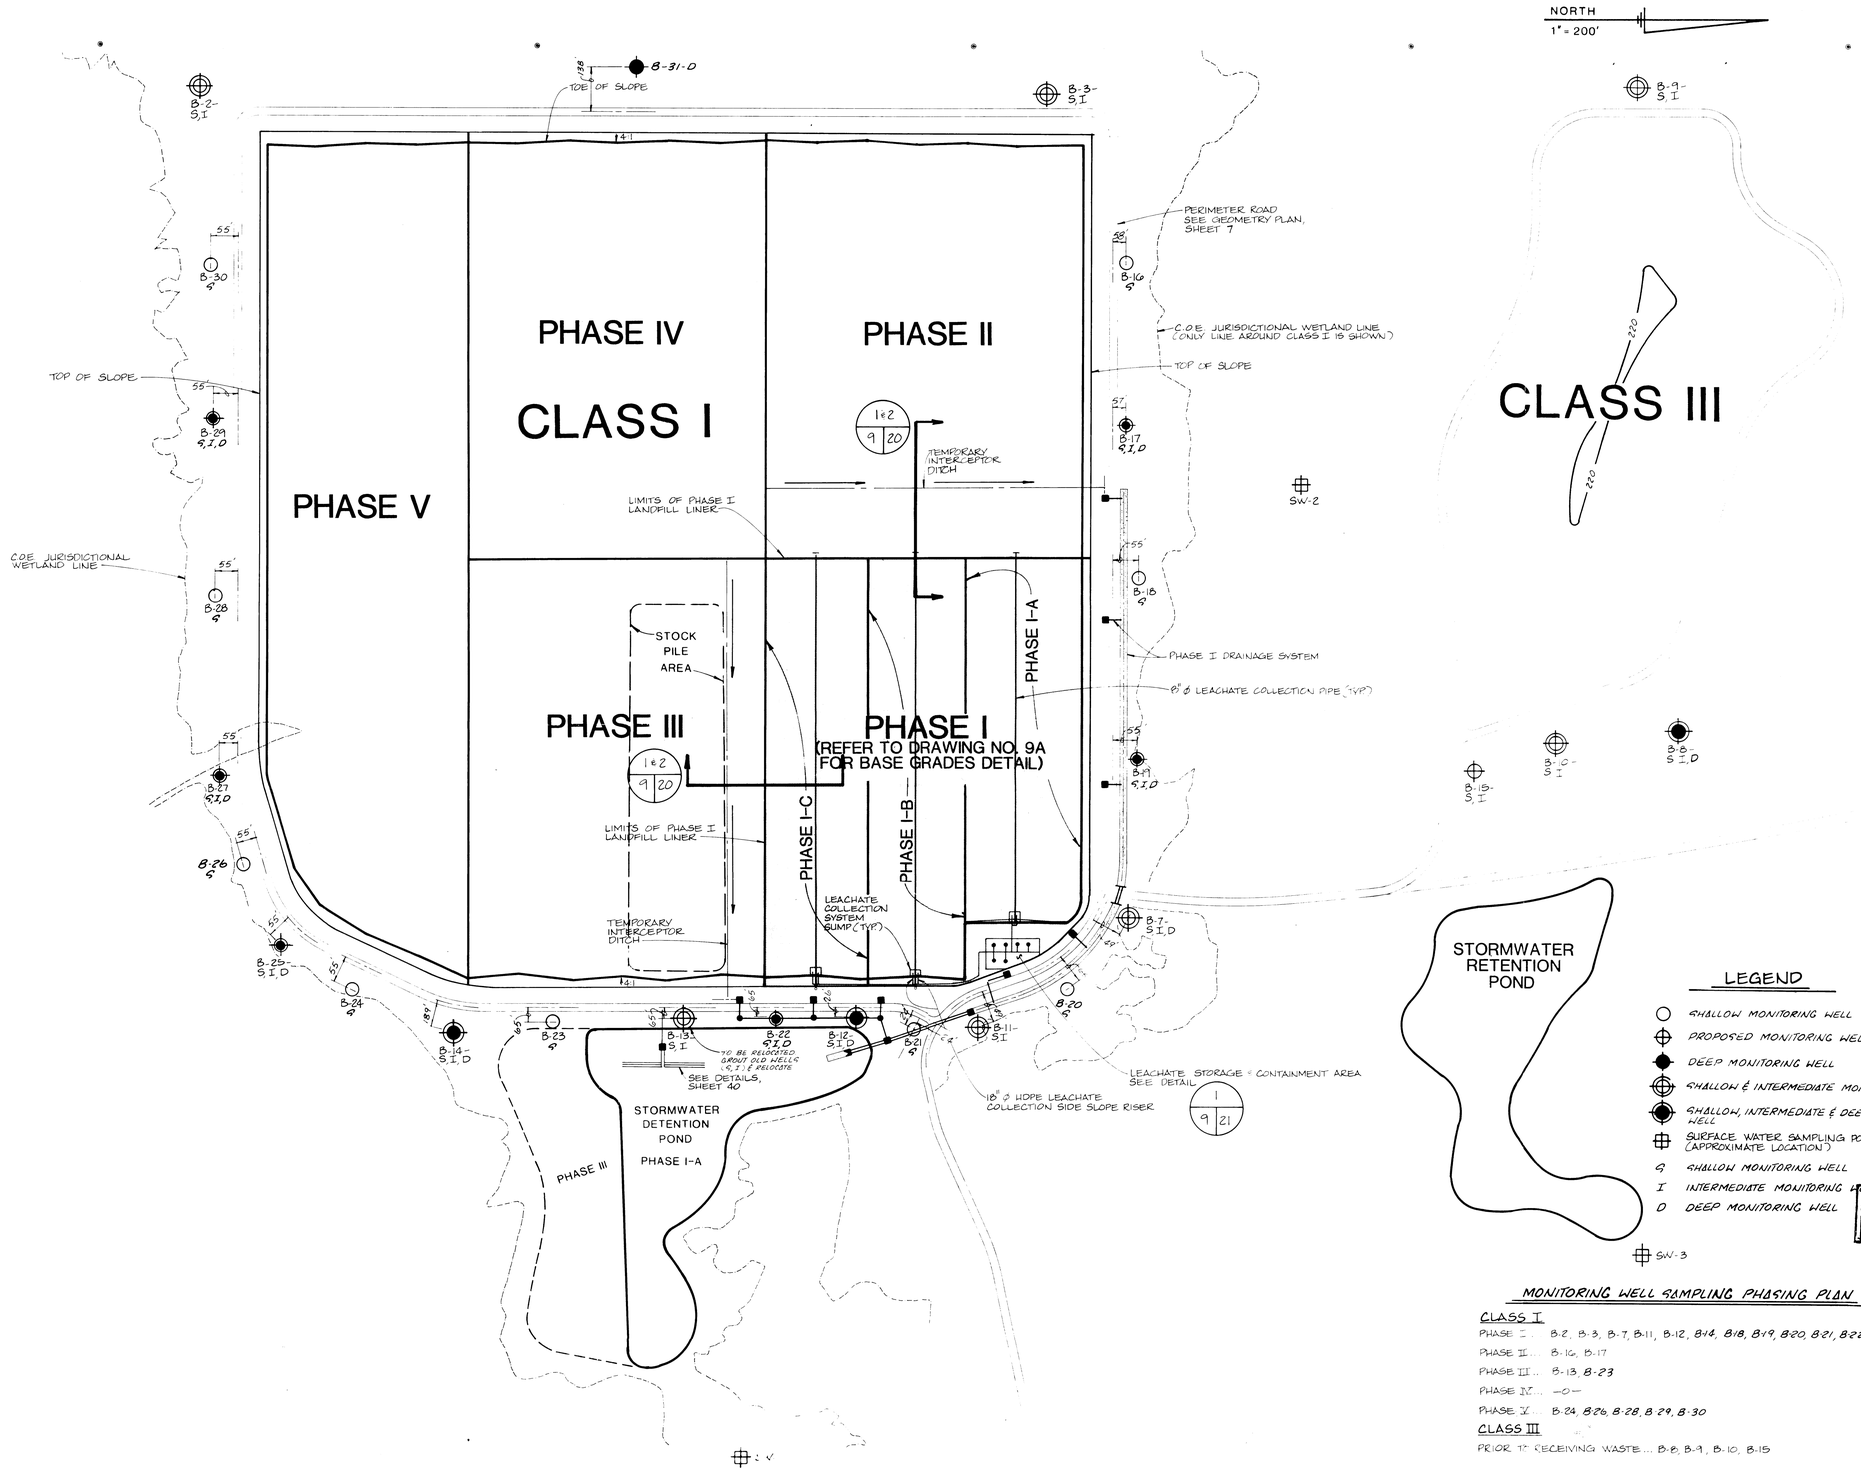

LEGEND

- ○ SHALLOW MONITORING WELL
- ⊕ PROPOSED MONITORING WELL
- ● DEEP MONITORING WELL
- ⊕ SHALLOW & INTERMEDIATE MONITORING WELL
- ● SHALLOW, INTERMEDIATE & DEEP MONITORING WELL
- ⊞ SURFACE WATER SAMPLING POINTS (APPROXIMATE LOCATION)
- S SHALLOW MONITORING WELL
- I INTERMEDIATE MONITORING WELL
- D DEEP MONITORING WELL

NORTHEAST DISTRICT
RECEIVED
JAN 15 1992
DER-JACKSONVILLE

MONITORING WELL SAMPLING PHASING PLAN

CLASS I

PHASE I ... B-2, B-3, B-7, B-11, B-12, B-14, B-18, B-19, B-20, B-21, B-22, B-25, B-27, B-31

PHASE II ... B-16, B-17

PHASE III ... B-13, B-23

PHASE IV ... —0—

PHASE V ... B-24, B-26, B-28, B-29, B-30

CLASS III

PRIOR TO RECEIVING WASTE ... B-8, B-9, B-10, B-15

FOR REVIEW AND NOT FOR CONSTRUCTION

1-13-91 CONTRACT DOCUMENTS	
12-19-91 BID SET	
12-19-91 REVISED TO SHOW PHASE I-A, I-B & I-C	
2-19-91 PROVIDED PHASING OF STORMWATER MANAGEMENT SYSTEM	
1-14-92 KEY MONITORING WELL LOCATIONS & PHASING PER DER PERMIT COND. No. 38	

E89/139	
T.L.D.	
S.J.W.	
JULY 23, 1990	

BOTTOM LINER PHASING PLAN

TRAIL RIDGE LANDFILL (PLAN A)

England-Thims & Miller, Inc.
Consulting & Design Engineers

DRAWING NO.

9