



11x17.Density Grid.dwg

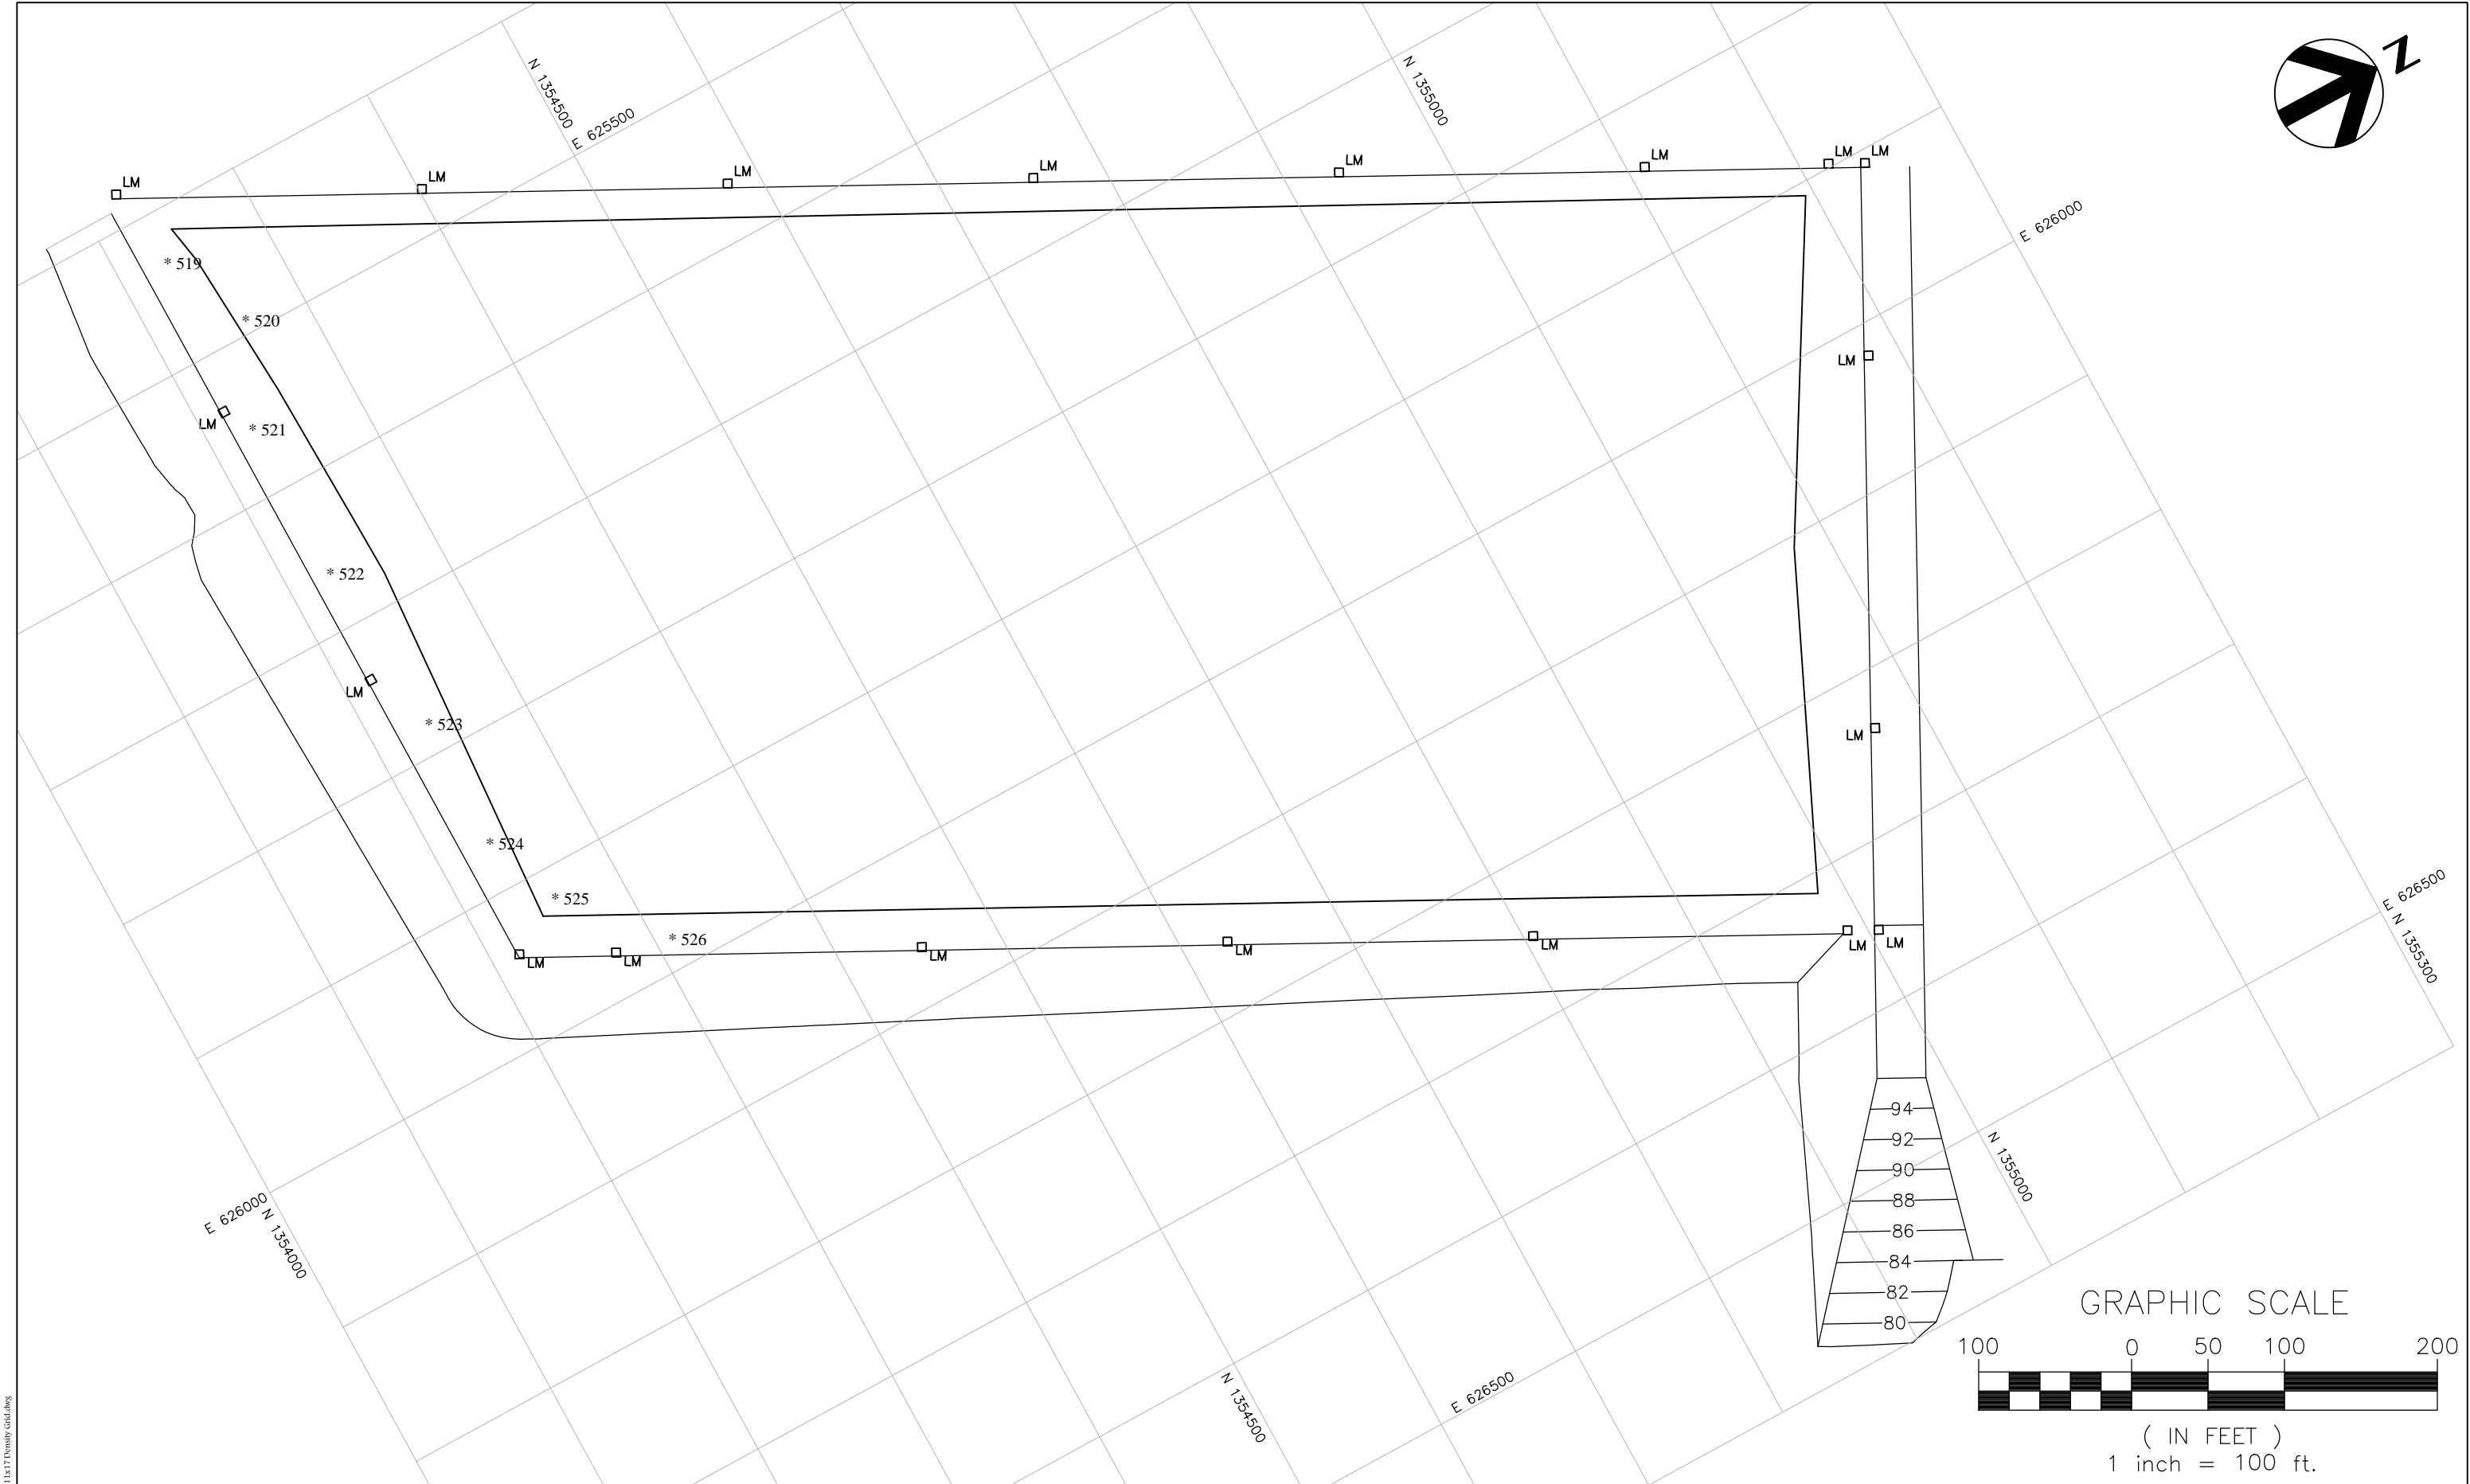

<div><div>Brantley Engineering, LLC</div></div>						PROJECT MANAGER:	A. BRANTLEY, PE	JED SOLID WASTE MANAGEMENT FACILITY CELL 10 CONSTRUCTION	LIFT 14	MOISTURE/DENSITY TEST LOCATIONS FOR SUBGRADE	LIFT 14
						DESIGNED BY:	A. BRANTLEY, PE				
						QC'ED BY:	S. NEJAD, PE				
						DRAWN BY:	A. BRANTLEY, PE				
0	3/5/14	BRANTLEY ENGINEERING, LLC.	INITIAL ISSUE								
ISSUE	DATE	RESPONSIBLE ENG.	DESCRIPTION			PROJECT NUMBER	1014-101				