



Department of Environmental Protection


Central District
3319 Maguire Boulevard, Suite 232
Orlando, Florida 32803-3767

Friends Recycling WACS I.D. 21012
Facility name

Permitting – Minor Modification & *Odor Remediation Plan.*
Type of meeting

August 20, 2014
Date

NAME	AFFILIATION	PHONE w/ area code	E-MAIL
Tom Lubozynski, P.E.	DEP – Orlando	407/897-4100	Tom.Lubozynski@dep.state.fl.us
Laxsamee Levin	DEP - Orlando	407/897-4313	Laxsamee.Levin@dep.state.fl.us
Gloria-Jean Depradine	DEP - Orlando	407/897-4312	GloriaJean.Depradine@dep.state.fl.us <i>JDS</i>
<i>JERRY LOURINHO</i>	<i>FRIENDS RECYCLING</i>	<i>(352) 266-9497</i>	<i>AWS97@AOL.COM</i>
<i>JUAN C GUERRA</i>	<i>GDC</i>	<i>352 629 8060</i>	<i>JCG@GUERRACORP.NET</i>
<i>NICK GUINNELL</i>	<i>FRIENDS RECYCLING</i>	<i>312 266-4853</i>	<i>FRIENDS2350@GMAIL.COM</i>
<i>Reggie Phillips</i>	<i>FDEP - Orlando</i>	<i>407-897-4132</i>	<i>reggie.phillips@dep.state.fl.us</i>

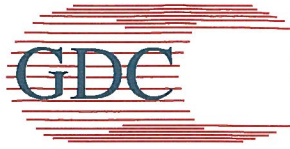

Guerra Development Corporation

Civil & Structural Engineering

August 4, 2014

12-03 04.ltr

RECEIVED
AUG 08 2014
DEP Central Dist.

Mr. F. Thomas Lubozynski, P.E.
Waste Program Administrator, Central District, DEP
3319 Maguire Boulevard, Suite 232
Orlando, Florida 32803-3767

**SUBJECT: Friends Recycling, LLC
Marion County - SW WACS #21012
Friends Recycling - C&D Disposal and Recycling**

JN 12-03

Dear Mr. Lubozynski,

Based on our discussions at your Orlando offices on June 18 of 2014, Guerra Development Corporation is submitting, on behalf of Friends Recycling, LLC, a request to receive waste in additional portions of previously approved cells of the subject C & D facility. Our requests are as follow.

1. Yard Waste
 - a. Due to an oversight, the permit application did not include a request to receive yard waste. Per our meeting, **Friends Recycling LLC is hereby requesting authorization to receive yard waste as part of their C & D permit.**
2. Authorization to Receive Waste
 - a. During our 6/18/14 meeting we discussed that a number of potable water wells restricting the type of waste which can be placed at certain areas of the C & D facility are no longer applicable. A revised Wells Map has been prepared and included herewith.
 - b. The revised Wells Map includes an adjusted shaded area indicating areas of the facility which can only receive clean waste (as defined in the permit conditions). For your reference, I have also included a line indicating where the old boundary for the restricted area was located.
 - c. Friends Recycling LLC is hereby requesting authorization to place unrestricted C&D waste in areas previously approved plus the east 40 feet of Cell # 2B, as shown in the enclosed drawings as a 40' offset. Although a larger area is available for unrestricted C&D waste within Cell #2B, for simplicity's sake and to make it easier for field personnel to ensure that the proper types of waste are being placed as permitted, a straight line offset was made 40 feet into Cell #2B.

August 4, 2014

12-03 04.ltr

Mr. F. Thomas Lubozynski, P.E.

**SUBJECT: Friends Recycling, LLC
Marion County - SW WACS #21012
Friends Recycling - C&D Disposal and Recycling**

JN 12-03

- d. The shown updated topography is based on a topographic survey prepared by Rogers Engineering Inc., dated 6/24/14. The topo shows that areas without waste have been graded to the 64' elevation specified in the permit conditions and are ready to receive waste.
- e. **Friends Recycling LLC is hereby requesting authorization to accept and place waste in Cells #2A, #2B with the restrictions discussed in this letter. Namely, Cell #2B to receive clean fill, except the east 40' which can receive unrestricted C&D waste; Cell#2A to receive unrestricted C&D waste.**

If you have any questions please feel free to contact me at (352) 629-8060 or via email at jcg@guerracorp.net.

Sincerely,



Juan C. Guerra, P.E.

President

Guerra Development Corporation


Phone: (352) 629-8060 Ph

email: jcg@guerracorp.net

copies to: Mr. Nick Giumarelli
Mr. Jerry Lourenco

enclosures: Certified Wells Map
Certified Cell Preparation Topo


RECEIVED
AUG 08 2014
DEP Central Dist.

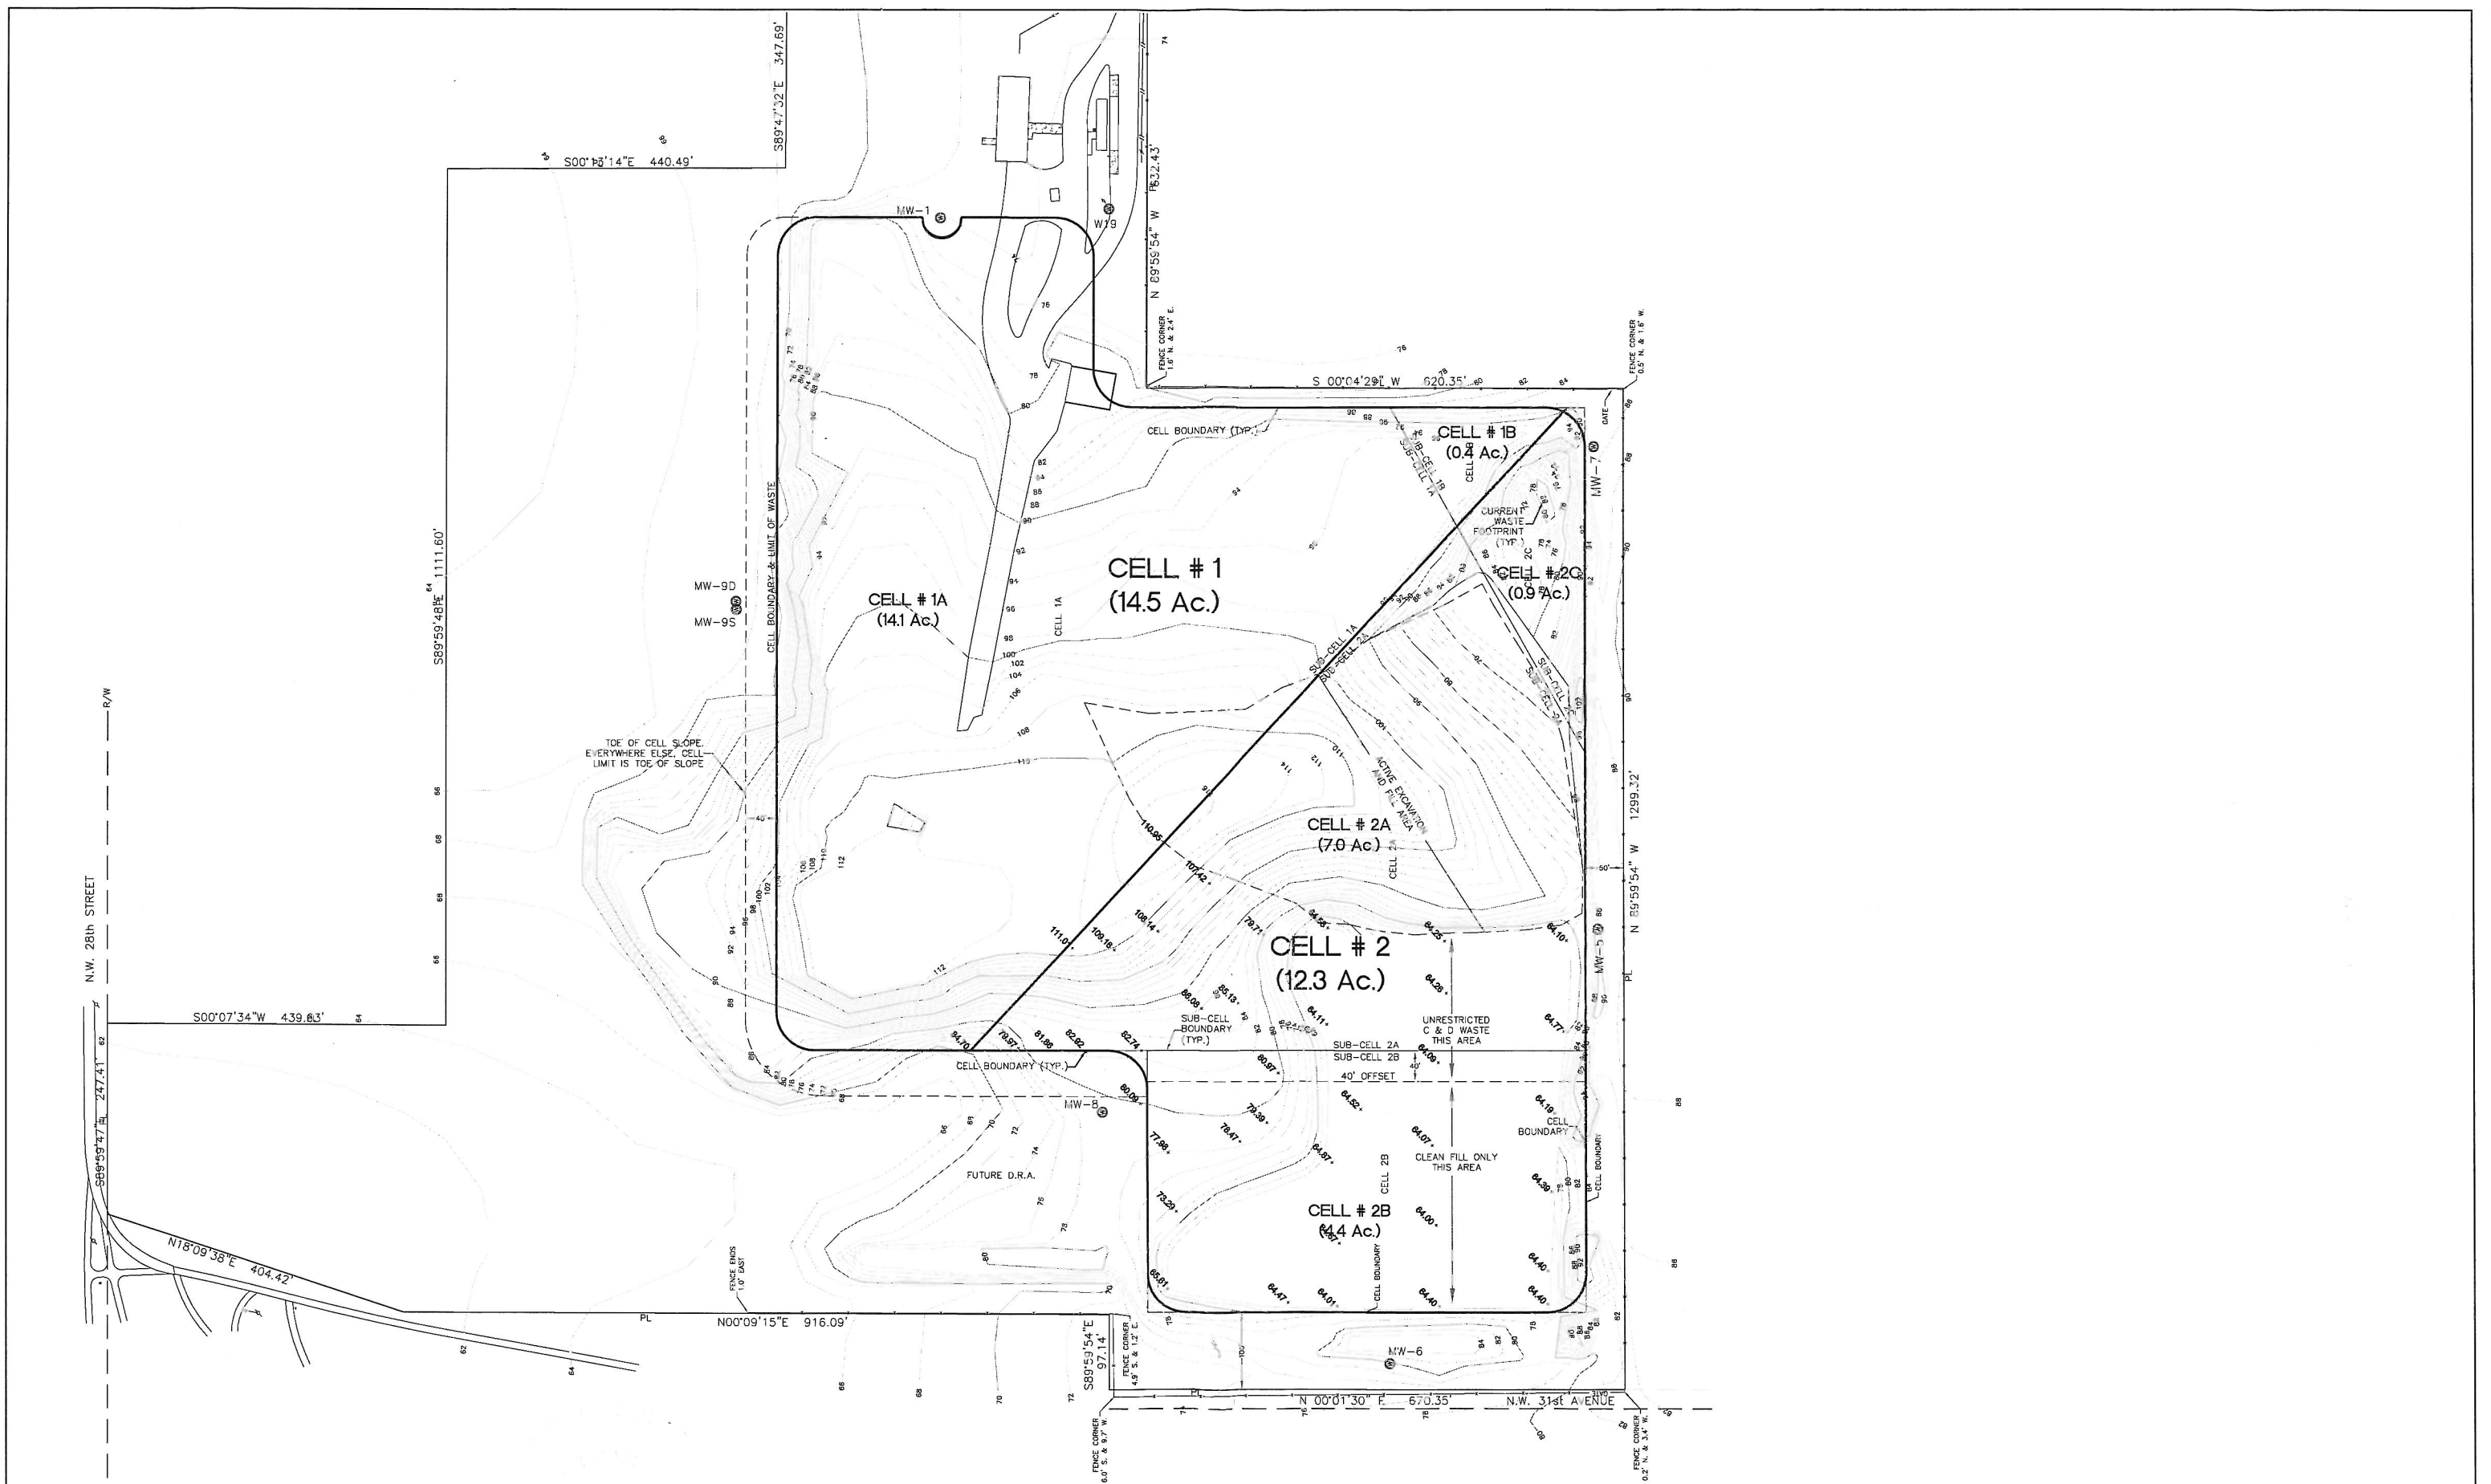

REVISIONS	
Date	Description

Drawn By	Names	Date
JCG	JCG	30 JUL 14
Checked By	JCG	
Designed By		
Checked By	JCG	
Approved By	JCG	

SEAL:
 Juan C. Guerra, P.E.
 Fla. Reg. # 0041000
 Date: 8.5.14

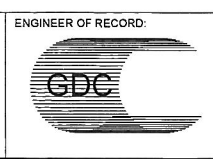


Guerra Development Corp.
 Consulting Engineering
 2817 NE 3rd St. - Ocala, Florida 34470
 (352) 629-8060 Phone
 State of Florida Certificate of Authorization No. 4954

HORIZ. SCALE: 1" = 50'
 VERT. SCALE: 1" = 25'



CLIENT: **FRIENDS RECYCLING, LLC**

SHEET TITLE: CELL PREPARATION TOPO	GDC DRAWING NAME: 12-03_WELLS-2
PROJECT NAME: FRIENDS RECYCLING RENEWAL	M.C. JOB NO: 12-03
SHEET NO. 1 of 2	

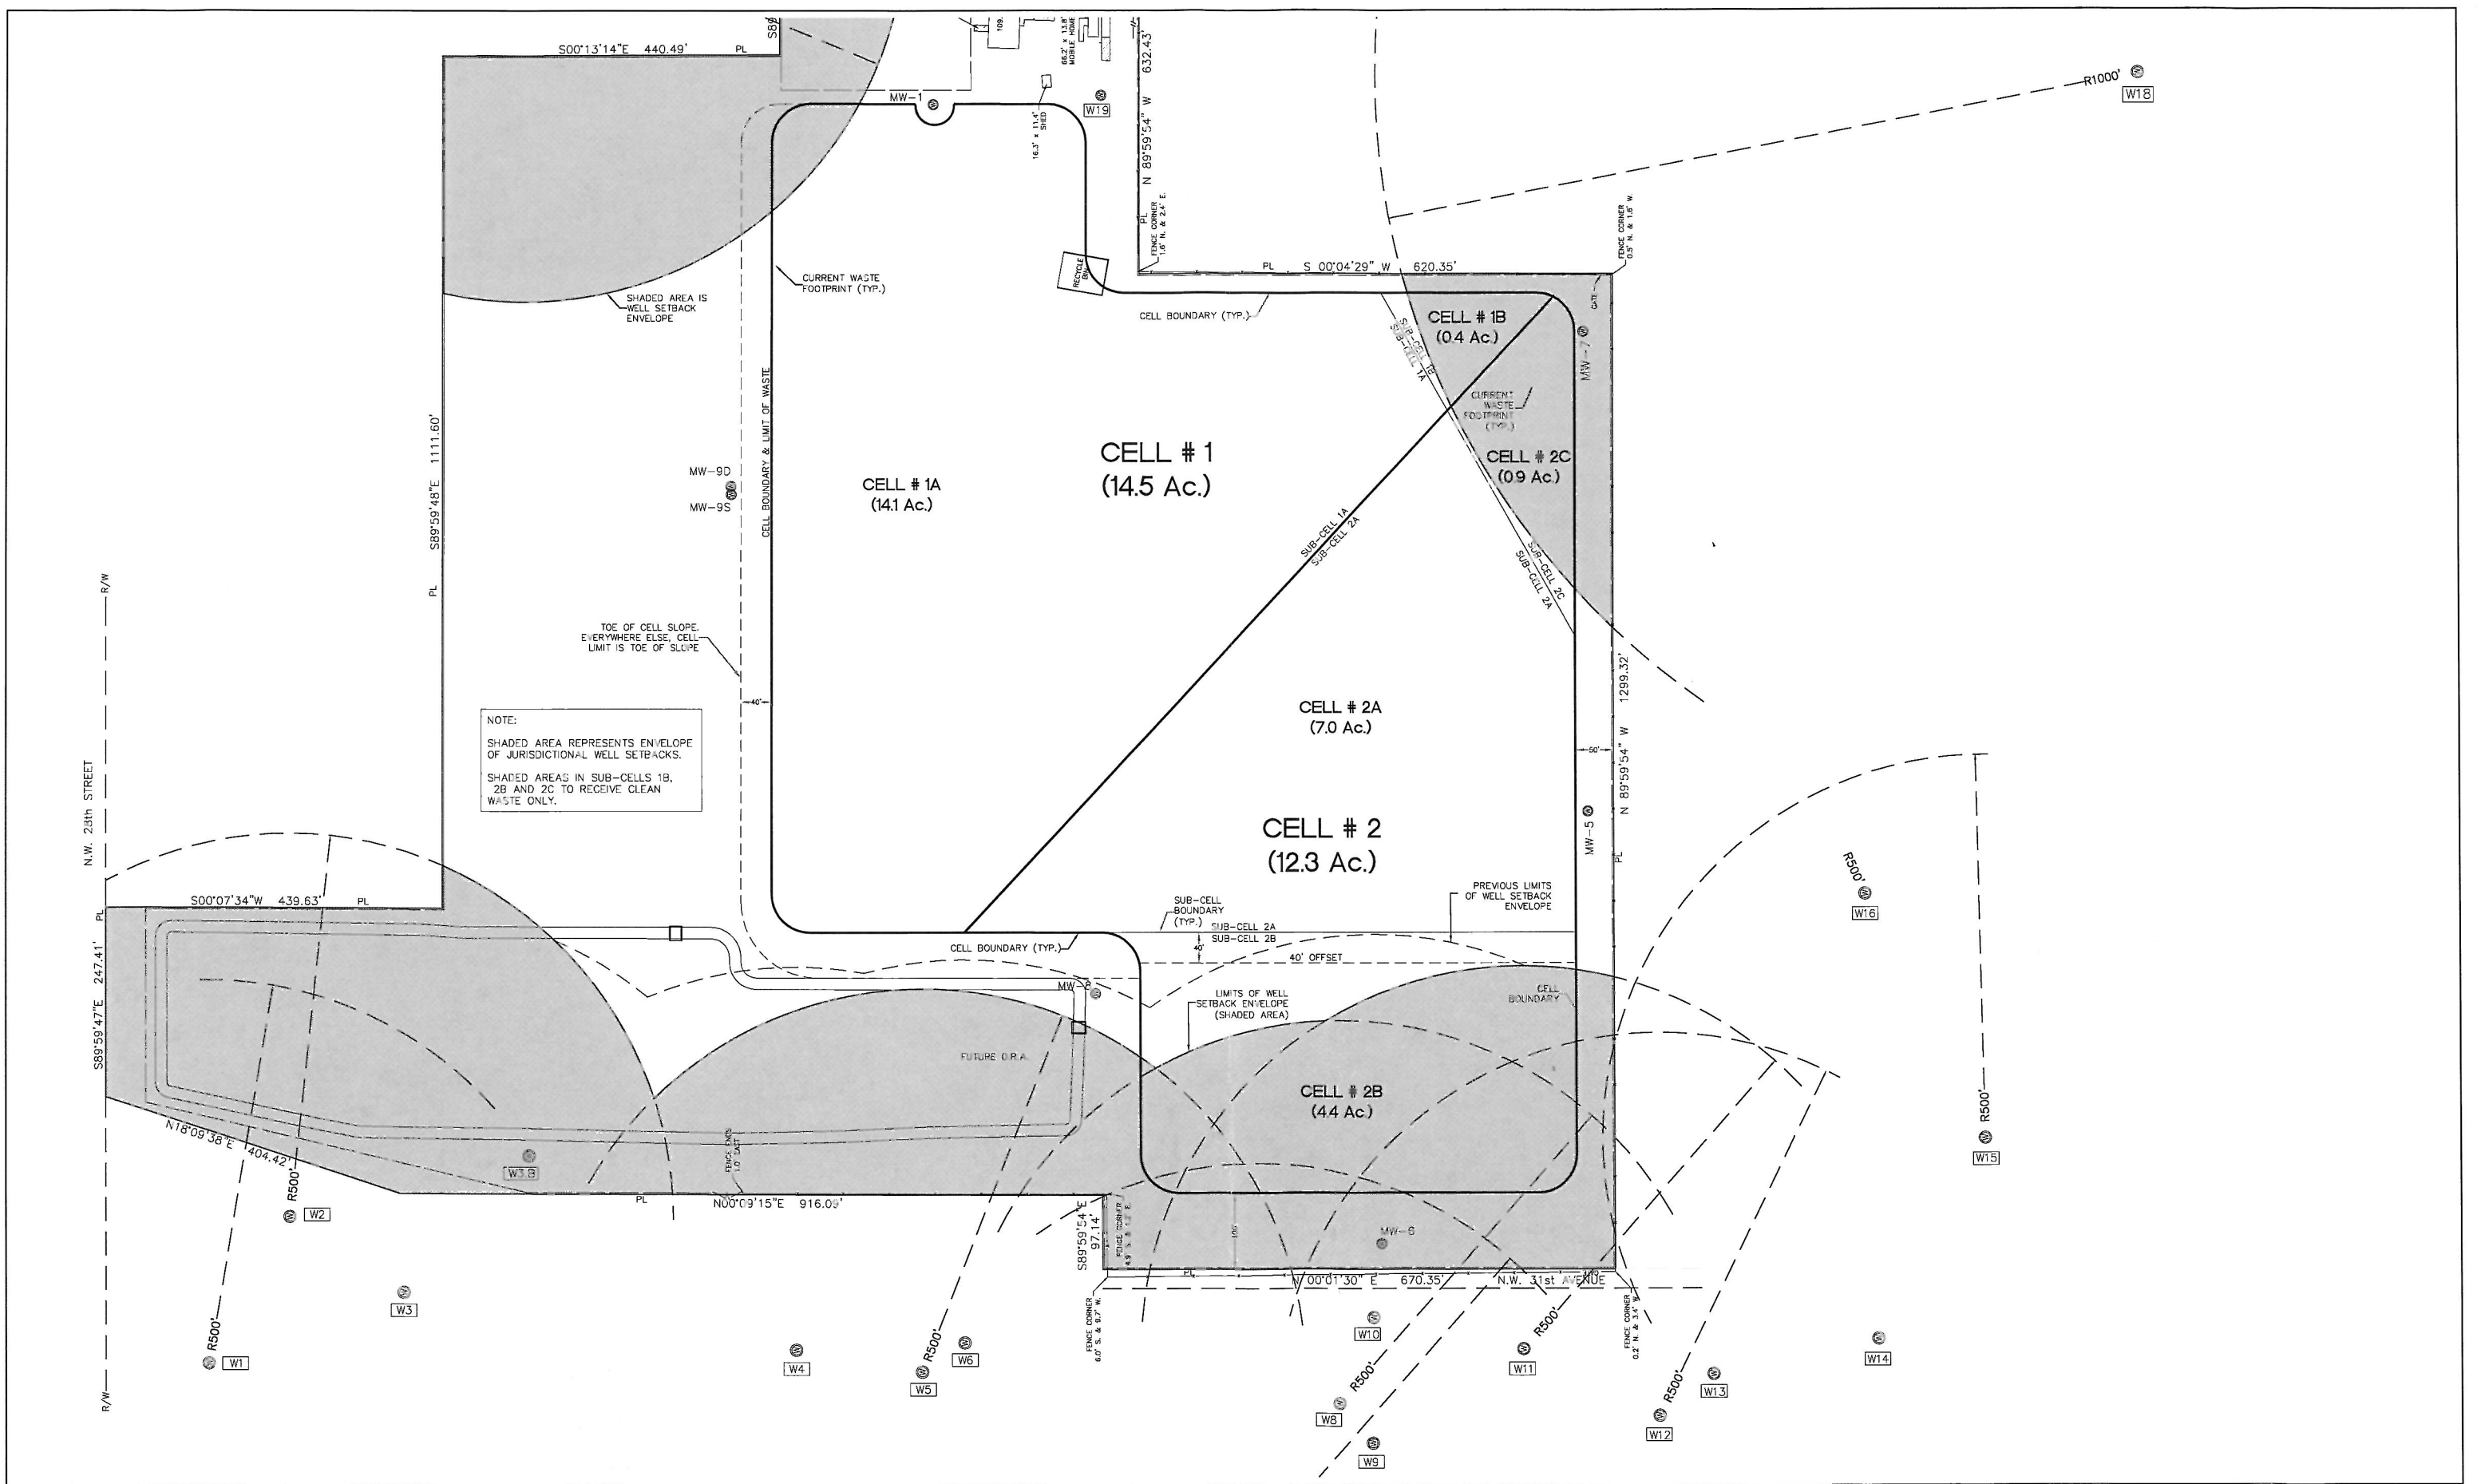

Date	By	Description

SEAL:

ENGINEER OF RECORD:
Guerra Development Corp.
 Consulting Engineering
 2817 NE 3rd St. - Ocala, Florida 34470
 (352) 629-8080 Phone
 State of Florida Certificate of Authorization No. 4854

GDC

HORIZ. SCALE: 1" = 50'
 VERT. SCALE: 1" = 25'

NORTH

CLIENT: **FRIENDS RECYCLING, LLC**

SHEET TITLE: WELLS MAP - JULY 2014	GDC DRAWING NAME: 12-03_WELLS-2
PROJECT NAME: FRIENDS RECYCLING RENEWAL	M.C. JOB NO.: 12-03
	SHEET NO.: 2 of 2