G:\PROJECT\09199056.13\OpsPermitRenewal\DHR095613SITE.dwg Dec 14, 2004 - 3:37pm Layout Name: Layout1 (3) By: 2569gav

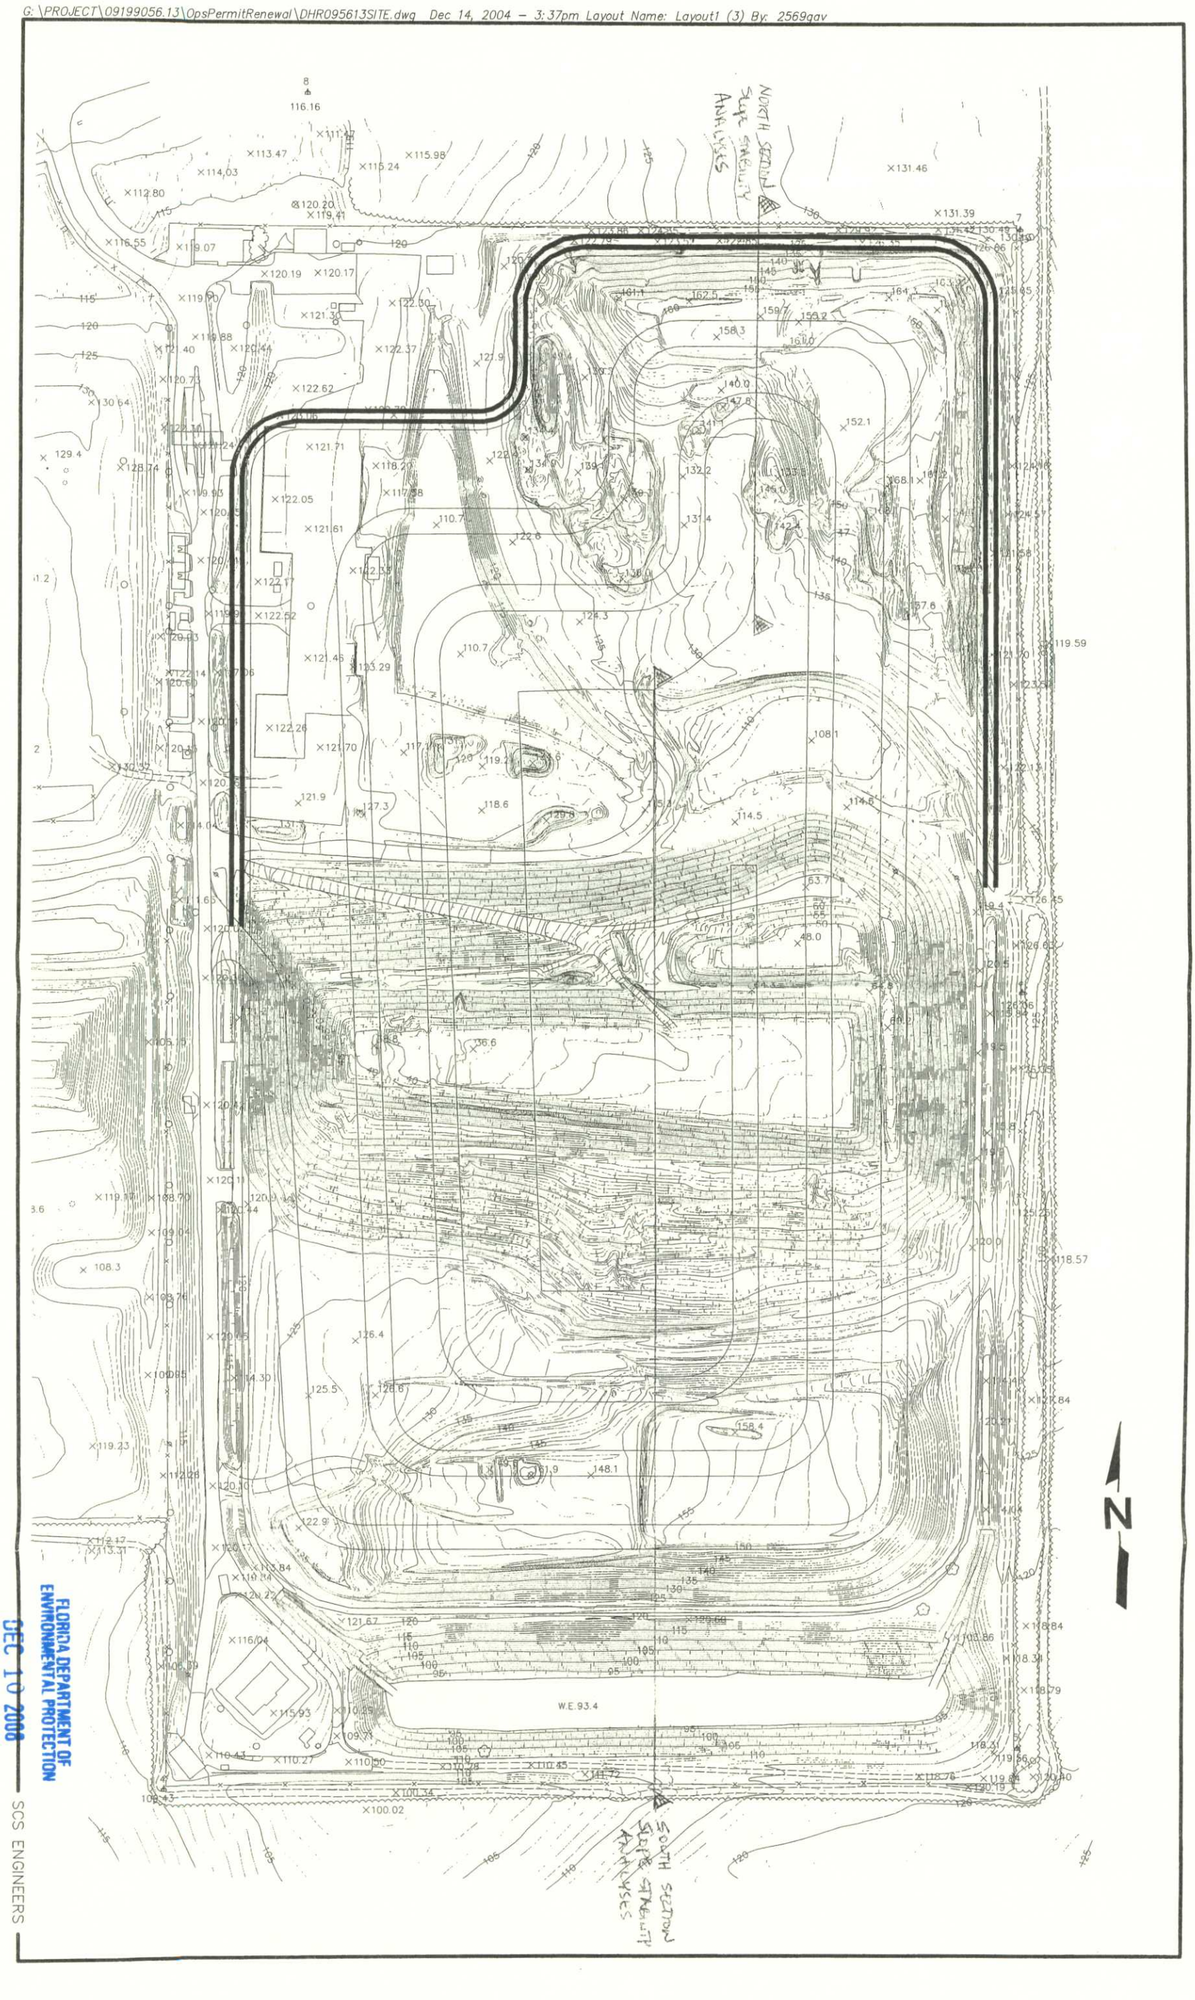


Figure 1. Site Plan Citrus County, Florida

FLORIDA DEPARTMENT OF ENVIRONMENTAL PROTECTION
DEC 10 2004
SOUTHWEST DISTRICT TAMPA

SCS ENGINEERS