
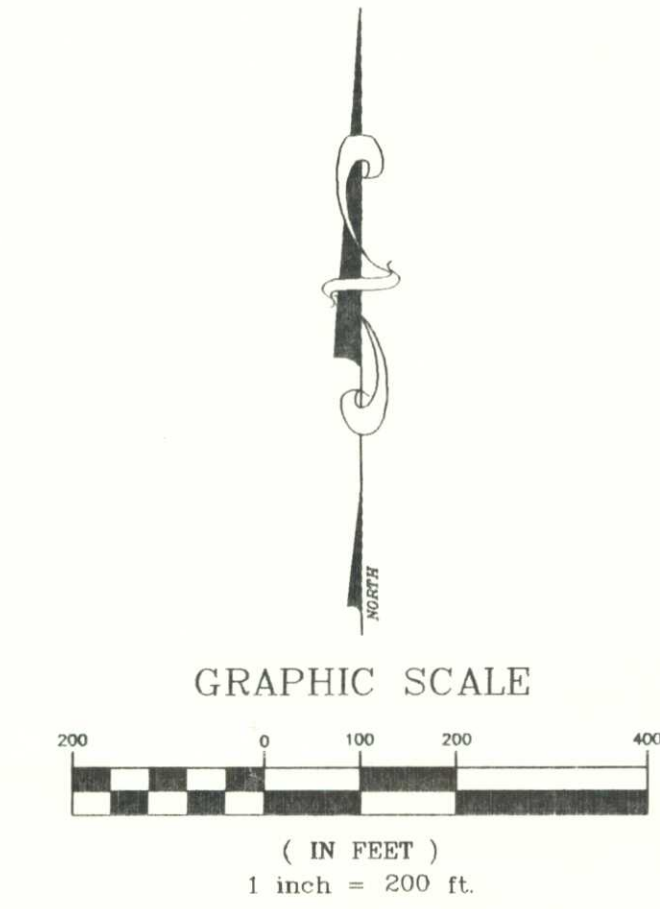


# ENTERPRISE ROAD RECYCLING AND DISPOSAL FACILITY MONITORING WELL LOCATIONS

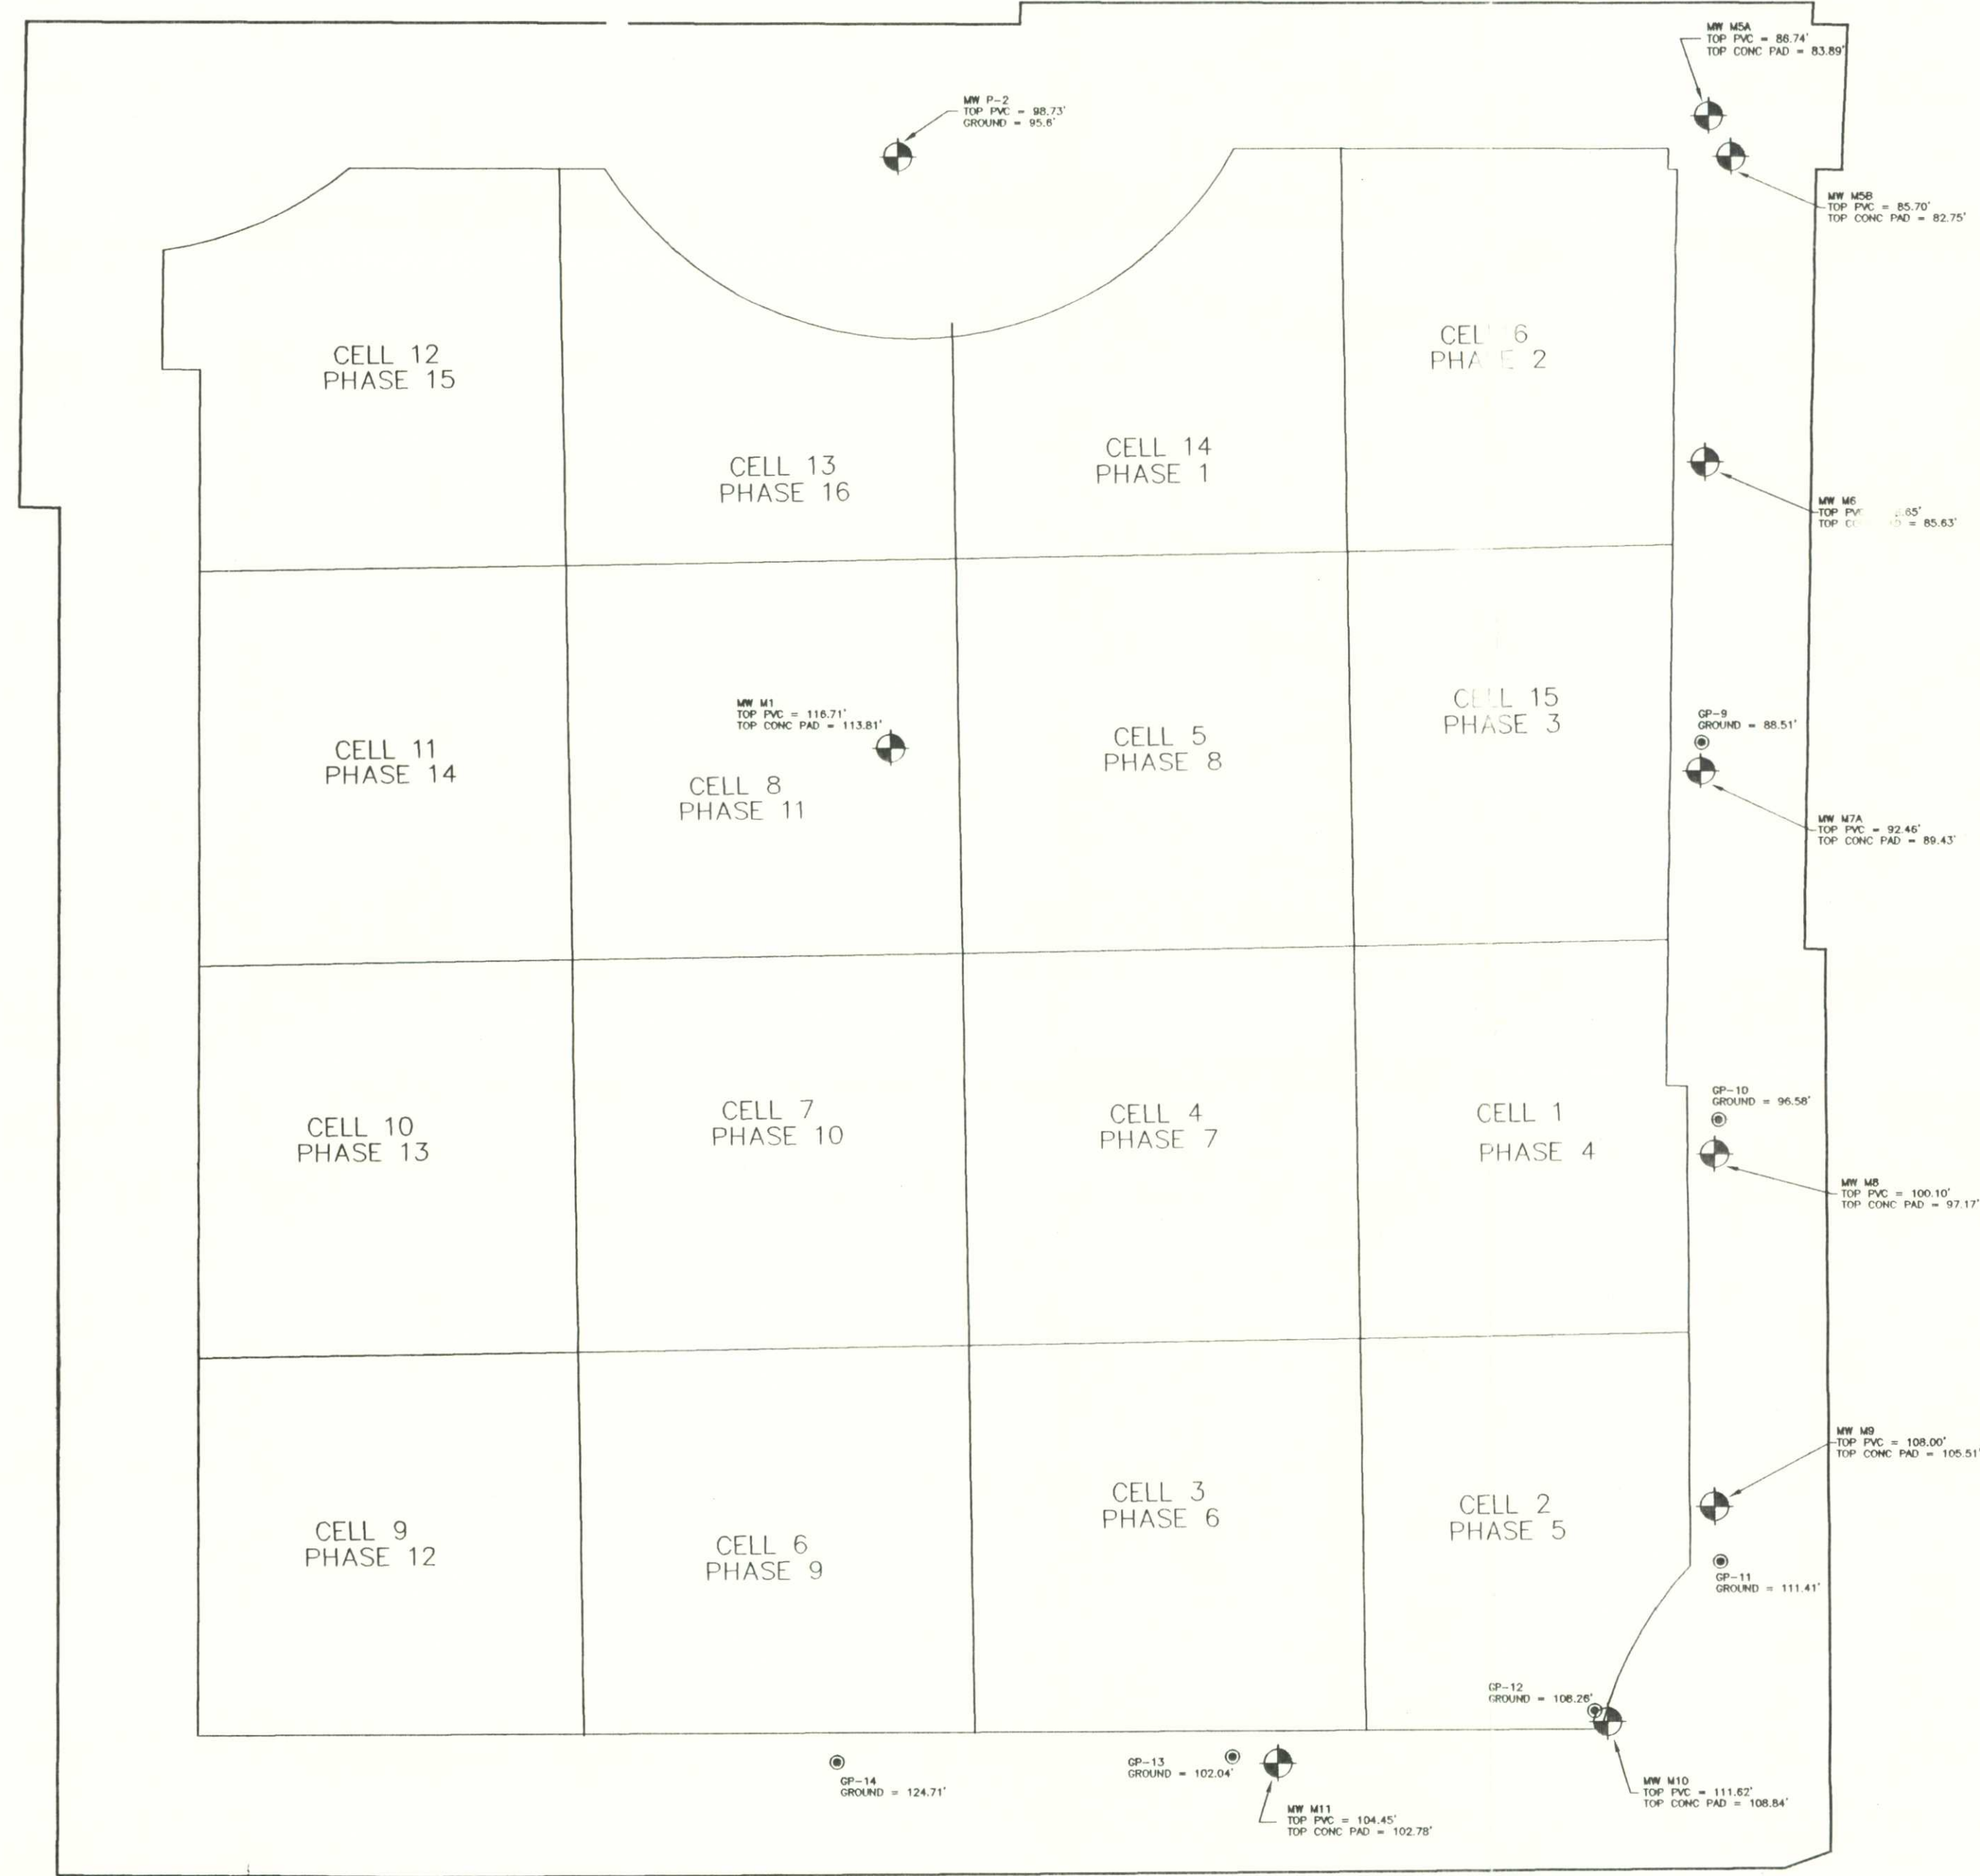

**NOTES:**

1. THIS DRAWING IS NOT INTENDED TO REPRESENT A BOUNDARY SURVEY.
2. ELEVATIONS SHOWN HEREON BASED ON BENCH MARKS OBTAINED FROM THE CONSTRUCTION PLANS FOR THE PROPOSED RECYCLING AND DISPOSAL AND ENTERPRISE ROAD.
3. THIS SURVEY DRAWING WAS PREPARED FOR THE EXCLUSIVE USE OF THE PARTY OR PARTIES CERTIFIED TO BELOW FOR THE EXPRESS PURPOSE STATED HEREON AND/OR CONTAINED IN THE CONTRACT BETWEEN FORESIGHT SURVEYORS, INC. AND THE CLIENT FOR THIS PROJECT. COPYING, DISTRIBUTING, AND/OR USING THIS DRAWING, IN WHOLE OR IN PART FOR ANY PURPOSE OTHER THAN ORIGINALLY INTENDED WITHOUT WRITTEN CONSENT FROM FORESIGHT SURVEYORS, INC. IS STRICTLY PROHIBITED, AND RENDERS THE SURVEYOR'S CERTIFICATION, SIGNATURE AND SEAL HEREON NULL AND VOID. ANY QUESTIONS CONCERNING THE CONTENT OR PURPOSE OF THIS DRAWING SHOULD BE DIRECTED TO FORESIGHT SURVEYORS, INC.

= MONITORING WELL LOCATION  
 = GAS PROBE LOCATION



TITLE: **SPECIFIC PURPOSE SURVEY**  
 FOR: HARTMAN AND ASSOCIATES, INC.  
 DESC: SECTION 8, TOWNSHIP 25 SOUTH, RANGE 22 EAST

THIS SURVEY IS NOT VALID WITHOUT THE SIGNATURE AND ORIGINAL RAISED SEAL OF A FLORIDA LICENSED SURVEYOR AND MAPPER.  
  
 A. DANIEL MILLER, P.S.M.  
 FLORIDA SURVEYORS REGISTRATION NO. 6294

NO.	REVISION	DATE	BY

**FORESIGHT SURVEYORS, INC.**  
 HYDROGRAPHIC, LAND & CONSTRUCTION SURVEYING  
 773 PROVIDENCE BOULEVARD, BROOKSVILLE, FLORIDA 34601  
 PH. (352) 797-6306 FAX (352) 797-6308 LB No. 5776

CADD FILE: MWELL	PROJ MAN: ADM	DRAWN BY: ADM	CHECKED BY: ---
PROJ. NO.: 22324	FB B64, PG 19	FIELD DATE: 08/08/03	SCALE: 1"=200'

SHEET  
**1**  
OF 1