
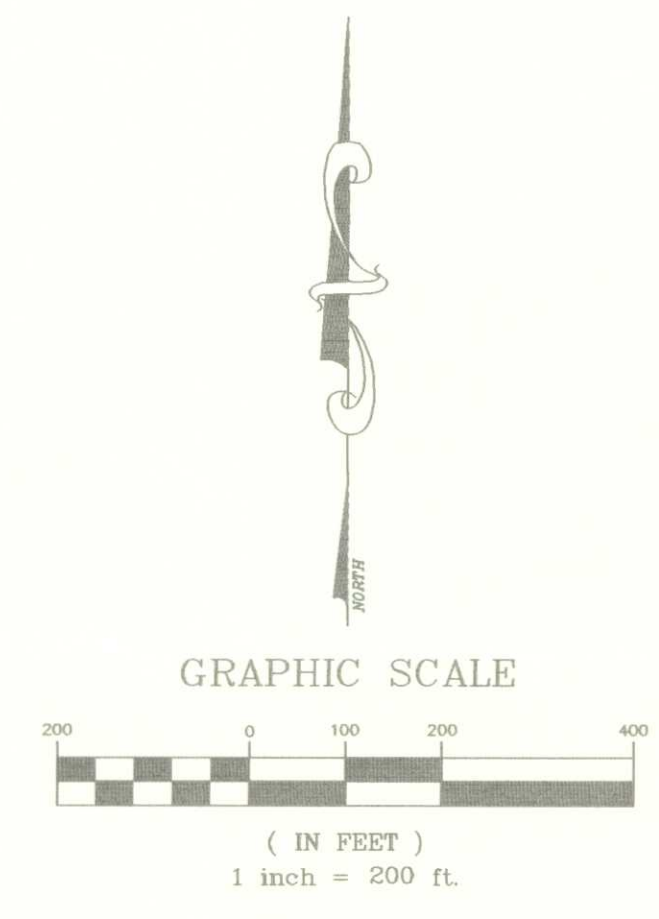


ENTERPRISE ROAD RECYCLING AND DISPOSAL FACILITY MONITORING WELL LOCATIONS

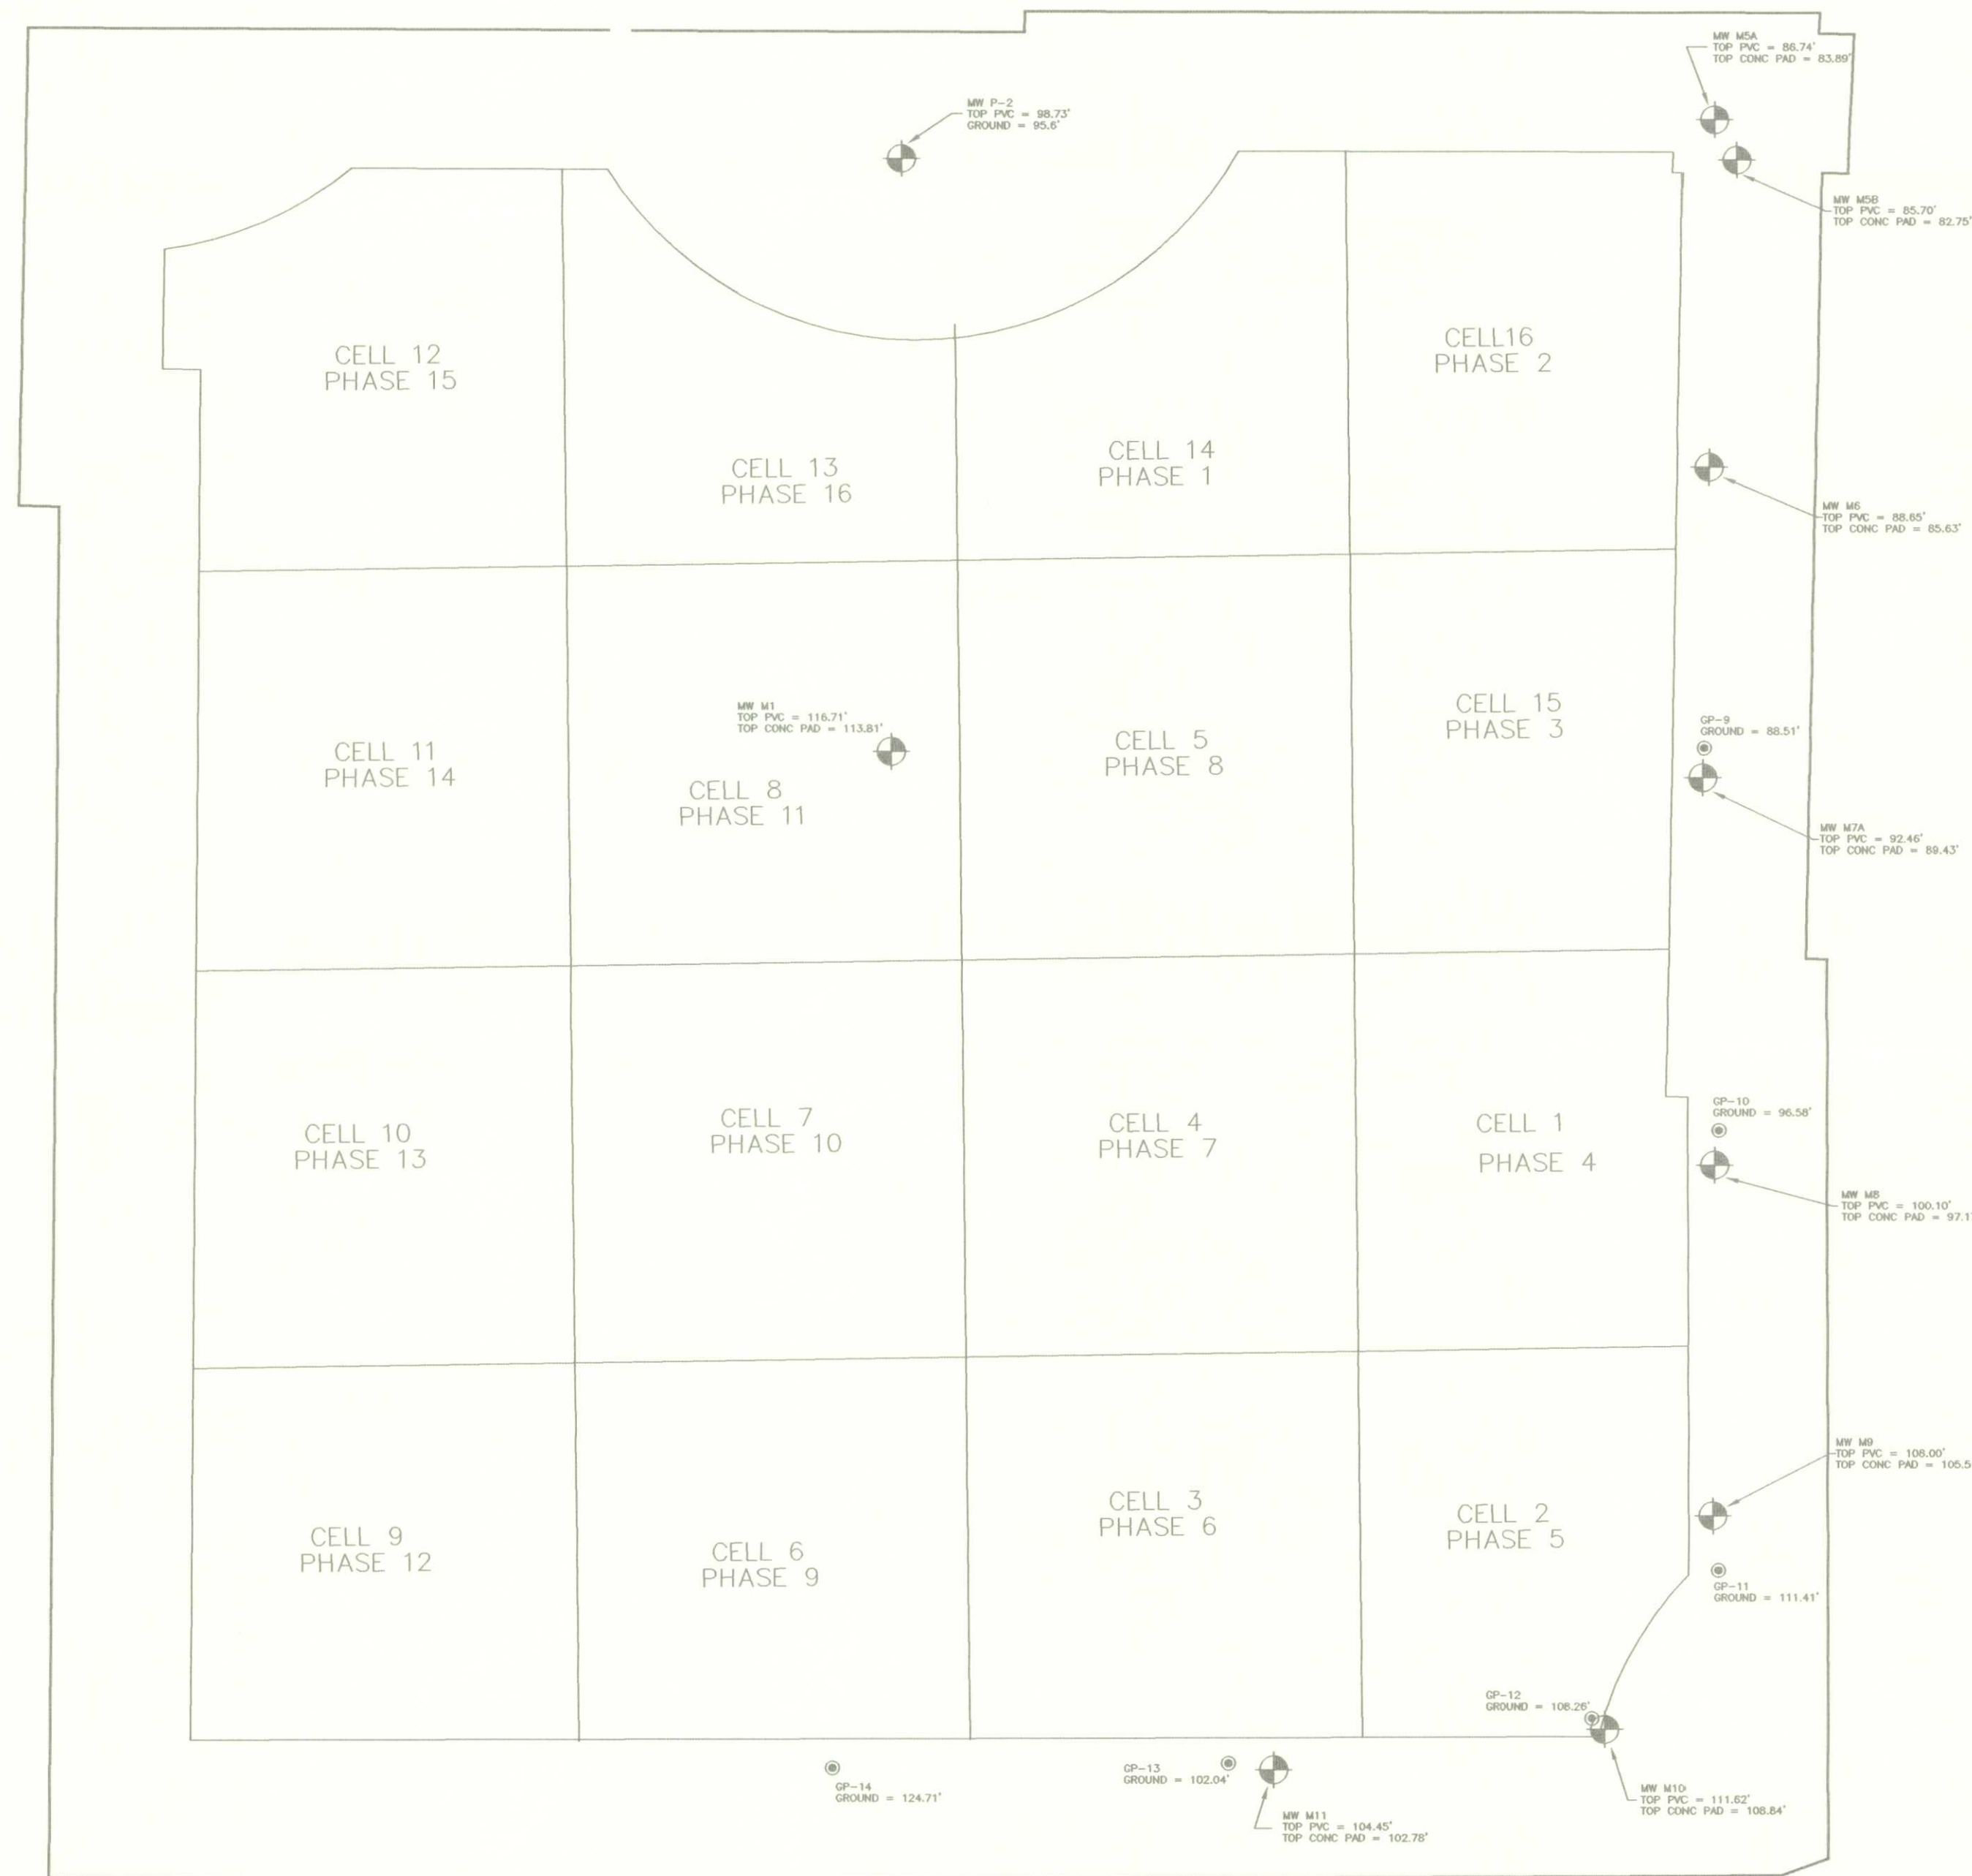

= MONITORING WELL LOCATION
 = GAS PROBE LOCATION

NOTES:

1. THIS DRAWING IS NOT INTENDED TO REPRESENT A BOUNDARY SURVEY.
2. ELEVATIONS SHOWN HEREON BASED ON BENCH MARKS OBTAINED FROM THE CONSTRUCTION PLANS FOR THE PROPOSED RECYCLING AND DISPOSAL AND ENTERPRISE ROAD.
3. THIS SURVEY DRAWING WAS PREPARED FOR THE EXCLUSIVE USE OF THE PARTY OR PARTIES CERTIFIED TO BELOW FOR THE EXPRESS PURPOSE STATED HEREON AND/OR CONTAINED IN THE CONTRACT BETWEEN FORESIGHT SURVEYORS, INC. AND THE CLIENT FOR THIS PROJECT. COPYING, DISTRIBUTING, AND/OR USING THIS DRAWING, IN WHOLE OR IN PART FOR ANY PURPOSE OTHER THAN ORIGINALLY INTENDED WITHOUT WRITTEN CONSENT FROM FORESIGHT SURVEYORS, INC. IS STRICTLY PROHIBITED, AND RENDERS THE SURVEYOR'S CERTIFICATION, SIGNATURE AND SEAL HEREON NULL AND VOID. ANY QUESTIONS CONCERNING THE CONTENT OR PURPOSE OF THIS DRAWING SHOULD BE DIRECTED TO FORESIGHT SURVEYORS, INC.

THE PROFESSIONAL SEAL OF
 DANIEL MILLER, P.S.M.
OCT 17 2008
 SURVEYOR
 FLORIDA

TITLE: SPECIFIC PURPOSE SURVEY FOR: HARTMAN AND ASSOCIATES, INC. DESC: SECTION 8, TOWNSHIP 25 SOUTH, RANGE 22 EAST	THIS SURVEY IS NOT VALID WITHOUT THE SIGNATURE AND ORIGINAL RAISED SEAL OF A FLORIDA LICENSED SURVEYOR AND MAPPER. A. DANIEL MILLER, P.S.M. FLORIDA SURVEYORS REGISTRATION NO. 5284	<table border="1" style="width: 100%; border-collapse: collapse;"> <thead> <tr> <th style="width: 5%;">NO.</th> <th style="width: 60%;">REVISION</th> <th style="width: 15%;">DATE</th> <th style="width: 20%;">BY</th> </tr> </thead> <tbody> <tr><td> </td><td> </td><td> </td><td> </td></tr> <tr><td> </td><td> </td><td> </td><td> </td></tr> <tr><td> </td><td> </td><td> </td><td> </td></tr> <tr><td> </td><td> </td><td> </td><td> </td></tr> <tr><td> </td><td> </td><td> </td><td> </td></tr> </tbody> </table>	NO.	REVISION	DATE	BY																					<table border="1" style="width: 100%; border-collapse: collapse;"> <tr> <td colspan="4" style="text-align: center;">FORESIGHT SURVEYORS, INC.</td> </tr> <tr> <td colspan="4" style="text-align: center;">HYDROGRAPHIC, LAND & CONSTRUCTION SURVEYING</td> </tr> <tr> <td colspan="4" style="text-align: center;">773 PROVIDENCE BOULEVARD, BROOKSVILLE, FLORIDA 34601</td> </tr> <tr> <td colspan="2" style="text-align: center;">PH. (352) 797-6306</td> <td colspan="2" style="text-align: center;">FAX (352) 797-6308</td> </tr> <tr> <td colspan="2" style="text-align: center;">CADD FILE: MWELL</td> <td colspan="2" style="text-align: center;">LB No.: 5776</td> </tr> <tr> <td style="text-align: center;">PROJ. NO.: 22324</td> <td style="text-align: center;">PROJ. MAN: ADM</td> <td style="text-align: center;">DRAWN BY: ADM</td> <td style="text-align: center;">CHECKED BY: _____</td> </tr> <tr> <td colspan="2" style="text-align: center;">FB B64, PG 19</td> <td colspan="2" style="text-align: center;">FIELD DATE: 08/08/03</td> </tr> <tr> <td colspan="4" style="text-align: center;">SCALE: 1"=200'</td> </tr> </table>	FORESIGHT SURVEYORS, INC.				HYDROGRAPHIC, LAND & CONSTRUCTION SURVEYING				773 PROVIDENCE BOULEVARD, BROOKSVILLE, FLORIDA 34601				PH. (352) 797-6306		FAX (352) 797-6308		CADD FILE: MWELL		LB No.: 5776		PROJ. NO.: 22324	PROJ. MAN: ADM	DRAWN BY: ADM	CHECKED BY: _____	FB B64, PG 19		FIELD DATE: 08/08/03		SCALE: 1"=200'				SHEET <b style="font-size: 2em;">1 OF 1
NO.	REVISION	DATE	BY	
FORESIGHT SURVEYORS, INC.	
HYDROGRAPHIC, LAND & CONSTRUCTION SURVEYING	
773 PROVIDENCE BOULEVARD, BROOKSVILLE, FLORIDA 34601	
PH. (352) 797-6306		FAX (352) 797-6308	
CADD FILE: MWELL		LB No.: 5776	
PROJ. NO.: 22324	PROJ. MAN: ADM	DRAWN BY: ADM	CHECKED BY: _____	
FB B64, PG 19		FIELD DATE: 08/08/03	
SCALE: 1"=200'	