


LEGEND:
 ▲ DEPTH OF COVER A MINIMUM OF 18 INCHES
 X₆" ACTUAL DEPTH OF COVER

file

D.E.P.
 FEB 28 1996
 SOUTHWEST DISTRICT
 TAMPA

F:\ENR\8883\HARDEE\DWG\COVER.DWG
 AutoCAD Release 12

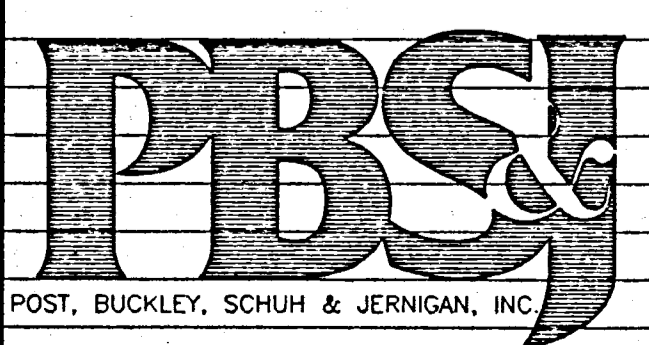

CLIENT	HARDEE COUNTY BOARD OF COUNTY COMMISSIONERS	PROJECT	HARDEE COUNTY LANDFILL	TASK	DEPTH OF COVER FIELD INVESTIGATION	ORIGINAL	DEC. 1995	6			JOB NO. 07-862.15
						REVISIONS:		7			DRAWN MM
						1		8			DESIGN MM
						2		9			CHECKED_EH
						3		10			Q.C. SBL
						4		11			SHEET 3
						5		12			

RECEIVED
FEB 28 1996
Department of Environmental Protection
BY SOUTHWEST DISTRICT