


PIZO #	NORTHING	EASTING	TOP OF PIZO	GROUND
PIZO 1	1453517.8	611903.4	171.73	169.6
PIZO 2	1454672.8	612910.0	96.83	95.6
PIZO 3	1454533.6	613660.7	78.94	77.8
PIZO 3A	1454535.2	613666.3	78.40	77.7
PIZO 3B	1454535.5	613650.1	79.65	78.5
PIZO 4	1454738.3	614108.6	84.55	83.3
PIZO 5	1453482.0	613510.9	94.56	93.3
PIZO 6	1453624.7	614073.9	94.16	92.9
PIZO 7	1452317.4	613512.3	102.81	101.1
PIZO 8	1452370.4	612666.9	133.94	132.7
BORING #2	1453531.8	612671.3		136.9
BORING #4	1454335.3	613401.4		98.1
WELL	1454646.7	613414.1		

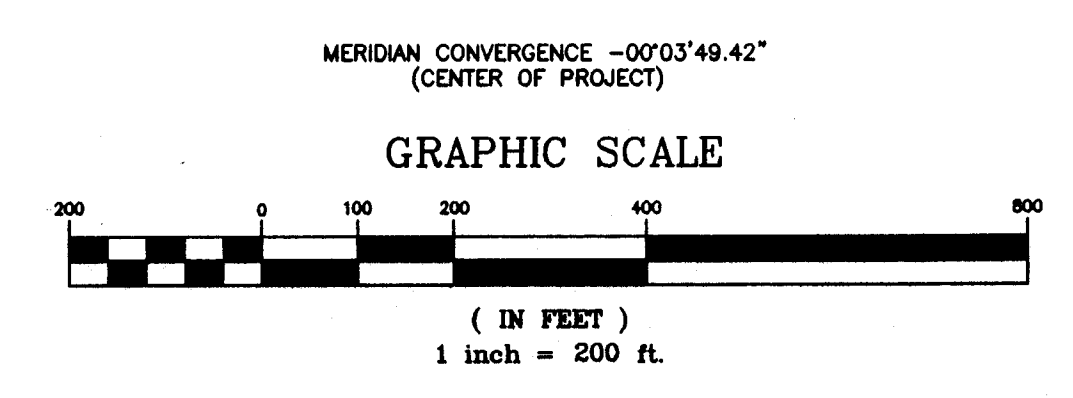

**DESCRIPTION:**

A PORTION OF LAND LYING IN THE SOUTH 1/2 OF THE SOUTHWEST 1/4 AND THE NORTHEAST 1/4 OF THE SOUTHWEST 1/4 OF SECTION 5 AND A PORTION OF LAND LYING IN THE NORTH 1/2 OF THE NORTHWEST 1/4 OF SECTION 8, ALL IN TOWNSHIP 25 SOUTH, RANGE 22 EAST, PASCO COUNTY, FLORIDA, BEING MORE PARTICULARLY DESCRIBED AS FOLLOWS:

COMMENCE AT THE SOUTHWEST CORNER OF SECTION 5, TOWNSHIP 25 SOUTH, RANGE 22 EAST; THENCE RUN N.01°03'55"E ALONG THE WEST LINE OF THE SOUTH 1/2 OF THE SOUTHWEST 1/4 OF SAID SECTION 5 FOR A DISTANCE OF 638.10 FEET TO THE POINT OF BEGINNING; THENCE CONTINUE N.01°03'55"E, ALONG SAID WEST LINE FOR A DISTANCE OF 686.67 FEET THE NORTHWEST CORNER OF THE SOUTH 1/2 OF THE SOUTHWEST 1/4 OF SAID SECTION 5; THENCE RUN S.89°48'14"E, ALONG THE NORTH LINE OF SAID SOUTH 1/2 FOR A DISTANCE OF 1421.75 FEET TO A POINT LYING 100.00 EAST OF AND PARALLEL TO THE EAST LINE OF THE NORTHWEST 1/4 OF THE SOUTHWEST 1/4 OF SAID SECTION 5; THENCE RUN S.89°48'14"E, PARALLEL TO SAID EAST LINE FOR A DISTANCE OF 30.00 FEET; THENCE RUN S.89°48'14"E, PARALLEL TO AFORESAID SOUTH LINE OF THE SOUTH 1/2 FOR A DISTANCE OF 1133.87 FEET TO A POINT ON A LINE LYING 50.00 WEST OF AND PARALLEL TO THE WEST RIGHT-OF-WAY LINE OF AUTON ROAD AS DESCRIBED IN THE OFFICIAL RECORDS BOOK 1613, PAGE 288; THENCE RUN S.02°23'10"W, ALONG SAID LINE FOR A DISTANCE OF 30.02 FEET TO A POINT ON AFORESAID NORTH LINE OF THE SOUTH 1/2; THENCE RUN S.89°48'14"E, ALONG SAID NORTH LINE A DISTANCE OF 50.04 FEET TO A POINT ON THE AFORESAID WEST RIGHT-OF-WAY LINE OF AUTON ROAD; THENCE RUN S.02°21'53"W, ALONG SAID WEST RIGHT-OF-WAY LINE FOR A DISTANCE OF 200.14 FEET; THENCE RUN N.89°48'14"W, FOR A DISTANCE OF 37.06 FEET TO A POINT ON THE NORTH LINE OF THE NORTHWEST 1/4 OF SECTION 8, TOWNSHIP 25 SOUTH, RANGE 22 EAST; THENCE RUN S.01°05'27"W, ALONG SAID WEST RIGHT-OF-WAY LINE FOR A DISTANCE OF 1125.77 FEET; THENCE RUN S.00°13'37"E, A DISTANCE OF 0.29 FEET TO A POINT ON THE NORTH LINE OF THE NORTHWEST 1/4 OF SECTION 8, TOWNSHIP 25 SOUTH, RANGE 22 EAST; THENCE RUN S.89°48'30"E, ALONG SAID LINE FOR A DISTANCE OF 30.00 FEET TO A POINT ON THE WEST RIGHT-OF-WAY LINE OF AUTON ROAD AS DESCRIBED IN THE OFFICIAL RECORDS BOOK 3143, PAGE 1590; THENCE RUN S.01°05'27"W, ALONG SAID WEST RIGHT-OF-WAY LINE FOR A DISTANCE OF 1230.88 FEET TO A POINT ON THE NORTH LINE OF THE MAINTAINED RIGHT-OF-WAY OF ENTERPRISE ROAD (NOT DEDICATED); THENCE RUN ALONG SAID MAINTAINED RIGHT-OF-WAY LINE THE FOLLOWING COURSES AND DISTANCES: S.70°10'03"W, FOR A DISTANCE OF 70.91 FEET; THENCE RUN S.89°44'13"W, FOR A DISTANCE OF 1983.66 FEET; THENCE RUN N.89°28'13"W, FOR A DISTANCE OF 490.84 FEET TO A POINT LYING 50.11 FEET EAST OF THE WEST LINE OF AFORESAID NORTH 1/2 OF THE NORTHWEST 1/4; THENCE RUN N.02°21'12"E, FOR A DISTANCE OF 1329.45 FEET TO A POINT ON AFORESAID NORTH LINE OF THE NORTH 1/2 OF THE NORTHWEST 1/4 OF SECTION 8, SAID POINT BEING S.89°48'30"E AND A DISTANCE OF 65.00 FEET FROM AFORESAID SOUTHWEST CORNER OF SECTION 5; THENCE RUN N.00°20'48"E, FOR A DISTANCE OF 637.20 FEET; THENCE RUN N.88°56'05"W, FOR A DISTANCE OF 57.00 FEET TO THE POINT OF BEGINNING.

PARCEL CONTAINS 155.1142 ACRES, MORE OR LESS.

- NOTES:**
- 1) THE BEARINGS & COORDINATES SHOWN HEREON ARE BASED ON FLORIDA STATE PLANE GRID, WEST ZONE, NORTH AMERICAN DATUM 1983, COORDINATE SYSTEM.
  - 2) ELEVATIONS SHOWN HEREON ARE BASED PASCO COUNTY DATUM (NAVD 29).
  - 3) DIMENSIONS OF DESCRIPTION AND SURVEY WERE ADJUSTED FROM STATE PLANE GRID, HAVING A PROJECT SCALE FACTOR OF 0.999943315.
  - 4) THERE MAY BE EASEMENTS AND RESTRICTIONS OF RECORDS AND/OR PRIVATE AGREEMENTS NOT FURNISHED TO THIS SURVEYOR THAT MAY AFFECT PROPERTY RIGHTS AND/OR LAND USE RIGHTS OF THE LANDS SHOWN HEREON.
  - 5) NO UNDERGROUND INSTALLATIONS, FOUNDATION FOOTINGS OR IMPROVEMENTS HAVE BEEN LOCATED EXCEPT AS NOTED.
  - 6) THIS SURVEY WAS PERFORMED IN ACCORDANCE WITH THE MINIMUM TECHNICAL STANDARDS FOR SURVEYS AS SET FORTH BY THE FLORIDA BOARD OF PROFESSIONAL SURVEYORS AND MAPPERS, CHAPTER 61-017, FLORIDA ADMINISTRATIVE CODE.

**BOUNDARY SURVEY OF THE PASCO COUNTY LAND FILL FOR SID LARKIN & SON, INC.**

**HARTMAN & ASSOCIATES, INC.**  
 engineers, hydrogeologists, surveyors & management consultants  
 201 EAST WINE STREET - SUITE 1000 - ORLANDO, FL 32801  
 TELEPHONE (407) 538-3000 - FAX (407) 538-0300  
 LICENSED BUSINESS NO. 98814

**REVISIONS**

Rev. _____	Date: _____
Rev. _____	Date: _____
Rev. _____	Date: _____
Rev. ADDED PIZO	Date: 3/31/2000

NOT VALID WITHOUT THE SIGNATURE AND THE ORIGINAL RAISED SEAL OF A FLORIDA LICENSED SURVEYOR AND MAPPER.

Job No:	99-231.00
Cadd File:	BOUNDARY
Field Date:	11/1/99
Drawn By:	LEJ
Field By:	DCR
Field Bk/Pg:	

Professional Surveyor and Mapper  
 Florida Registration #5364