


# ANGELO'S RECYCLED MATERIALS

## ENTERPRISE ROAD FACILITIES 1577684 (1)


SECTION 8 TOWNSHIP 25 SOUTH RANGE 22 EAST  
PASCO COUNTY, FLORIDA

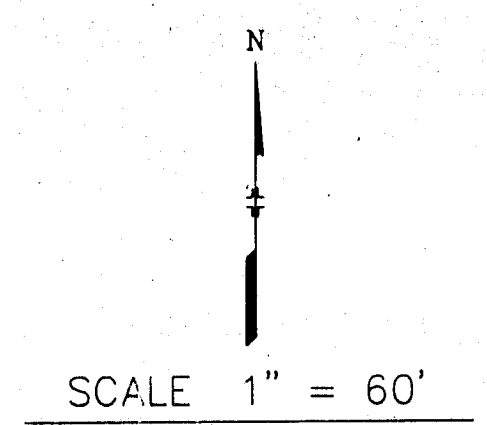

THE ELEVATIONS SHOWN HEREON ARE BASED ON THE NATIONAL GEODETIC VERTICAL DATUM OF 1929 AND REFERENCED TO U.S.G.S. BENCHMARK # Q-56, SAID BENCHMARK BEING LOCATED ON THE NORTH SIDE OF JORDAN ROAD AND THE WEST RIGHT-OF-WAY LINE OF THE CSX RAILROAD APPROXIMATELY TWO MILES NORTH OF DADE CITY, FLORIDA.

THE SITE BENCHMARK IS LOCATED ON THE NORTH SIDE OF ENTERPRISE ROAD APPROXIMATELY 75 FEET WEST OF THE ENTRANCE TO ANGELO'S RECYCLED MATERIALS LAND FILL, BEING A 5/8" IRON ROD AND CAP NO. LB6382 IN THE CENTER OF AN AERIAL PANEL WITH AN ELEVATION OF 148.94 FEET.

I HEREBY CERTIFY THAT THE INFORMATION CONTAINED ON THIS PUBLICATION WAS OBTAINED UNDER MY DIRECTION ON MARCH 11, 2009 AND IS A TRUE REPRESENTATION OF THE GROUND ELEVATIONS EXISTING ON SAID DATE.

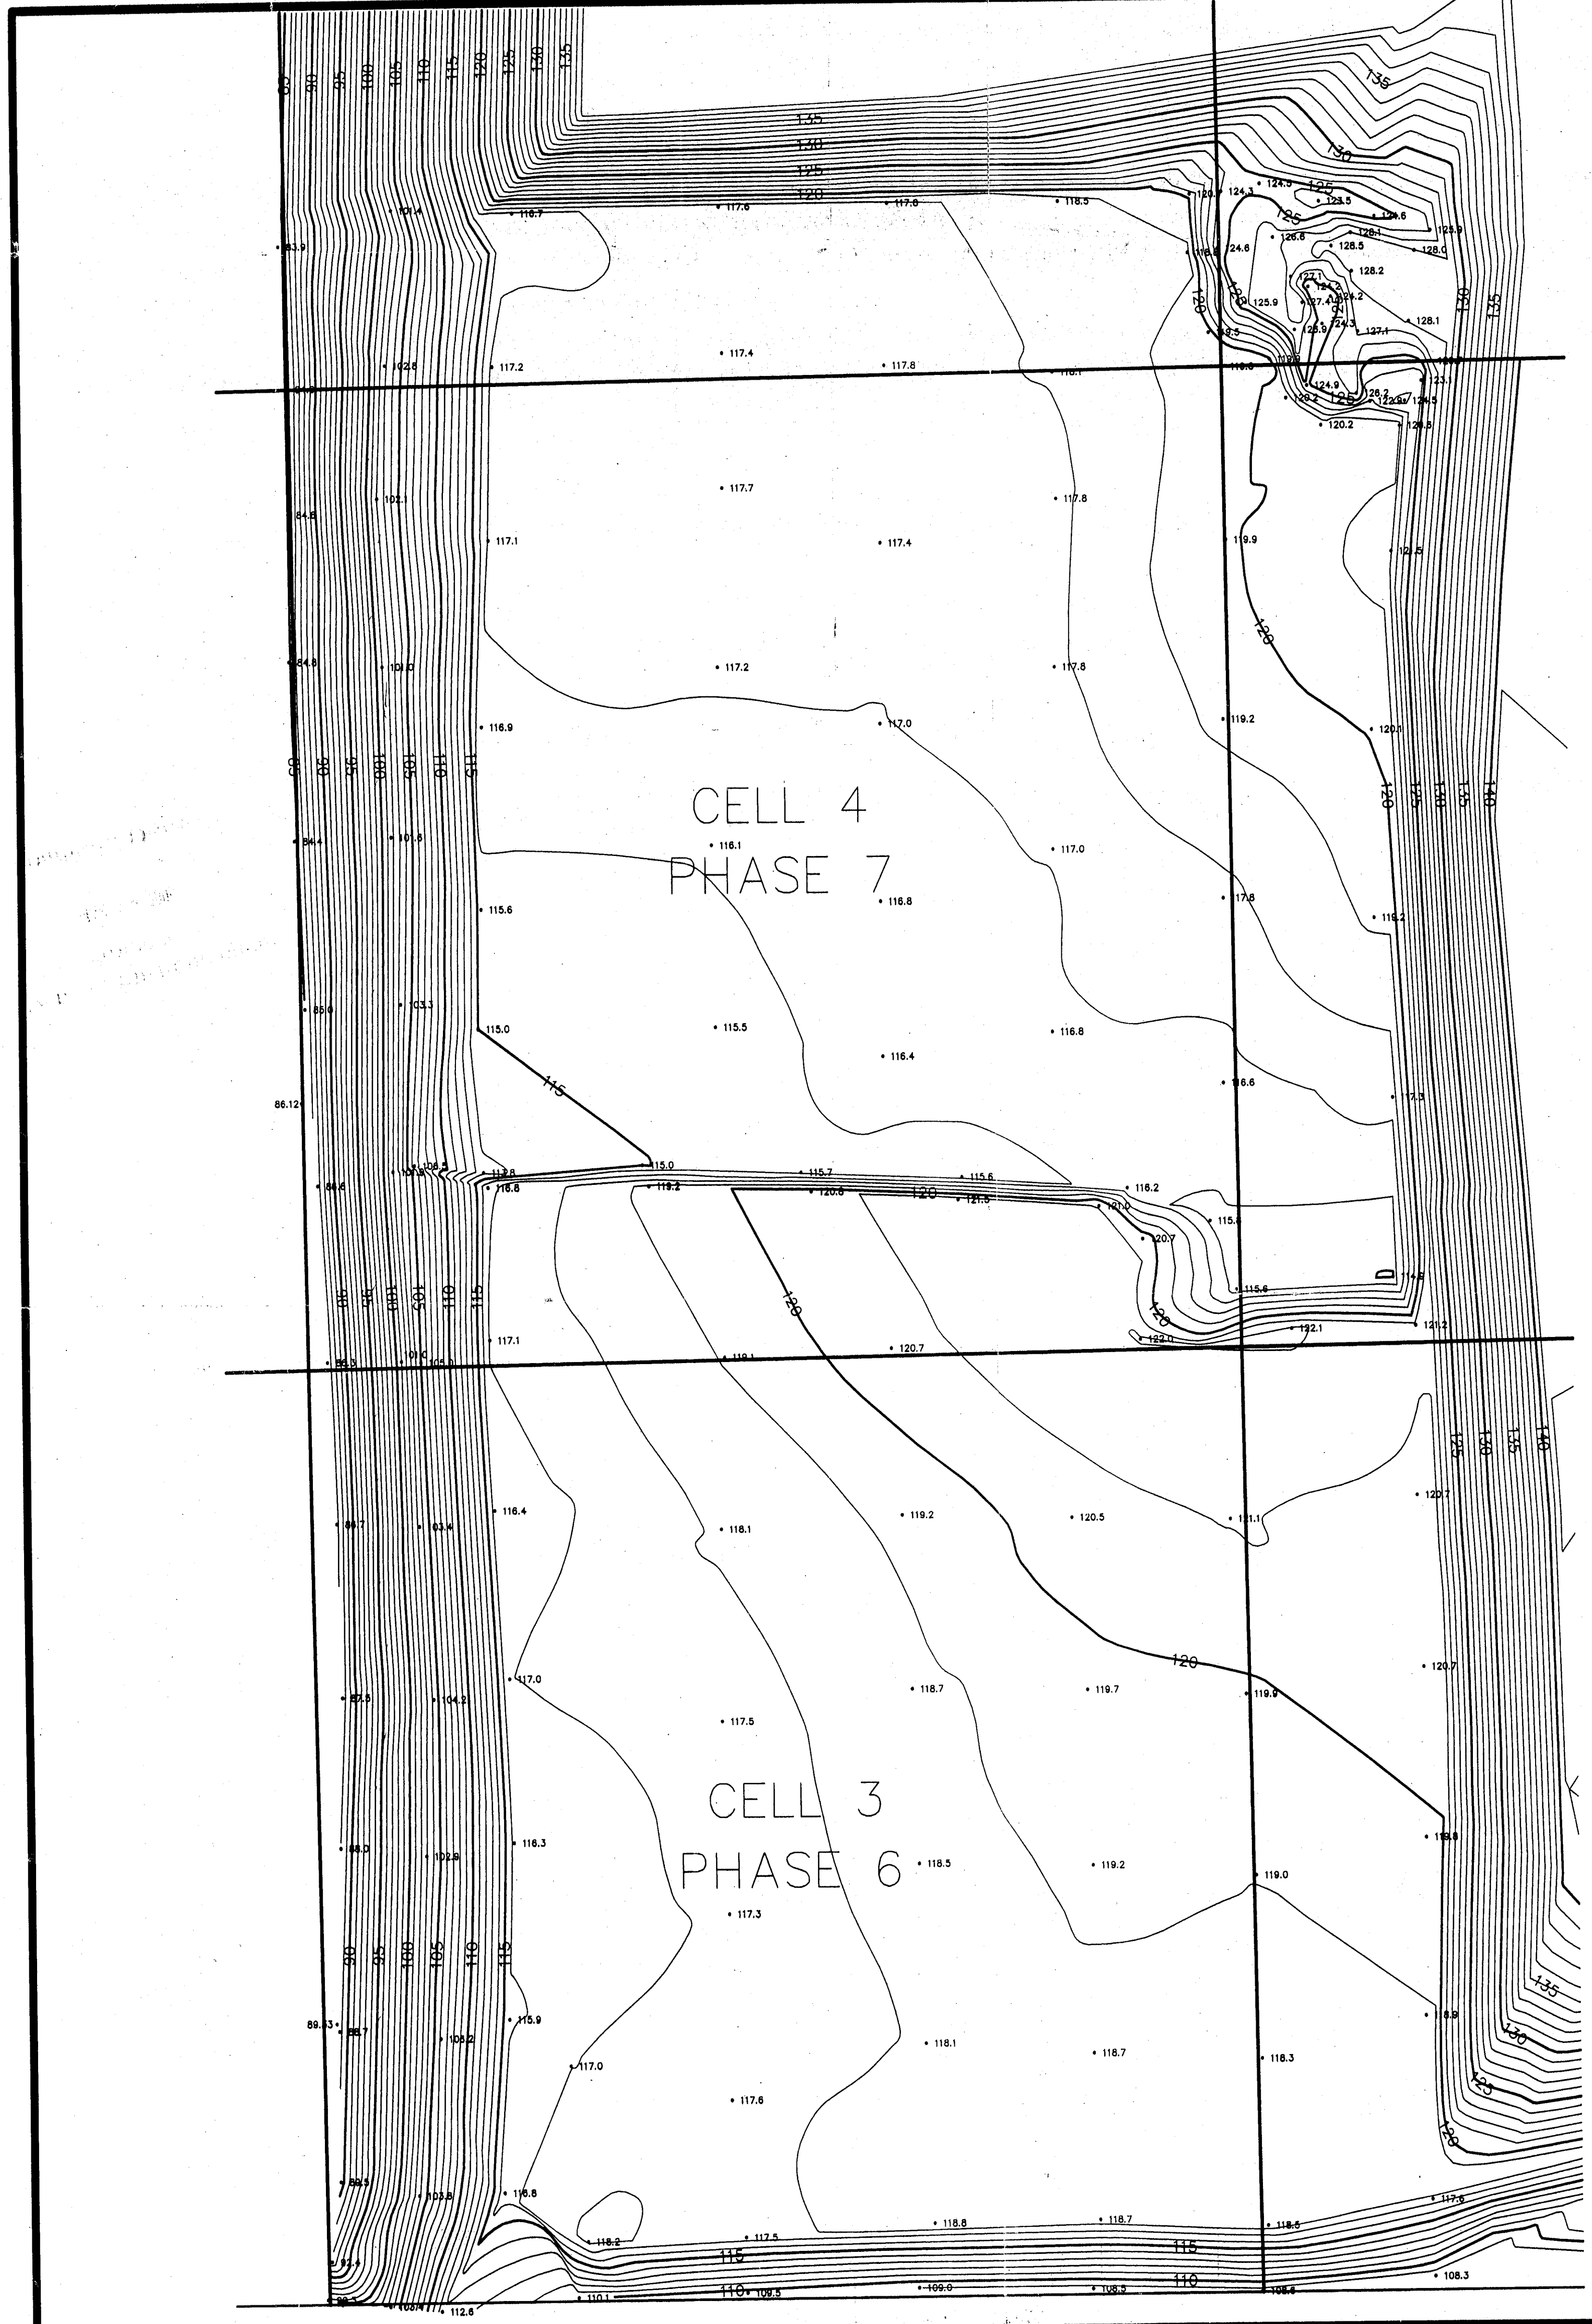

FLORIDA DEPARTMENT OF ENVIRONMENTAL PROTECTION  
MAR 19 2009  
SOUTHWEST DISTRICT  
TAMPA

PREPARED BY: [Signature]  
NOT VALID UNLESS IMPRINTED WITH THIS SEAL

| GENERAL LEGEND |                                |
|----------------|--------------------------------|
| (D)            | - Deed or Description          |
| CM             | - Concrete Monument            |
| P.B.           | - Point of Beginning           |
| P.C.P.         | - Permanent Control Point      |
| P.R.M.         | - Permanent Reference Monument |
| R/W            | - Right of Way                 |
| R.R.S.         | - Railroad Spike               |
| N&D            | - Nail and Disk                |
| (C)            | - Computed Data                |
| P.C.           | - Point of Curvature           |
| P.T.           | - Point of Tangency            |
| IP             | - Iron Pipe                    |
| IP             | - Iron Pipe (F) - Field Data   |
| P              | - Plat (R) - Iron Rod          |
| FD             | - Found (C) - Center Line      |
| S              | - Set (R) - Radial             |
|                | (NR) - Non Radial              |
| REVISIONS      |                                |
|                |                                |
|                |                                |
|                |                                |

**SIMMONS & BEALL, INC.**  
SURVEYING & MAPPING

P.O. BOX 1297  
12218 HWY 301 S  
DADE CITY, FLORIDA 33526  
(352) 567-0049  
FAX (352) 567-0875  
LB NUMBER 6382

Date of Survey: 03-10-09 Drawn by: JLH  
Date of Plat: 03-11-09 Checked by: BWS  
Job Number: 06087-CELL 4&3 Sheet: ONE OF ONE

CERTIFIED TO: ANGELO'S RECYCLED MATERIALS