
NORTH

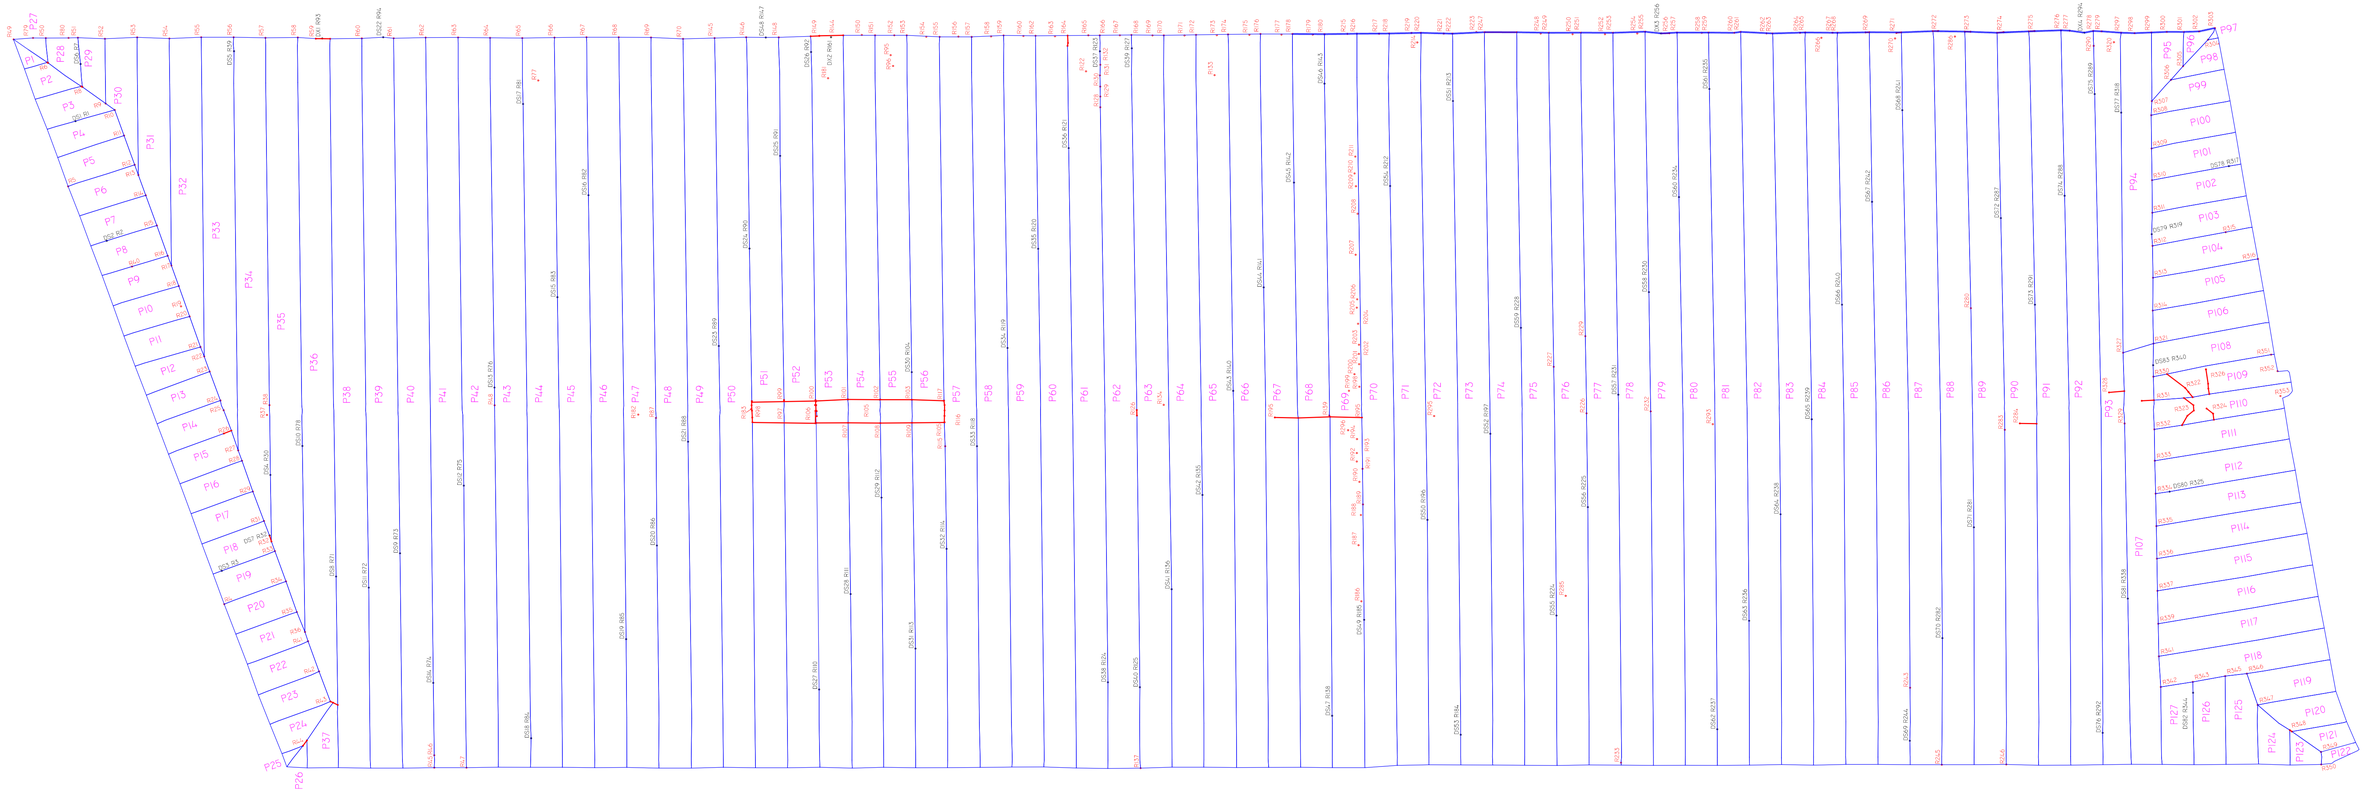

Allan Brantley, Florida P.E. #68030
Certifying Engineer-of-Record

ALLAN S. BRANTLEY
LICENSE
No 68030
STATE OF
FLORIDA
PROFESSIONAL ENGINEER

FIGURE 6

LEGEND			
P	PANEL NUMBER	—	CAP
R	REPAIR NUMBER	○	PATCH
DT	DESTRUCTIVE TEST NUMBER	○	DESTRUCTIVE TEST
		—	EXTRUSION WELD

CELL 13 CONSTRUCTION
SECONDARY
AS BUILT

J.E.D. SOLID WASTE MANAGMENT FACILITY
OMNI WASTE OF OSCEOL;S COUNTY, LLA
ST. CLOUD, FLORIDA

COMANCO®
ENVIRONMENTAL CORPORATION
4301 STERLING COMMERCE DR.
PLANT CITY, FL 33566-7372
TELEPHONE: (813) 988-8829
FAX: (813) 496-7305

DRAWN BY:	WDS	CHKD. BY:	TK
DATE:	5-27-16	APPRVD. BY:	TK
PLOT SCALE:	1"=50'	FILE NAME:	J.E.D. LANDFILL
PROJECT NO.:	03157700	CELL	13

DWG. NO: 1